

PARENT PARCEL: 06-23-002-101-003


CHILD PARCEL: 06-23-002-101-005, 06-23-004-101-003

STARTING POINT: CENTERLINE OF MURRAY RIDGE RD & O.L. 4

11-02403-X



DROP FROM DUP: 06-23-002-101-004

ADD TO DUP: 06-23-004-101-003

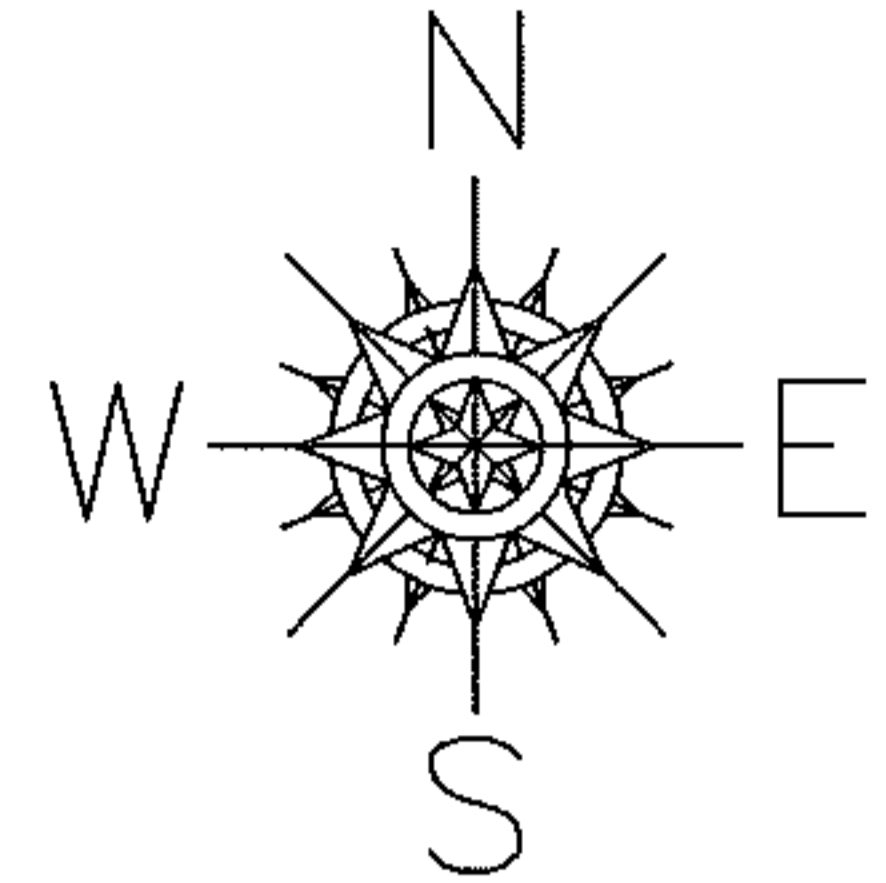

~~-003~~
26.73 A.
~~-005~~
25.73 A.

-003
1.00 A.

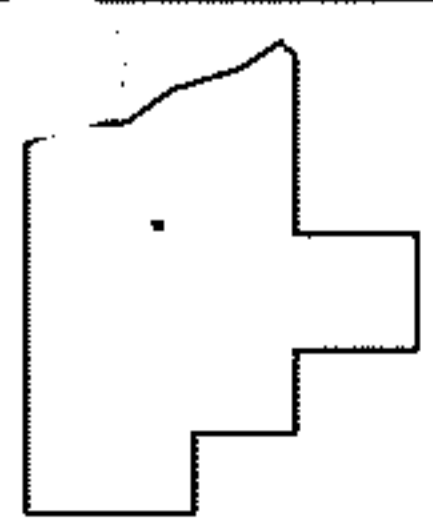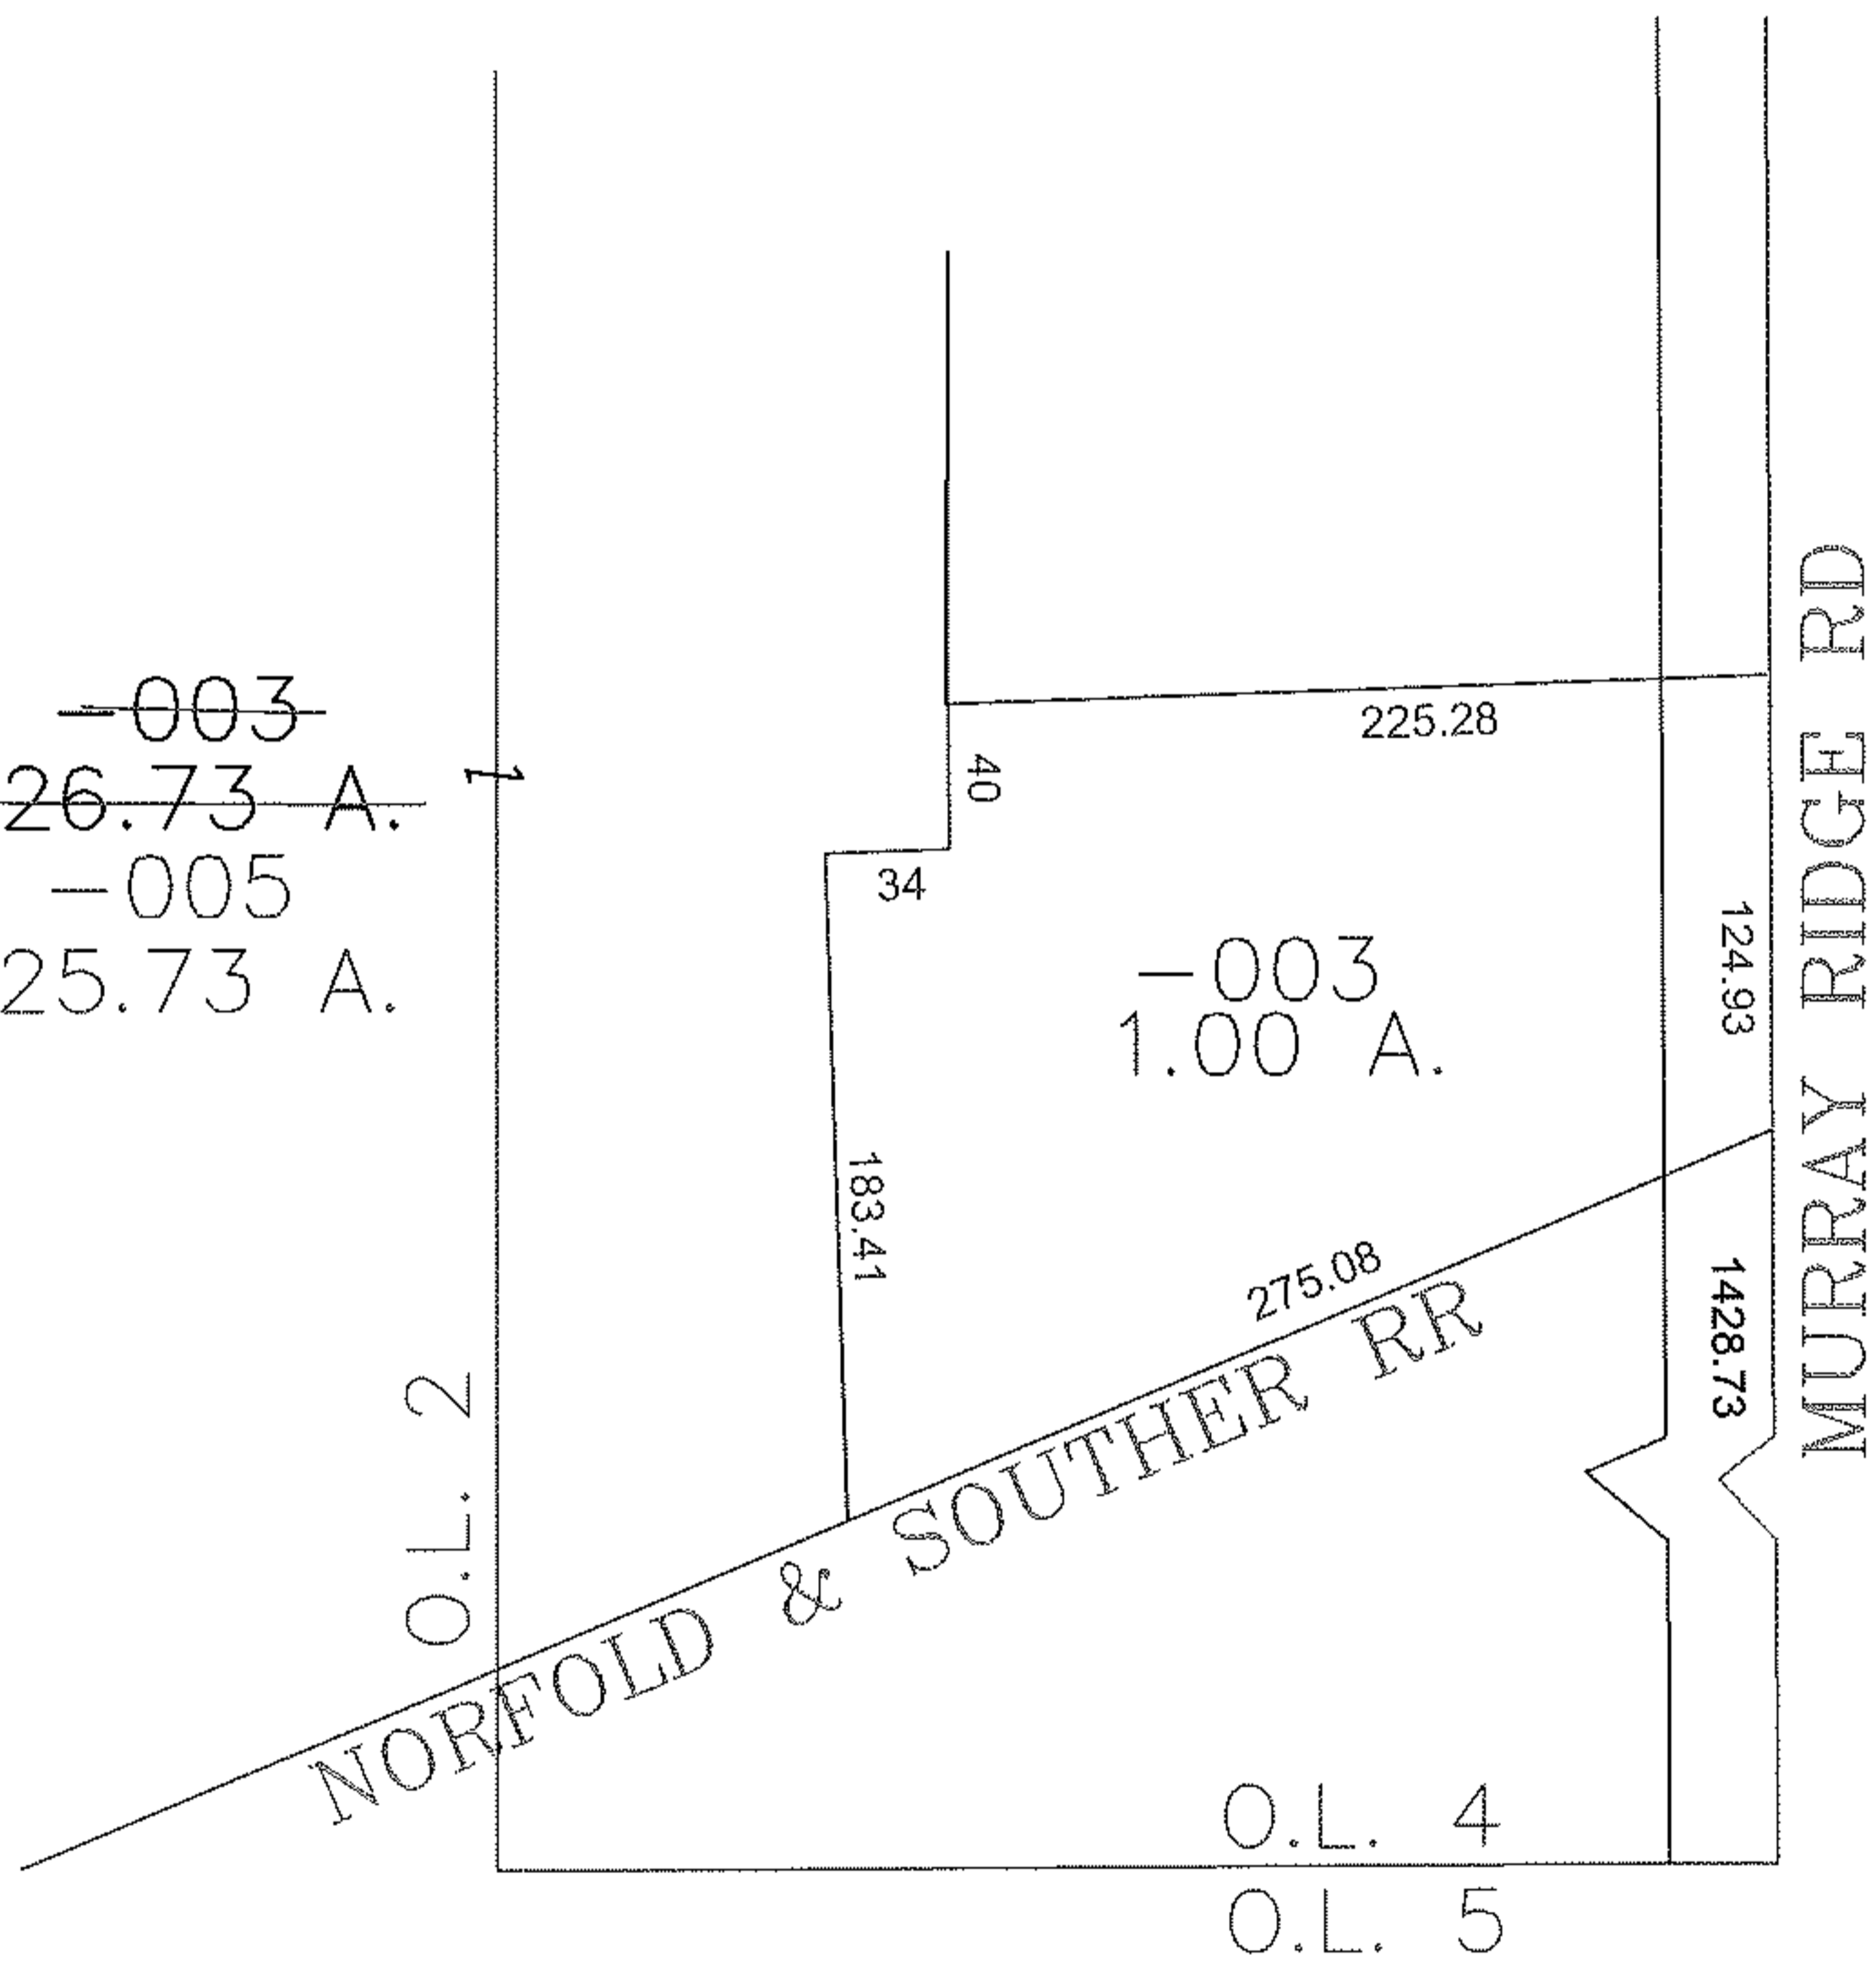

SPLITS/DEEDS PROCESSED

LORAIN COUNTY TAX MAP DEPARTMENT
226 MIDDLE AVE. ELYRIA, OHIO

SURVEYED BY: THOMAS SIMON
CLOSURE: 0.00 : 10.000
MAP PAGE(S): 6-21, 6-22
APPROVED BY: JAH DATE: 9-12-2011
SCALE: 1" = 100 PRIOR INSTRUMENT: DV 1418/234