



RASTER

PARENT PARCEL: 03-00-029-101-046

CHILD PARCEL: _____

STARTING POINT: PART OF S/L 25 & 26 IN BLOCK E OF KNICKERBOCKER SUB. NO.2 (VOL.12 PG.16)

11-02404-C

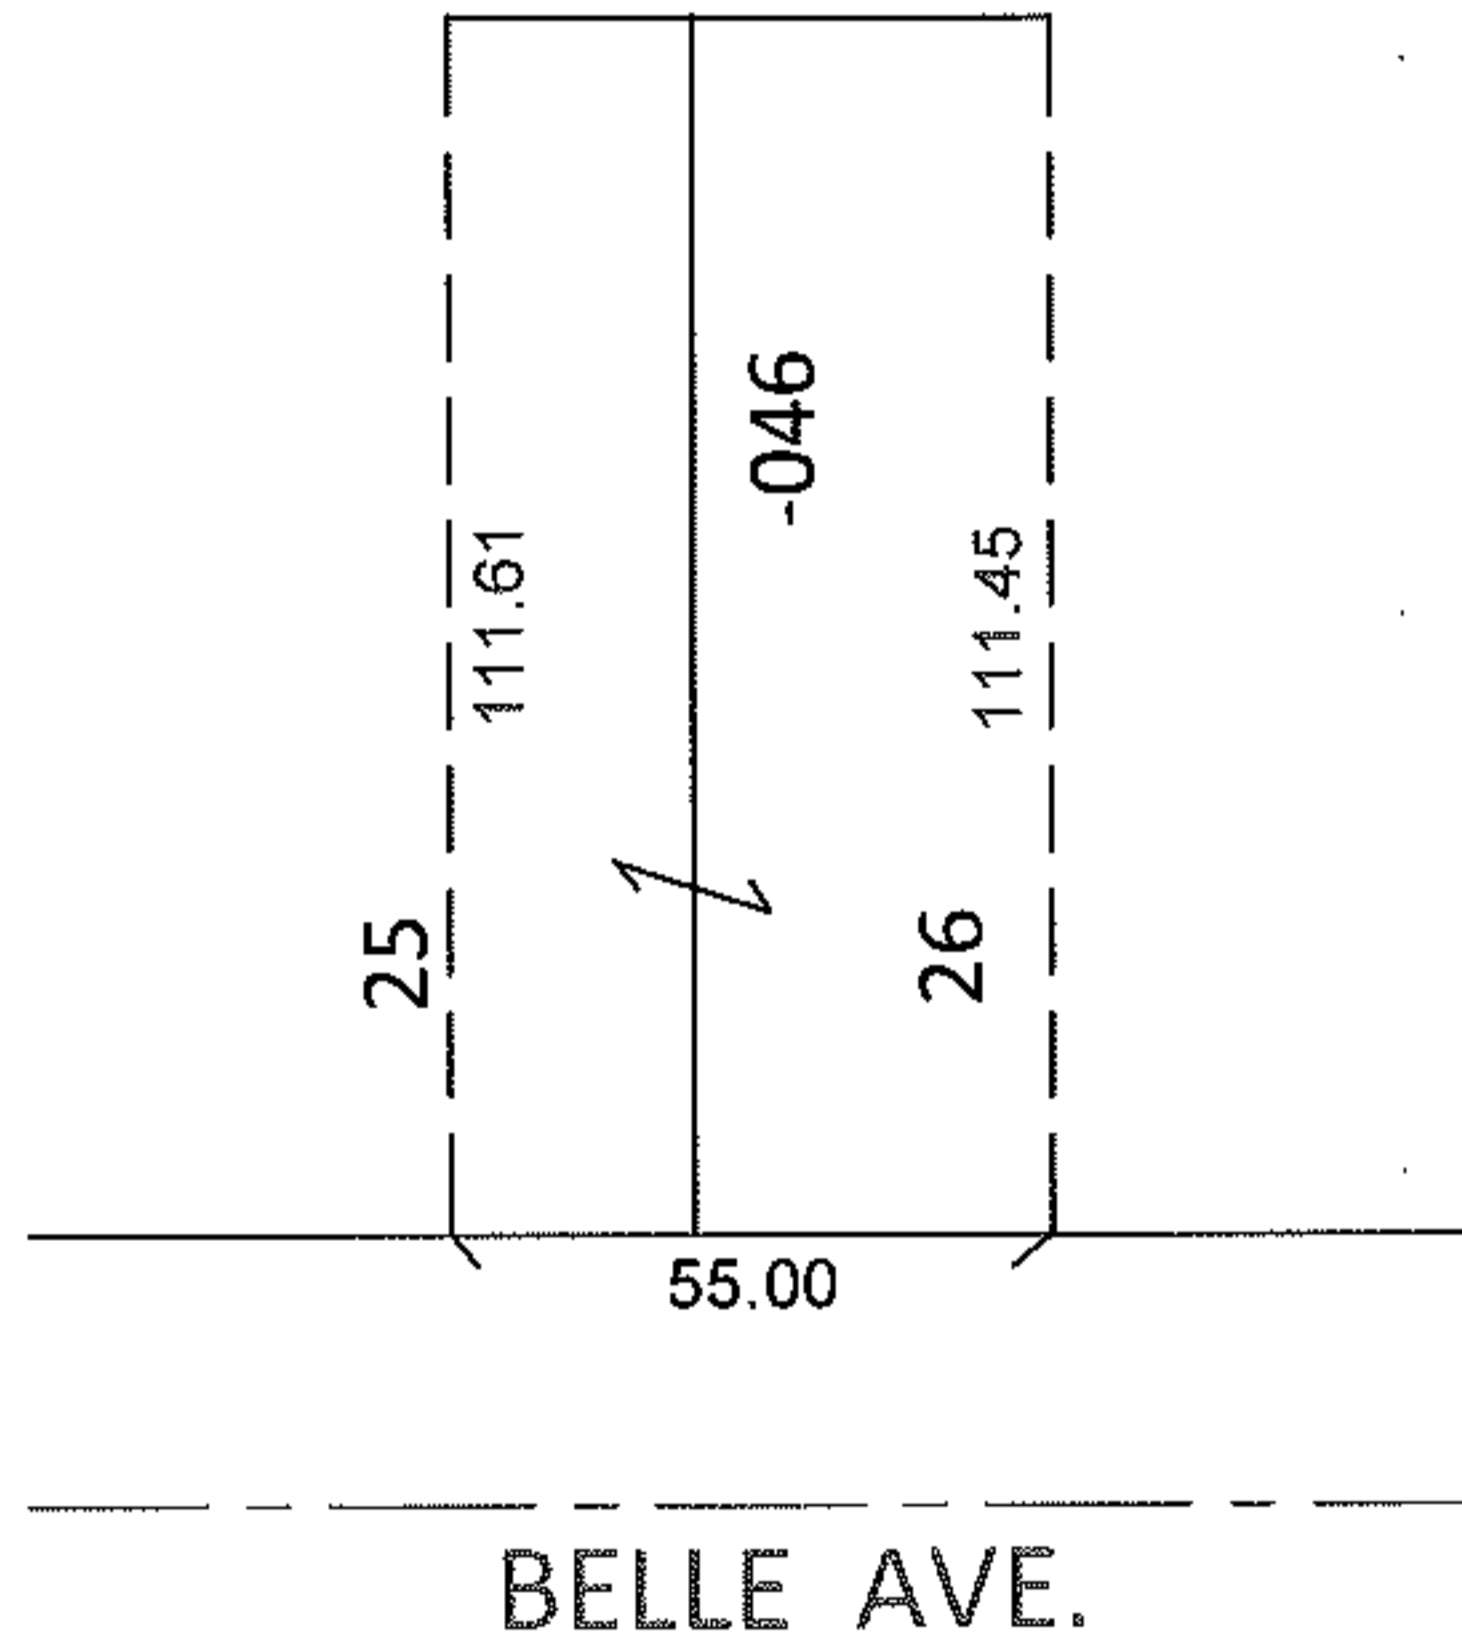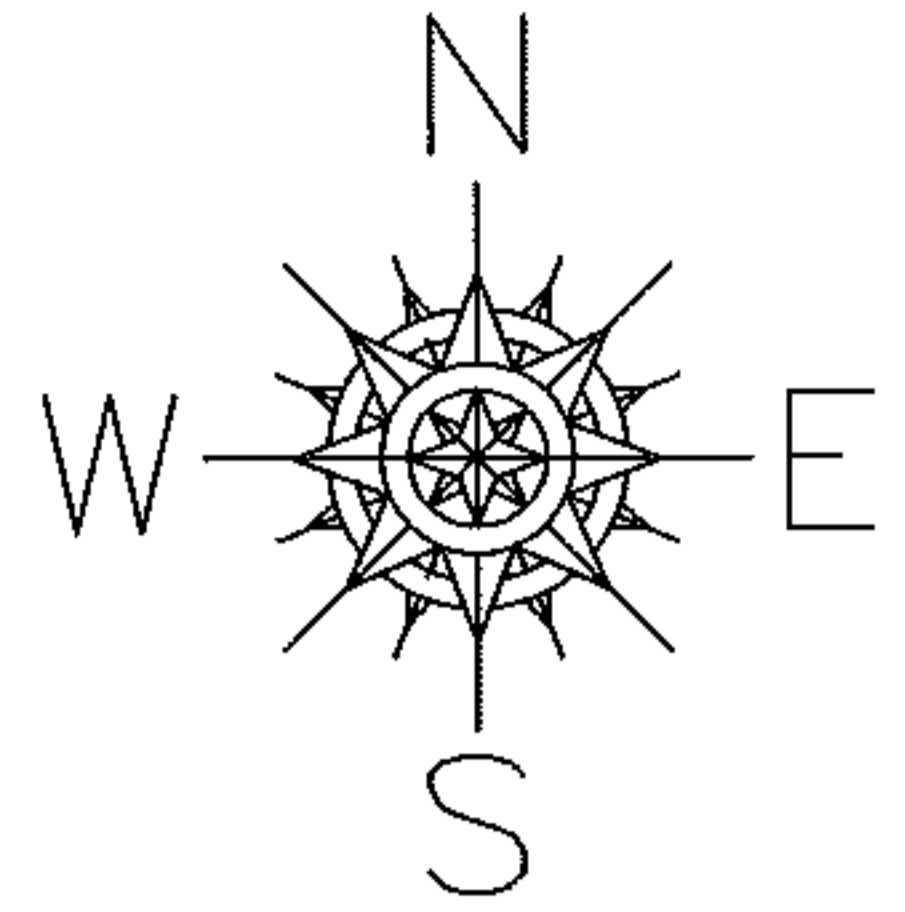


DEPTH CORRECTION

03-00-029-101-046

111.61

55 X ~~112~~

PER PRIOR DEEDS

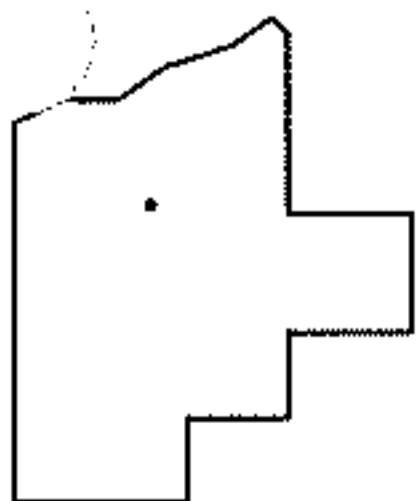

SPLITS/DEEDS PROCESSED

LORAIN COUNTY TAX MAP DEPARTMENT
226 MIDDLE AVE. ELYRIA, OHIO

SURVEYED BY: N/A

CLOSURE: N/A

MAP PAGE(S): 3-00-029-A

APPROVED BY: RRM DATE: 12-9-11

SCALE: 1" = 50' PRIOR INST.: 20070231520