



RASTER

07-02404

PARENT PARCEL: 07-00-032-000-026

CHILD PARCEL: 07-00-032-000-453, 454

STARTING POINT: CENTERLINE OF BARRES RD & STONEY RIDGE RD

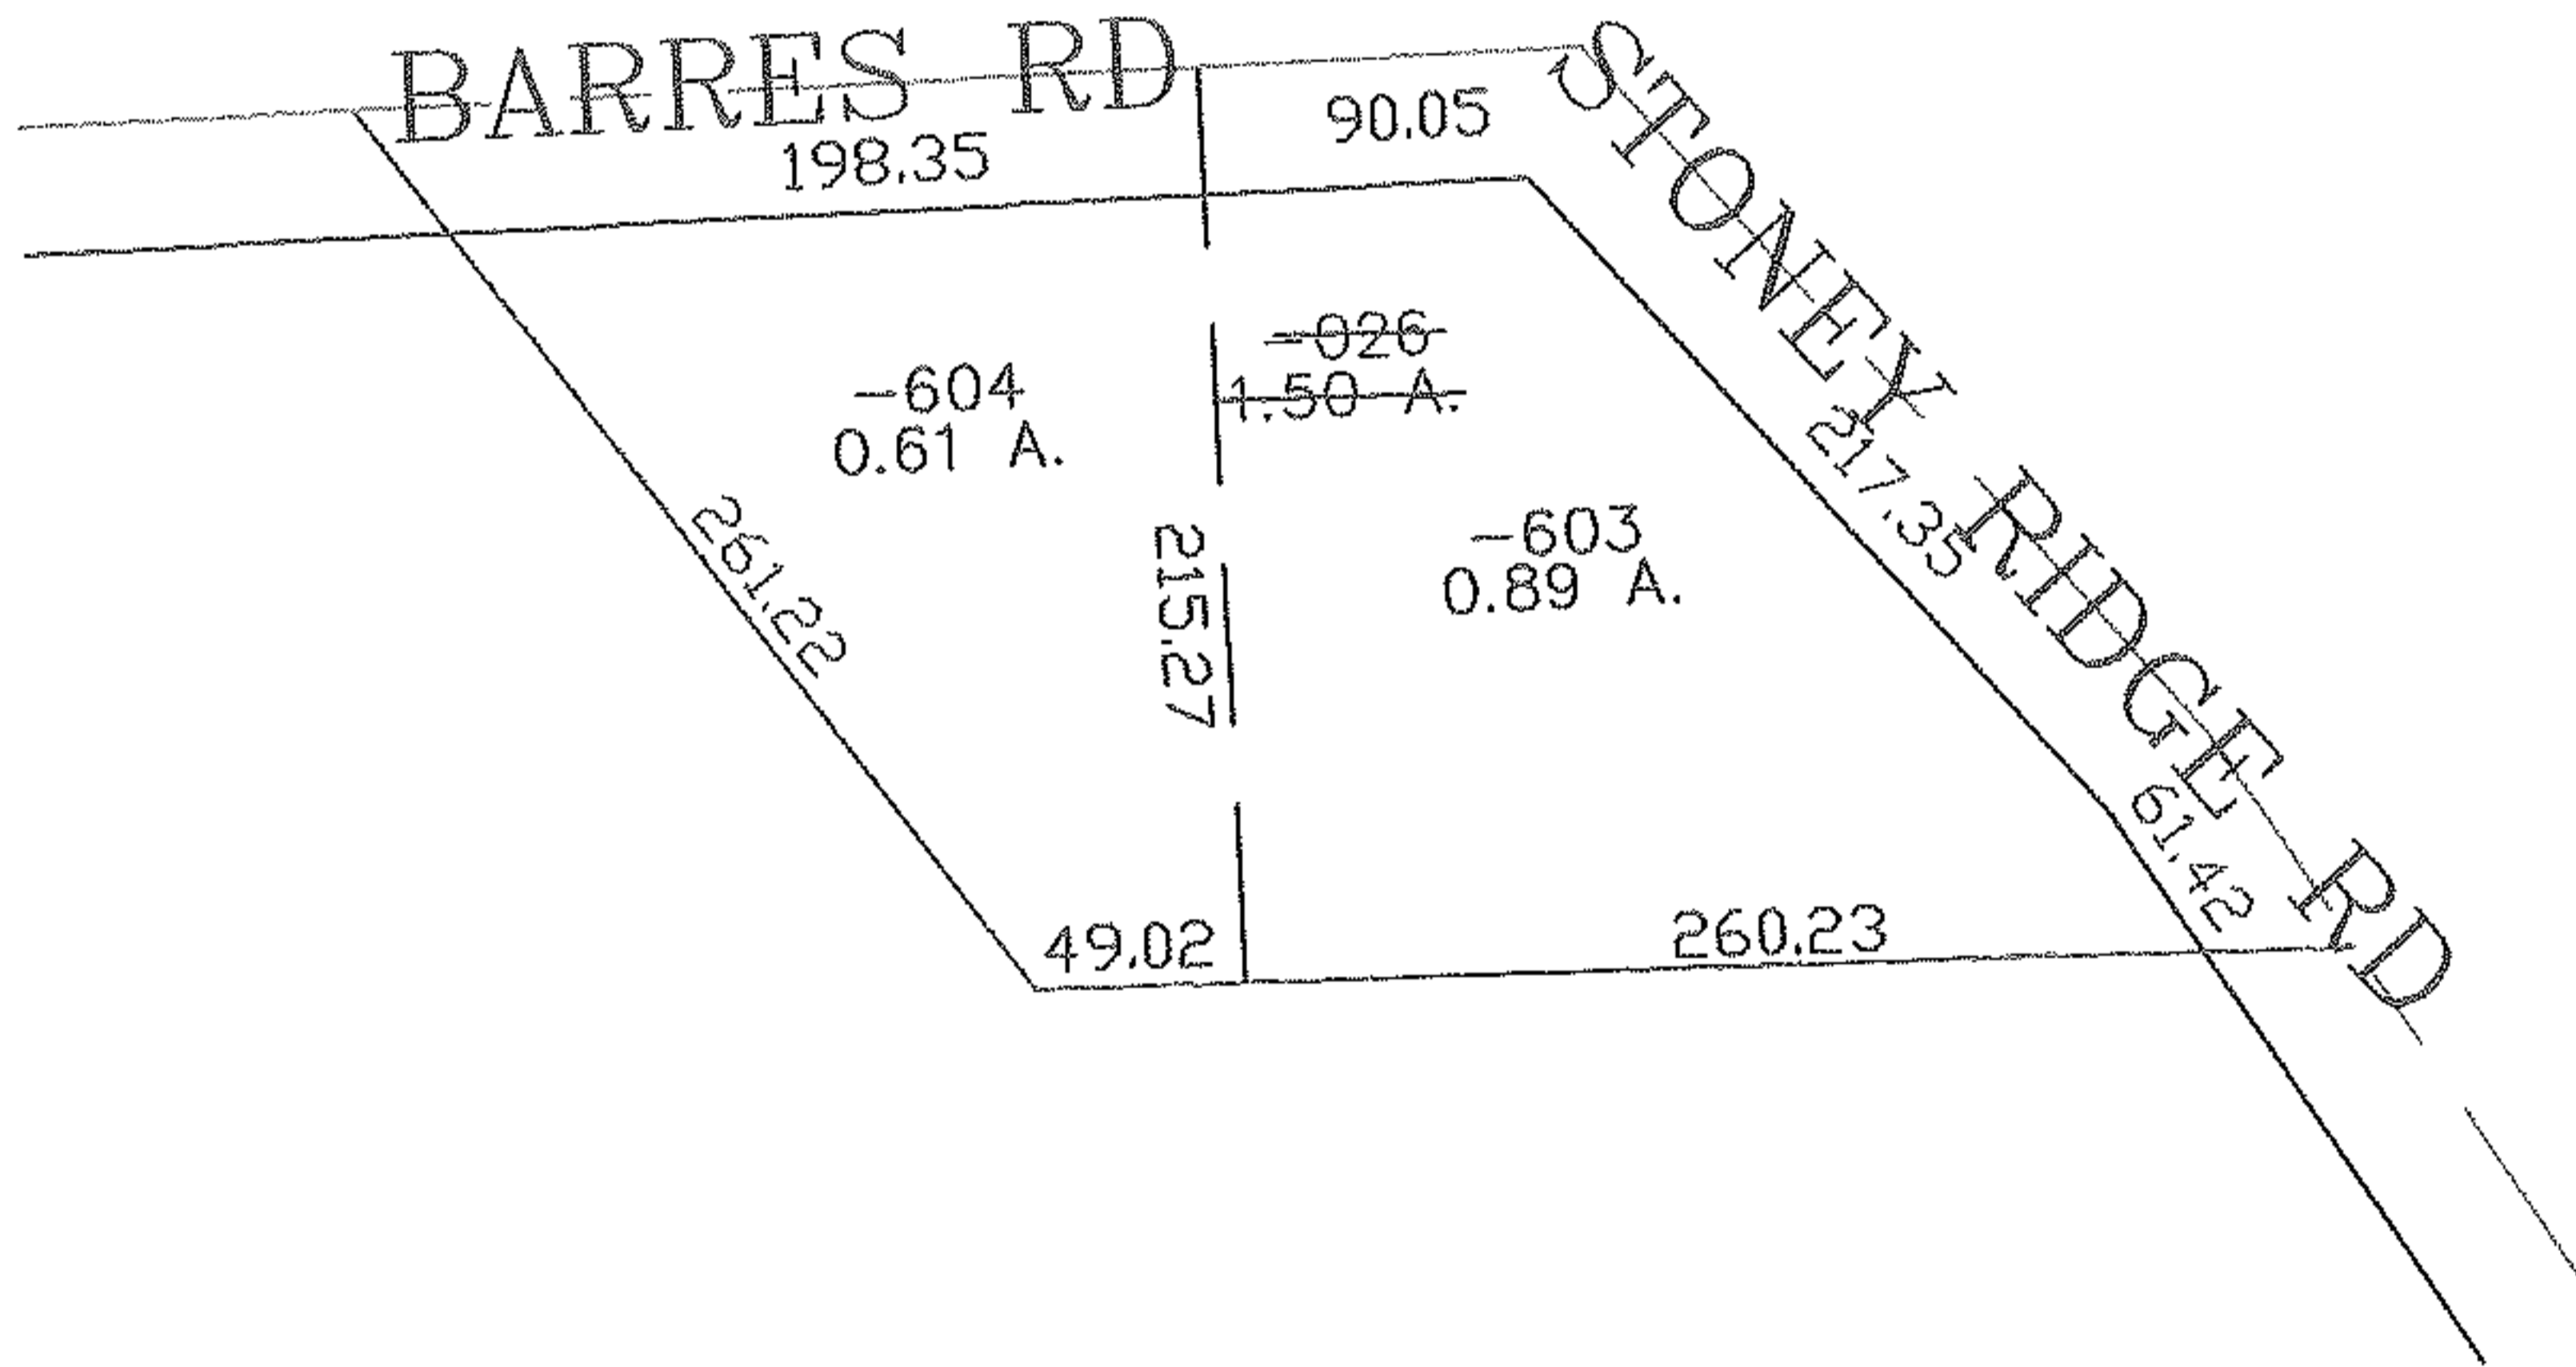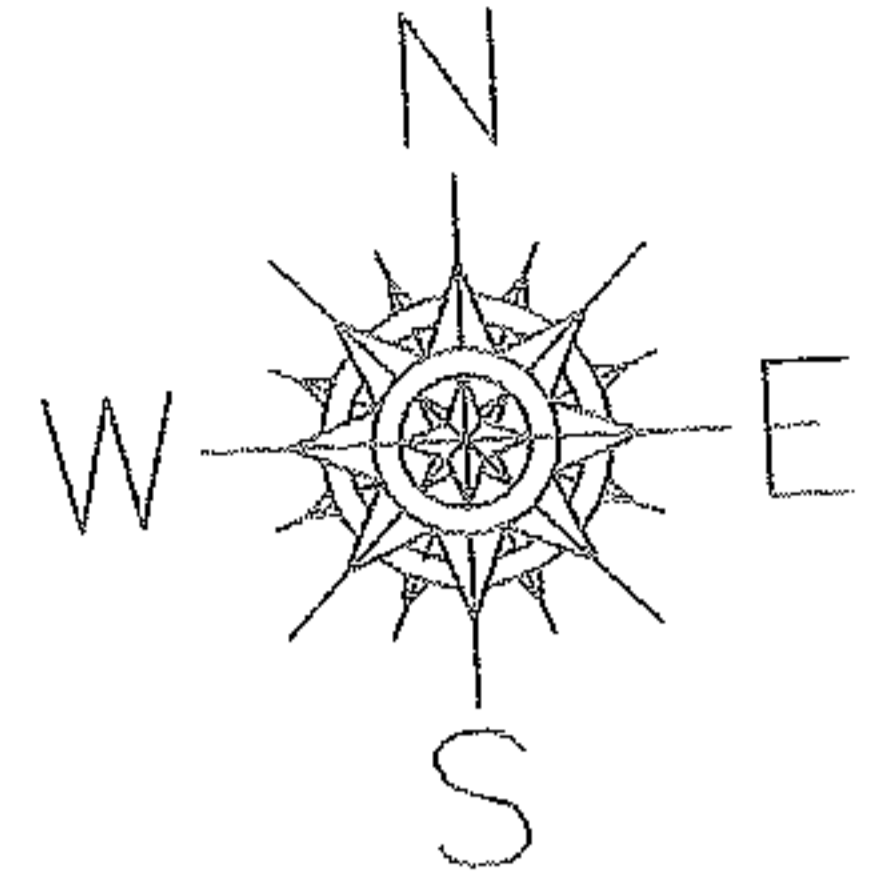

SPLITS/DEEDS PROCESSED

LORAIN COUNTY TAX MAP DEPARTMENT
226 MIDDLE AVE. ELYRIA, OHIO

SURVEYED BY: CHRISTOPHER HIRZEL

CLOSURE: 0.00 : 10.000

MAP PAGE(S): 07-00-032-B

APPROVED BY: JAH DATE: 6-20-07

SCALE: 1" = 100 PRIOR INSTRUMENT: 20040024921