


PARENT PARCEL: 13-10-019-000-003

CHILD PARCEL: 13-10-019-000-006, -007

STARTING POINT: CENTERLINE OF BAIRD RD & O.L. 19

07-02409

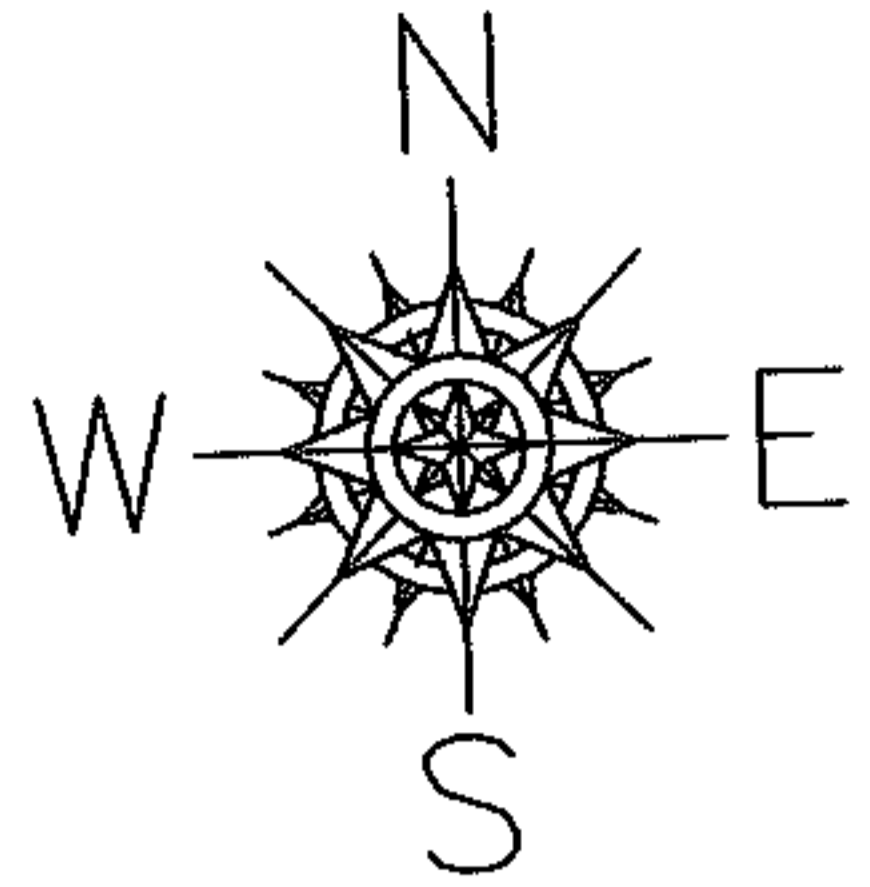

BAIRD RD  
492.88

290.40

-006  
3.21 A.

470.26

~~-003~~  
~~35.91 A.~~

-007  
32.70 A.

291.28

O.L. 19

O.L. 30

SPLITS/DEEDS PROCESSED

LORAIN COUNTY TAX MAP DEPARTMENT  
226 MIDDLE AVE. ELYRIA, OHIO

SURVEYED BY: RICHARD CARLSON

CLOSURE: 0.00 : 10.000

MAP PAGE(S): 13-B

APPROVED BY: JAH DATE: 6-25-07

SCALE: 1" = 100 PRIOR INSTRUMENT: 2005010111