


PARENT PARCEL: 06-24-025-105-018


CHILD PARCEL: _____

11-02410-C

STARTING POINT: 7.98 FEET EAST FROM THE SOUTHEAST CORNER OF S/L 37 IN OAKWOOD PARK SUB. NO.2(VOL.18 PG.34)

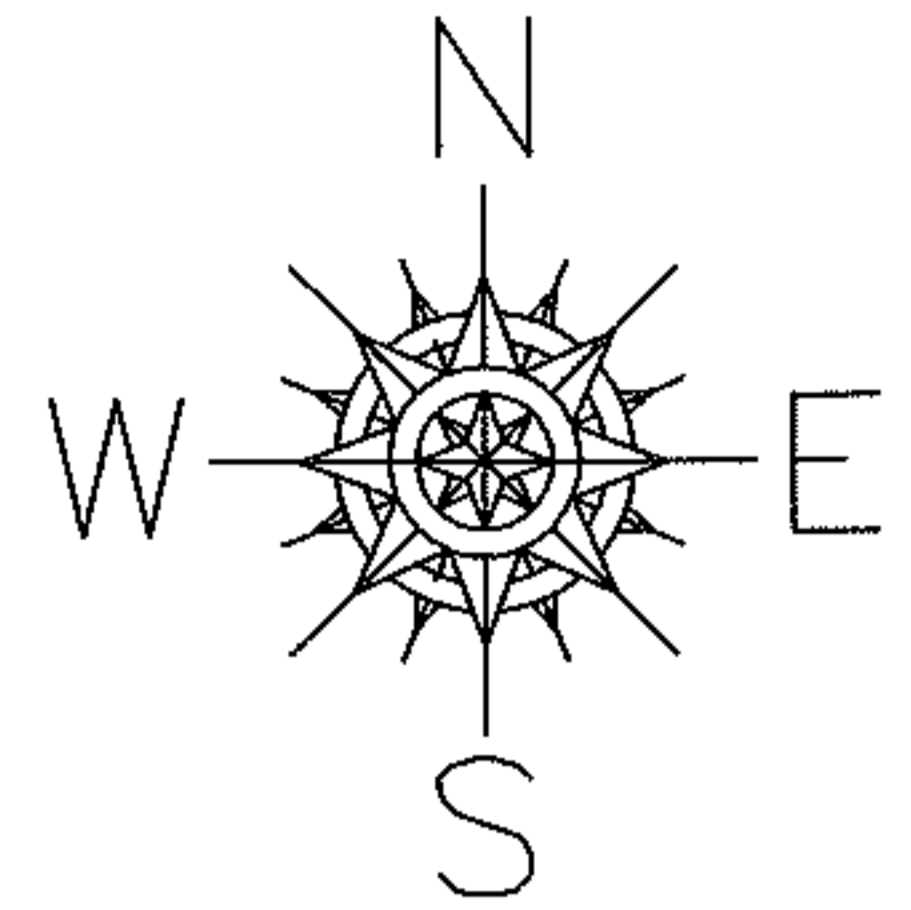

OAKWOOD DR.

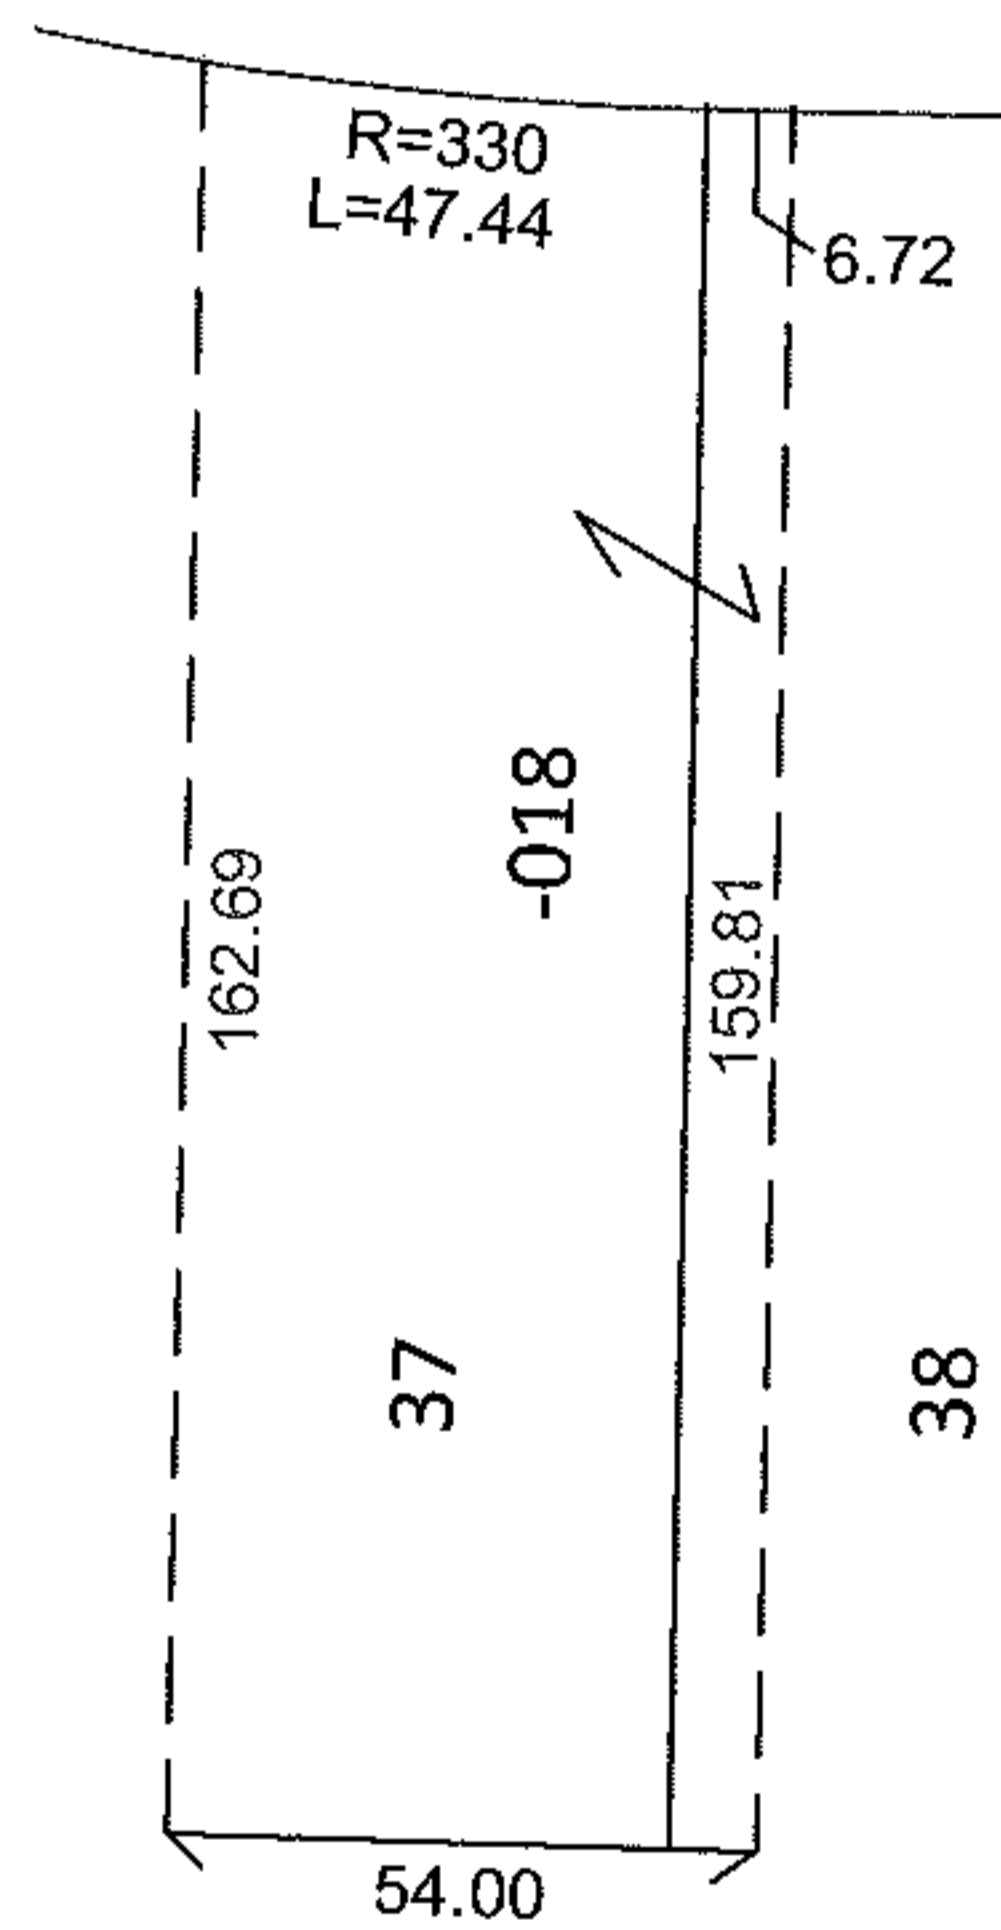


FRONTAGE AND DEPTH CORRECTION

06-24-025-105-018

54.16 X 162.69

~~54 X 165~~

PER PRIOR DEEDS

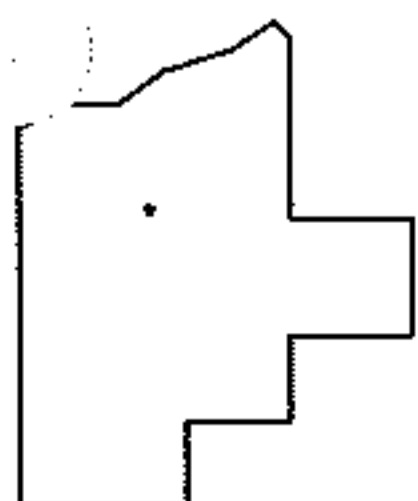

SPLITS/DEEDS PROCESSED

LORAIN COUNTY TAX MAP DEPARTMENT
226 MIDDLE AVE. ELYRIA, OHIO

SURVEYED BY: N/A

CLOSURE: N/A

MAP PAGE(S): 6-78

APPROVED BY: RRM DATE: 12-22-11

SCALE: 1" = 50' PRIOR INST.: 19980557043