




RASTER

PARENT PARCEL: 10-00-002-000-036, -037

07-02411

CHILD PARCEL: 10-00-002-000-059 THRU -062

STARTING POINT: CENTERLINE OF MURRAY RIDGE RD & RUSSIA RD

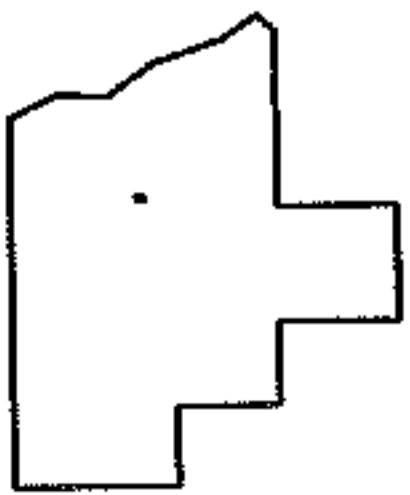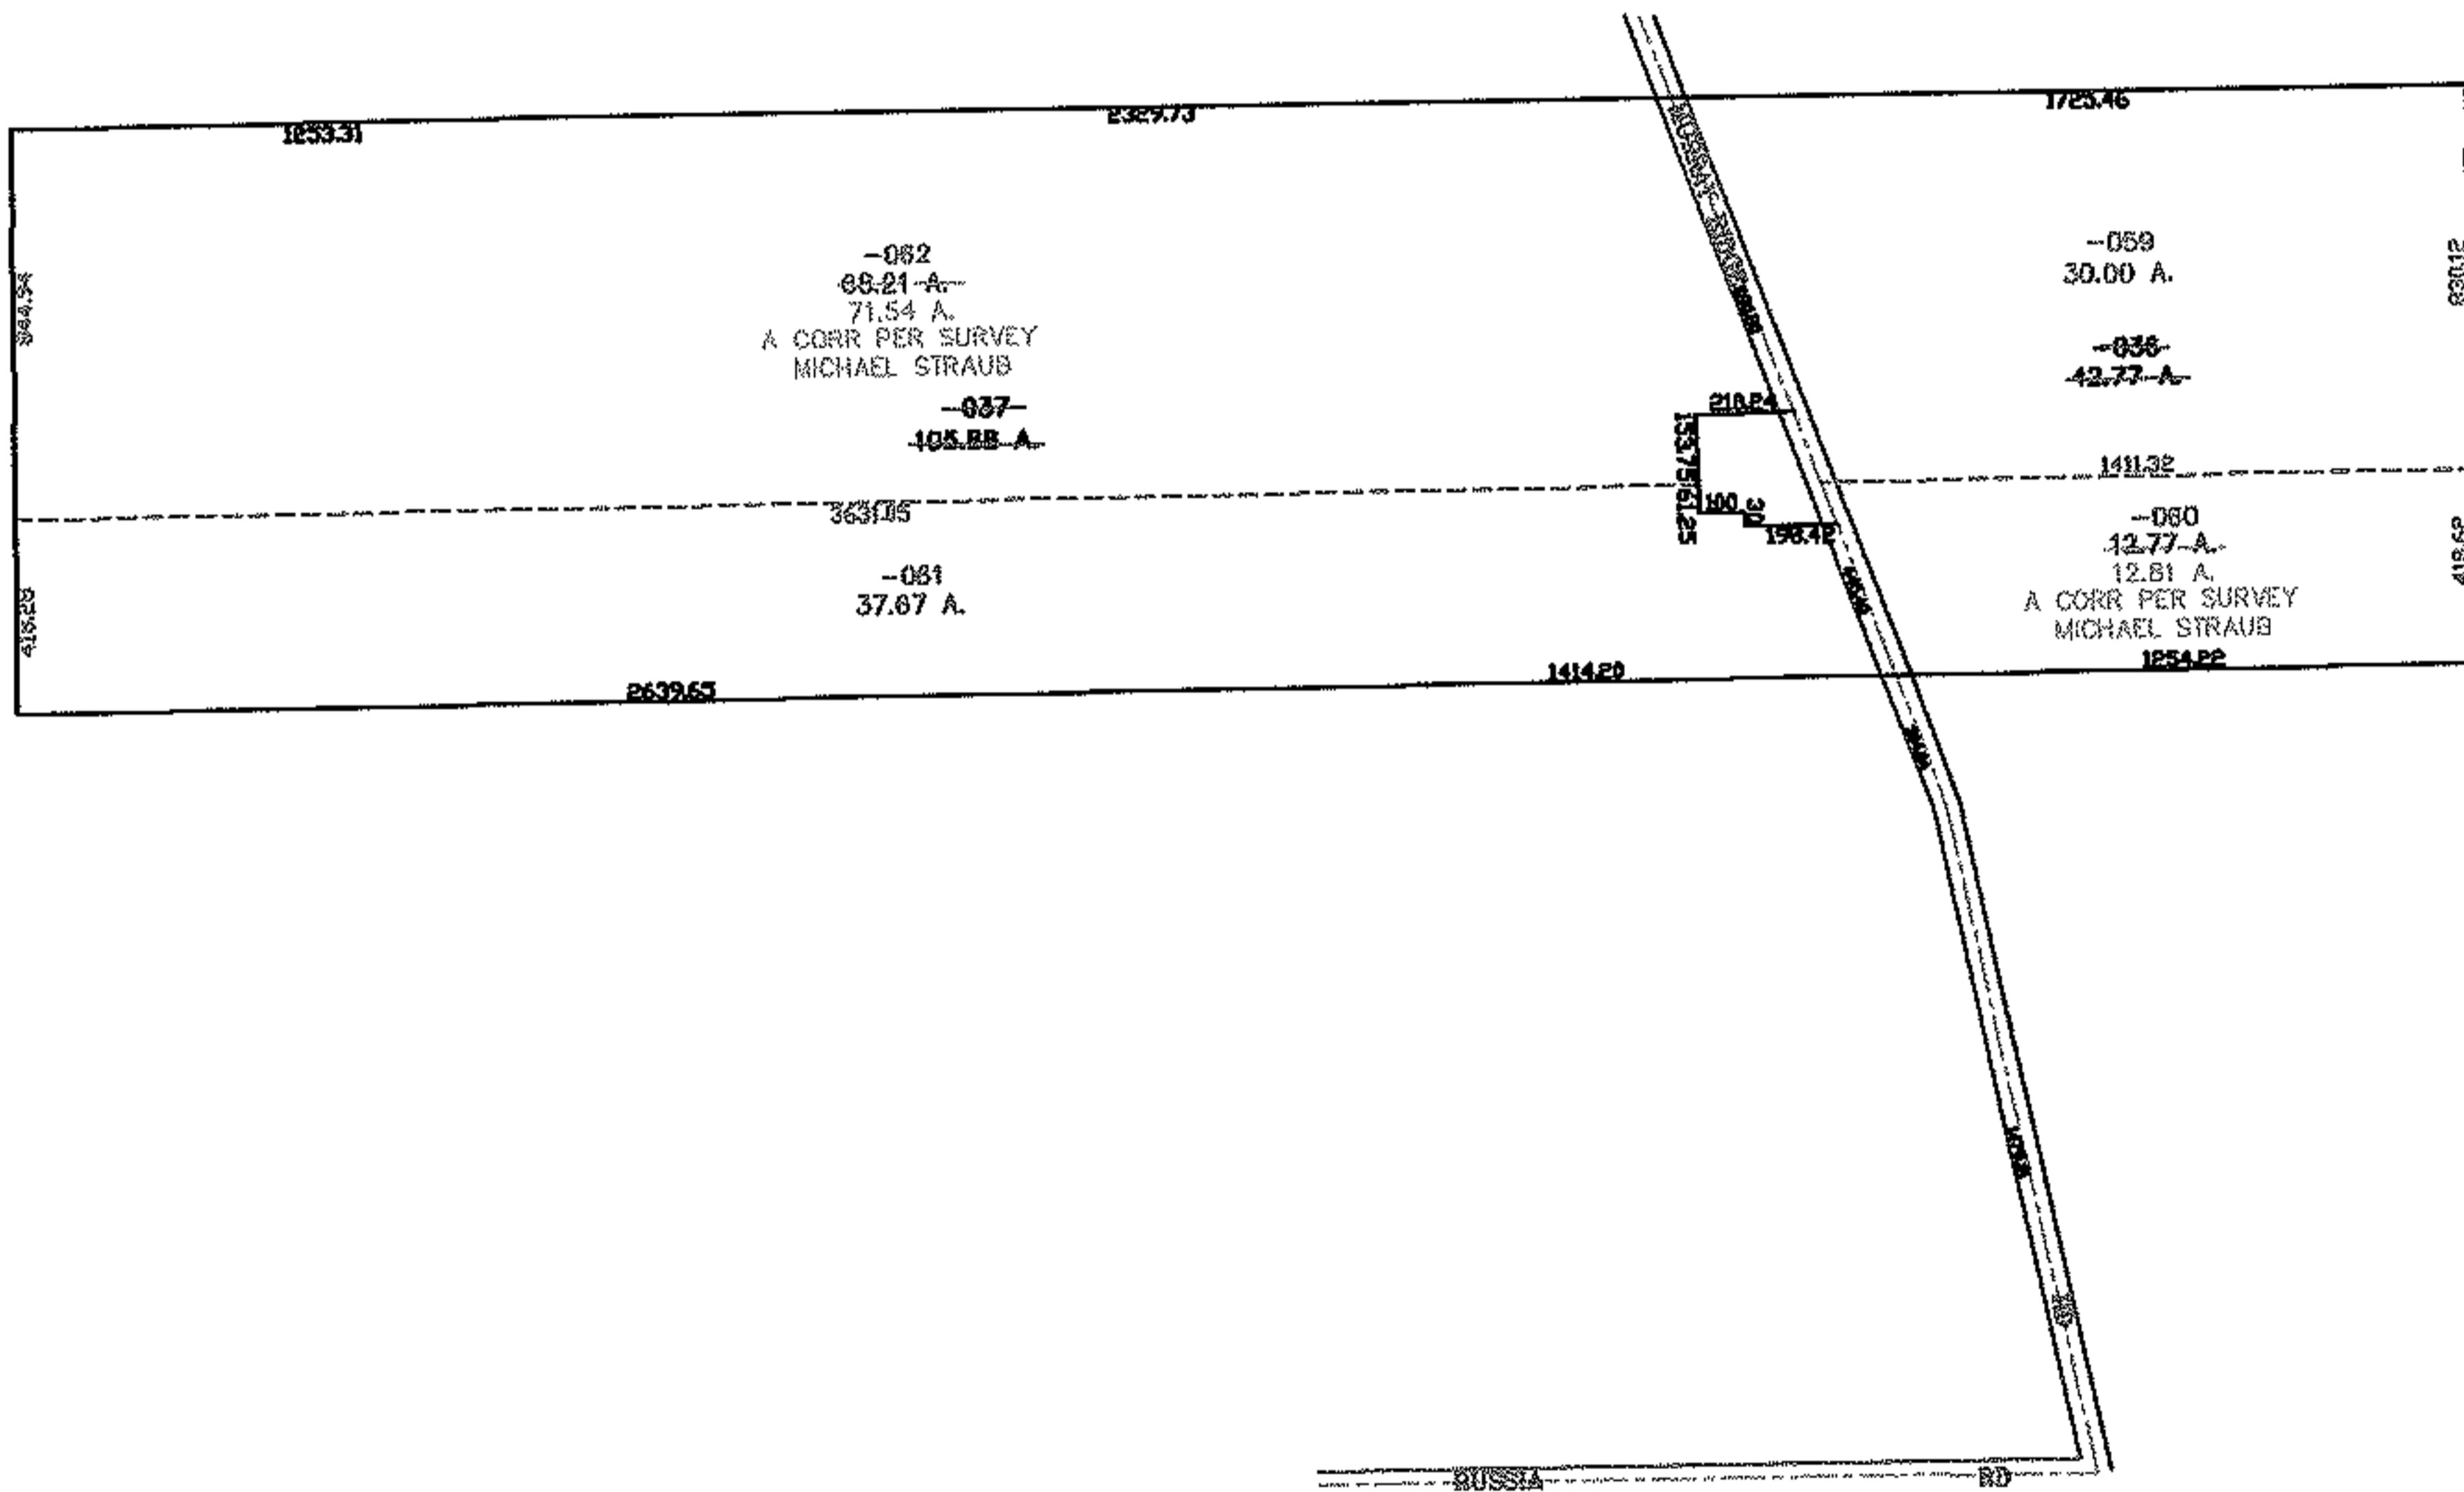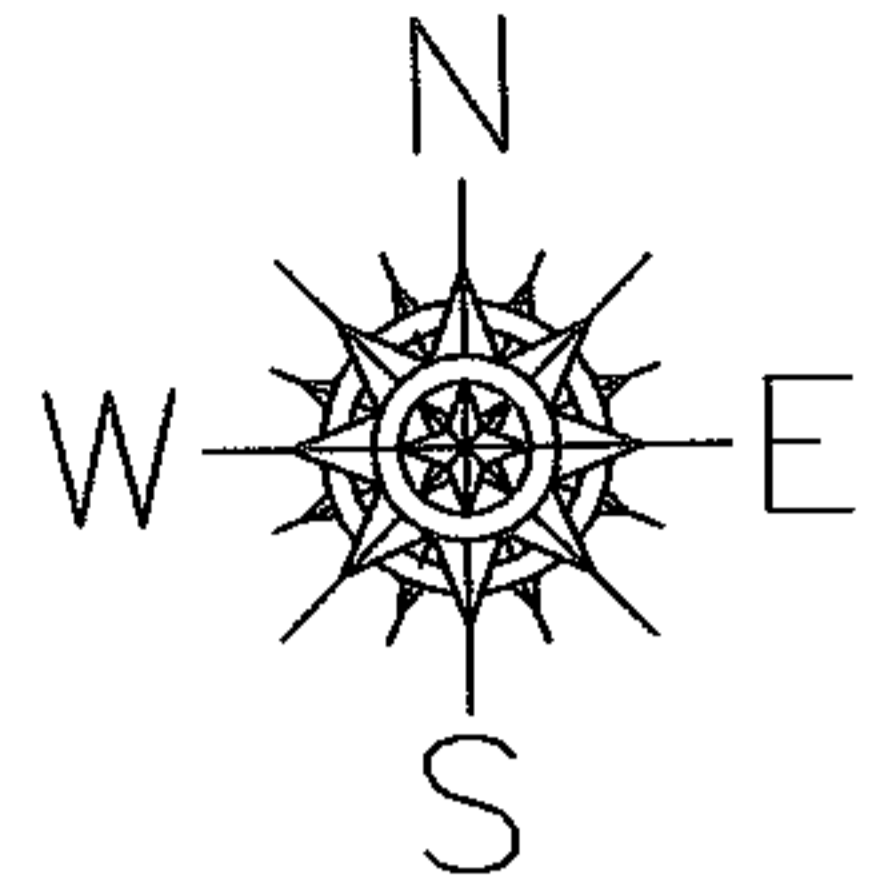

SPLITS/DEEDS PROCESSED

LORAIN COUNTY TAX MAP DEPARTMENT
226 MIDDLE AVE. ELYRIA, OHIO

SURVEYED BY: MICHAEL STRAUB

CLOSURE: 0.00 : 10.000

MAP PAGE(S): 10-00-002-G

APPROVED BY: JAH DATE: 6-25-07

SCALE: 1" = 800 PRIOR INSTRUMENT: 20050086568