



RASTER

PARENT PARCEL: 04-00-018-132-029

CHILD PARCEL: 04-00-018-132-032, -033

STARTING POINT: INTERSECTION OF NORTH LINE OF LAKE RD. AND EAST LINE OF LAND  
CONVEYED TO CHARLES W. JOHNSON (DV 36/224)

12-02413-U

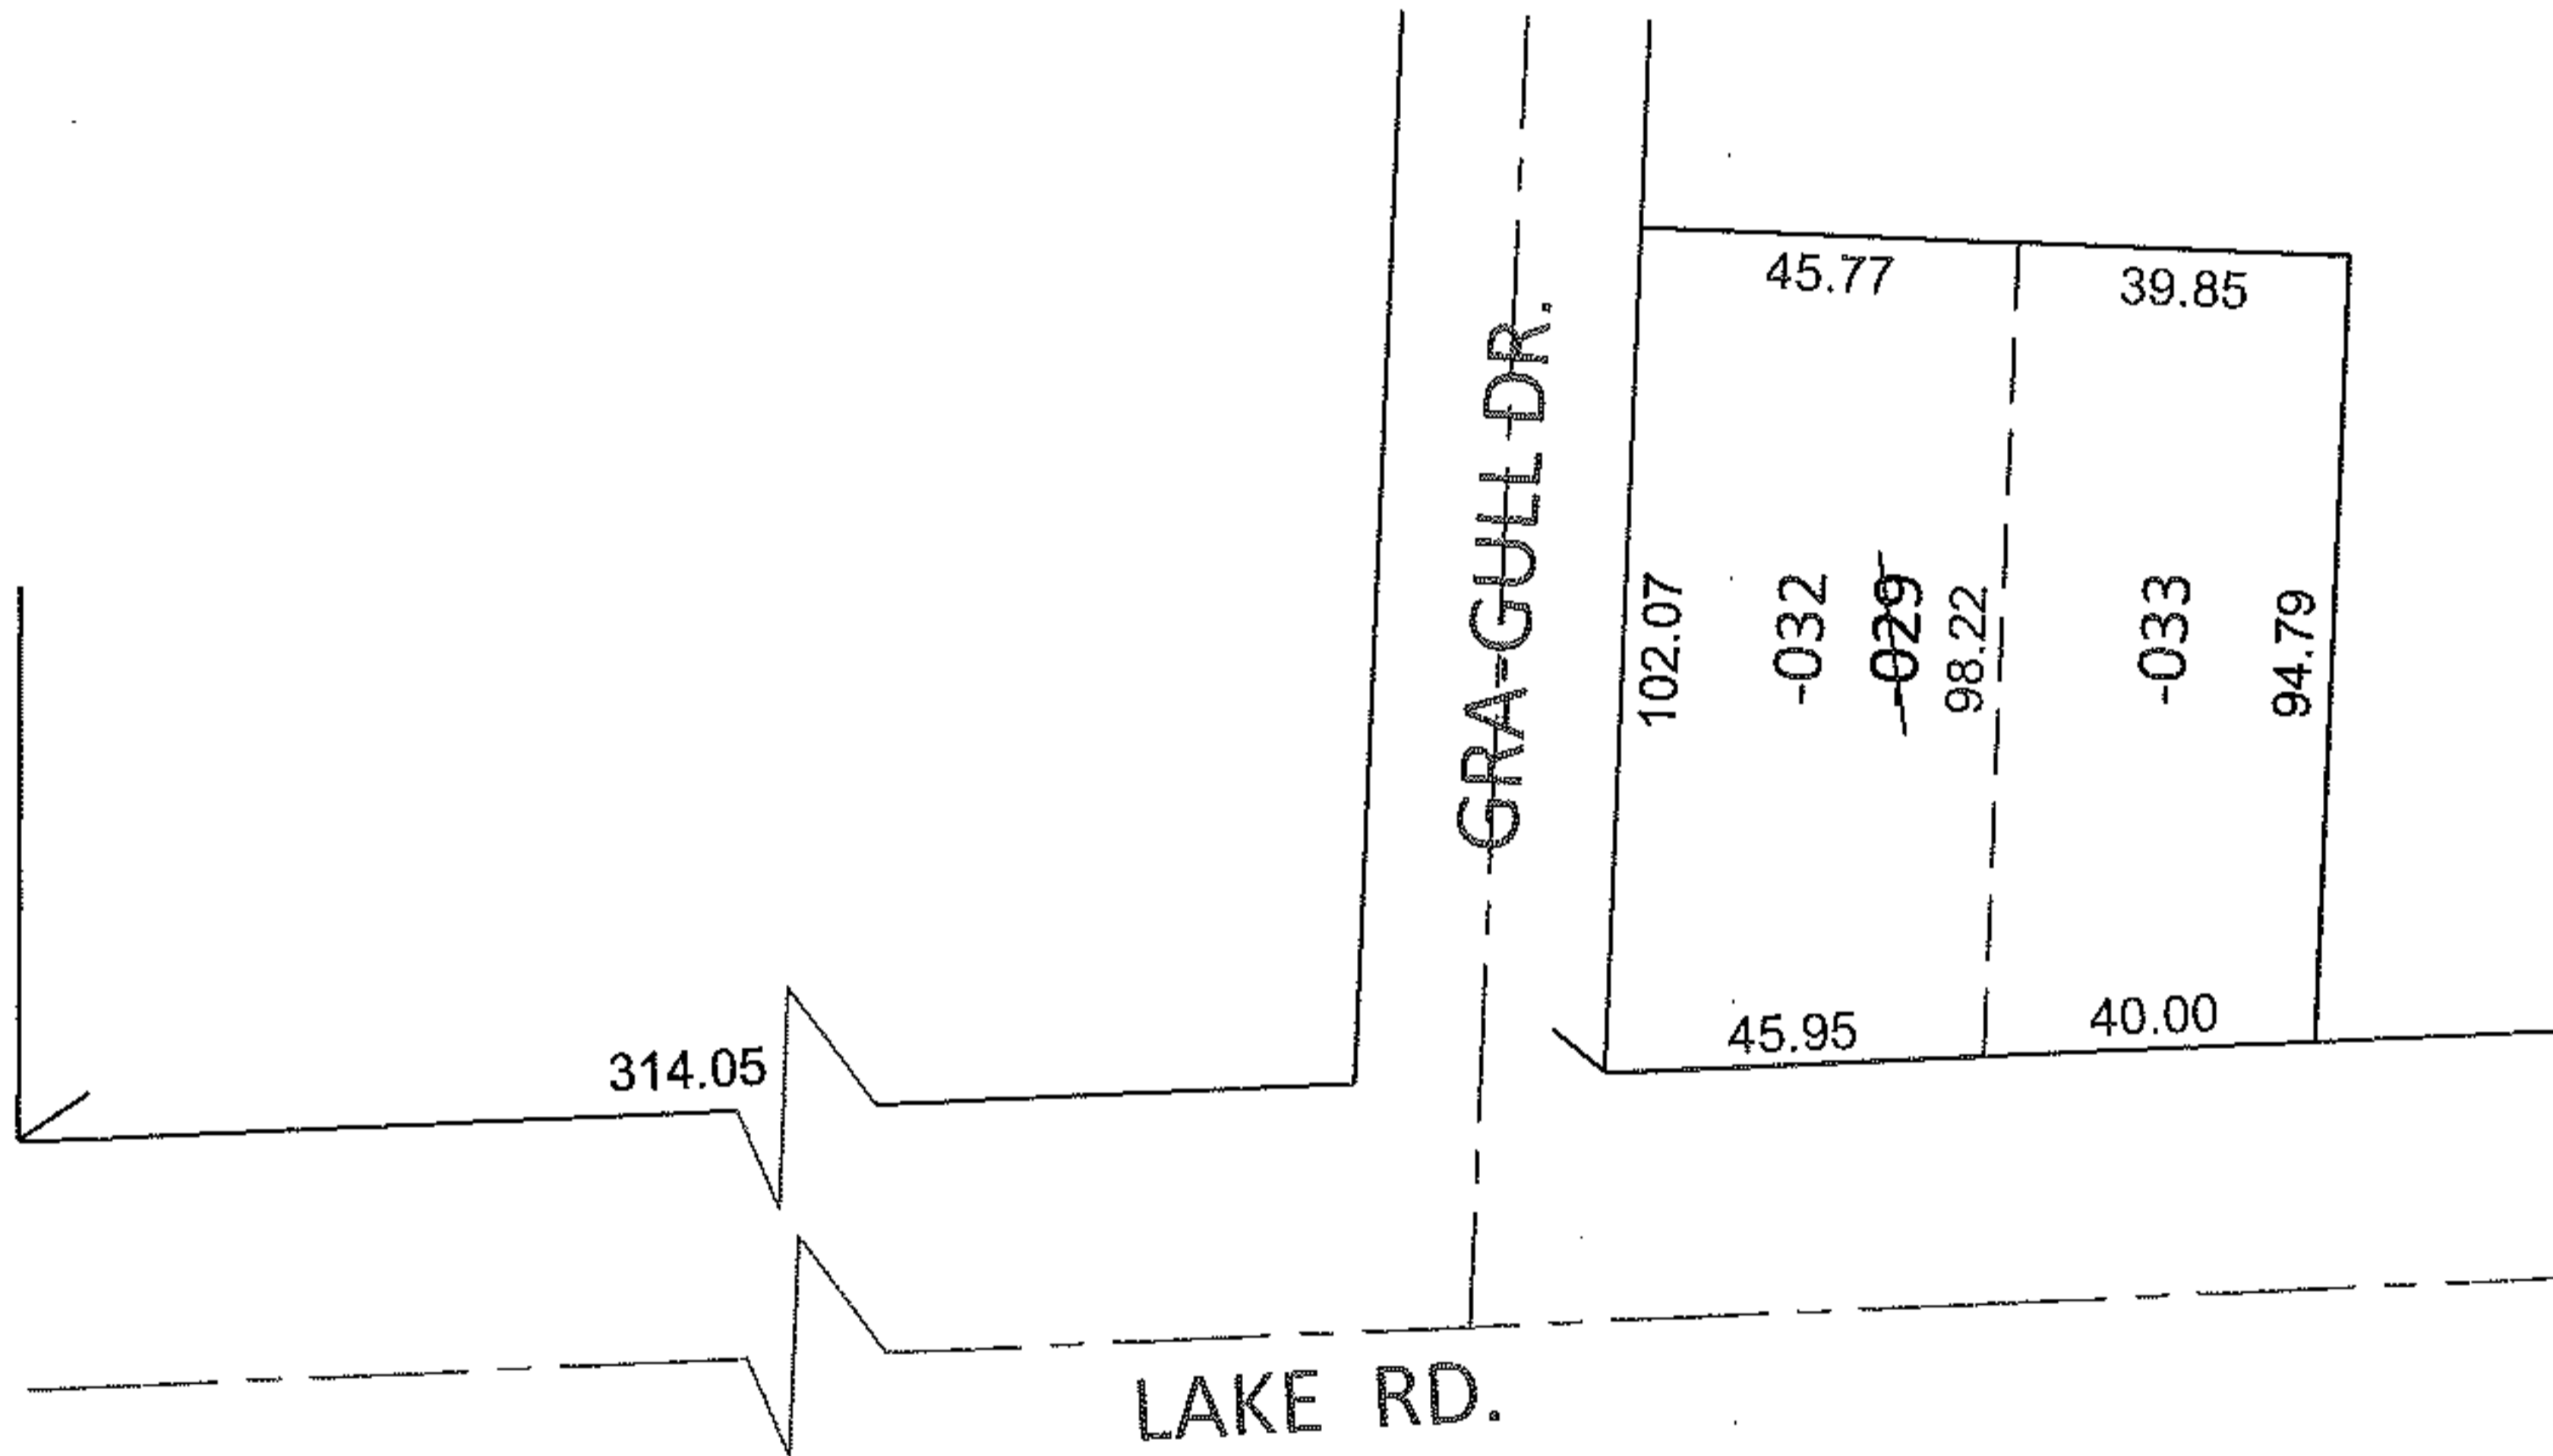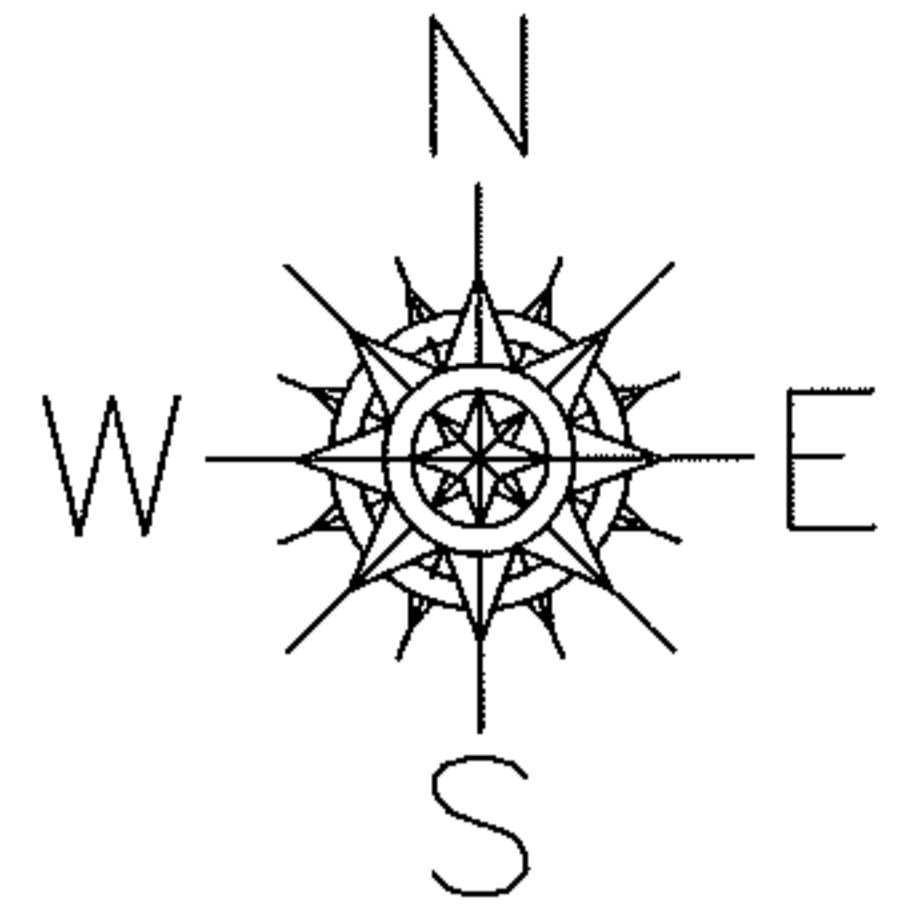

UNCOMBINATION


~~04-00-018-132-029~~

~~86 X 102~~

04-00-018-132-032  
45.95 X 102.07

04-00-018-132-033  
40 X 98.22

PER PRIOR DEEDS

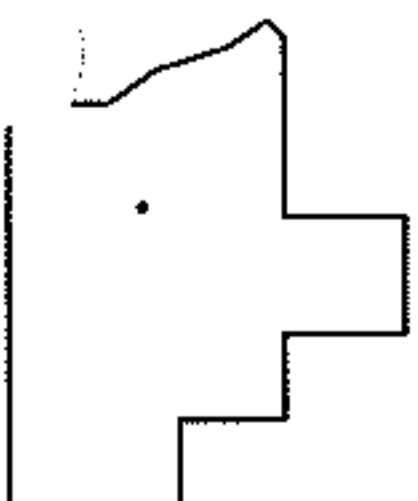

SPLITS/DEEDS PROCESSED

LORAIN COUNTY TAX MAP DEPARTMENT  
226 MIDDLE AVE. ELYRIA, OHIO

SURVEYED BY: N/A

CLOSURE: .01:10,000

MAP PAGE(S): 4-00-018-D

APPROVED BY: RRM DATE: 1-3-12

SCALE: 1" = 50' PRIOR INST.: 20090313401