
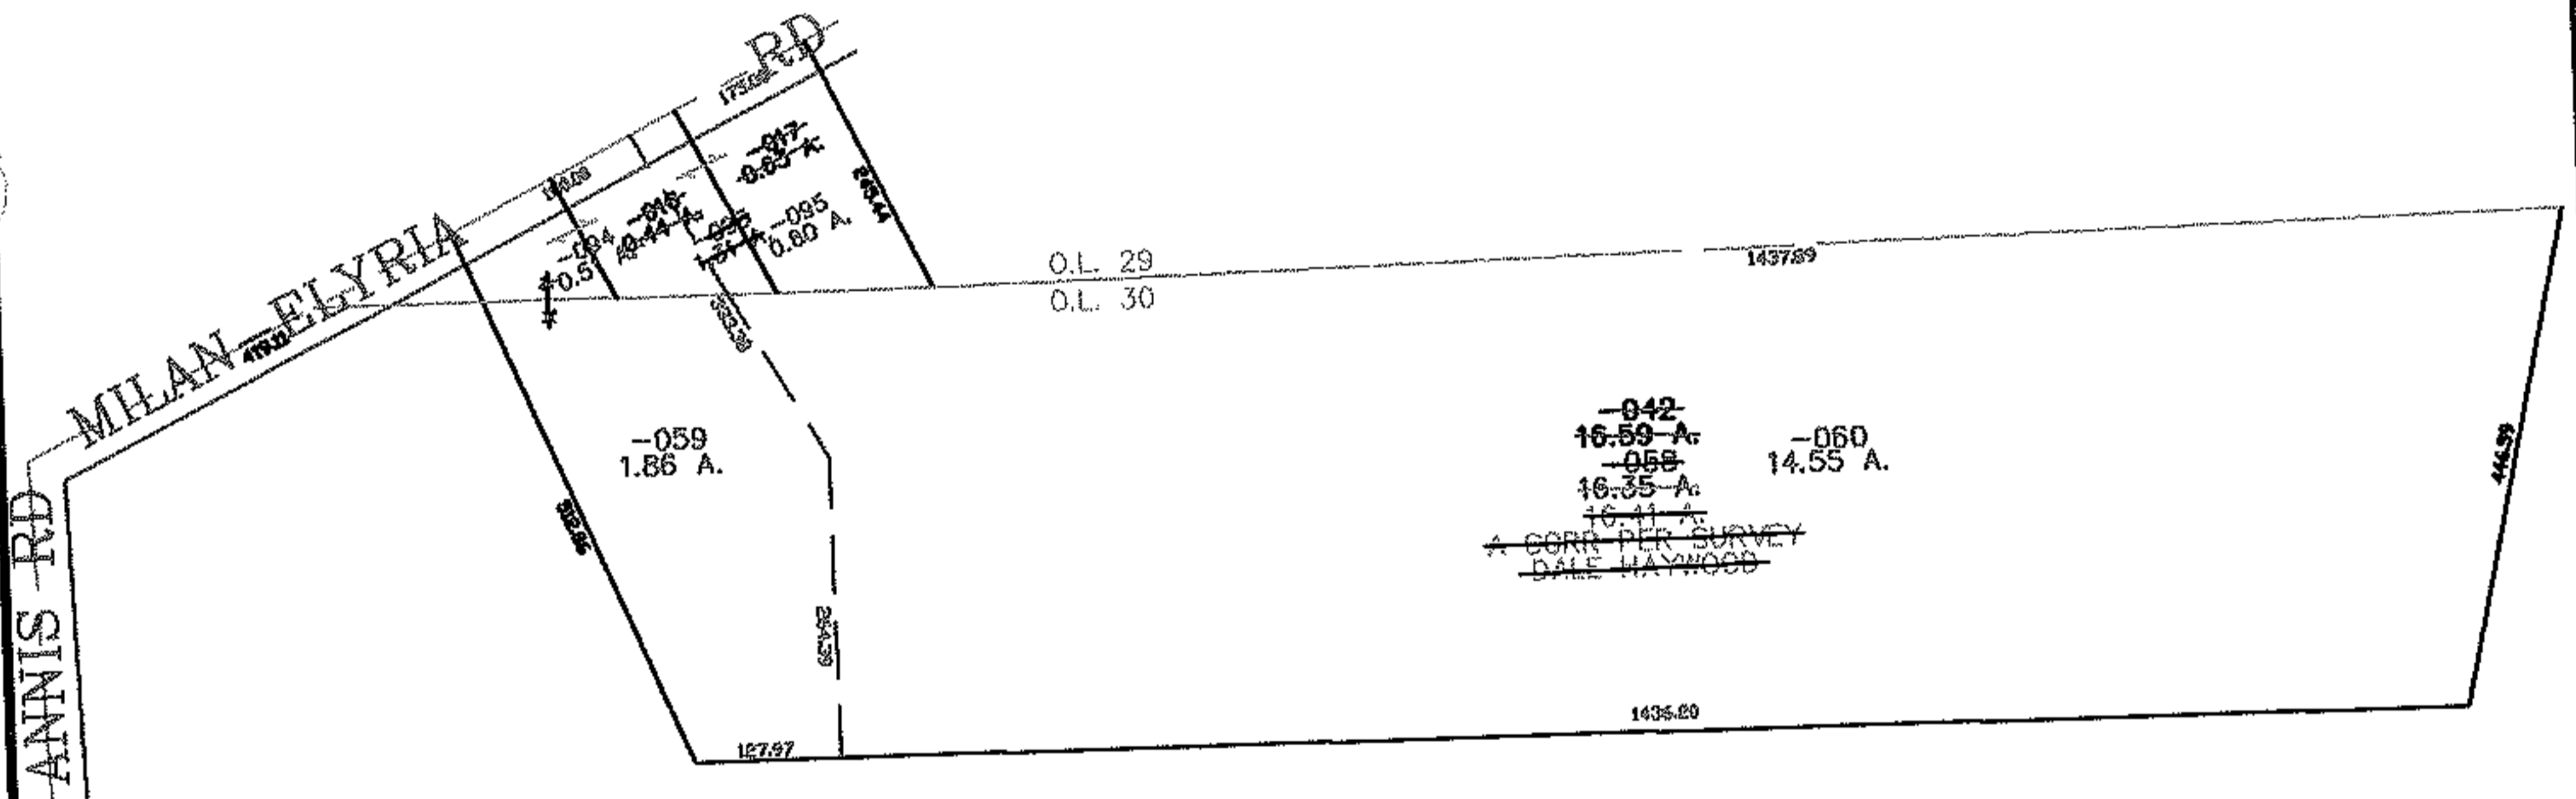



RASTER

PARENT PARCEL: 05-00-030-000-042, 05-00-029-000-016, -017
CHILD PARCEL: 05-00-029-000-093 THRU -095 05-00-030-000-058 THRU -060
STARTING POINT: CENTERLINE OF ANNIS RD & MILAN-ELYRIA RD

07-02415

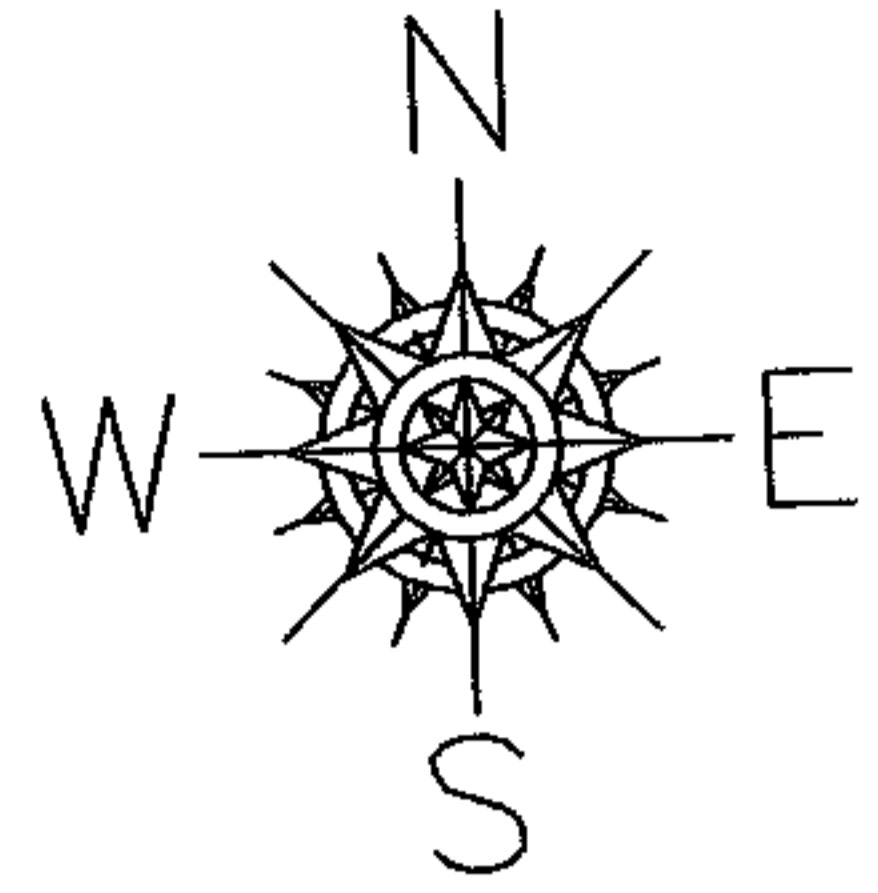

~~-042~~
~~16.59 A.~~ ~~-060~~
~~-058~~ 14.55 A.
~~16.35 A.~~
~~16.41 A.~~
A CORN PER SURVEY
DALE HAYWOOD

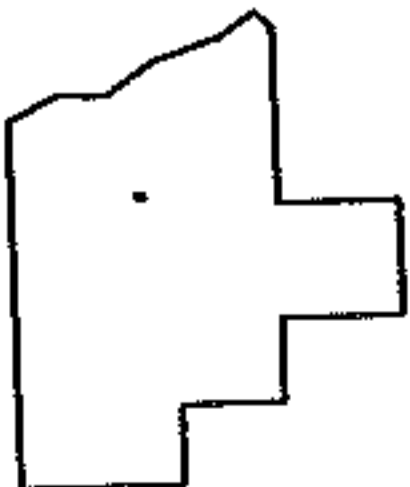

SPLITS/DEEDS PROCESSED
LORAIN COUNTY TAX MAP DEPARTMENT
226 MIDDLE AVE. ELYRIA, OHIO

SURVEYED BY: DALE HAYWOOD
CLOSURE: 0.00 : 10.000
MAP PAGE(S): 05-00-030-B -029-A
APPROVED BY: JAH DATE: 6-26-07
SCALE: 1" = 300 PRIOR INSTRUMENT: 2005011216