


RASTER

PARENT PARCEL: 06-26-066-000-002

CHILD PARCEL: _____

STARTING POINT: INTERSECTION OF SOUTH LINE OF BROAD ST. AND EAST LINE OF WATER ST.

12-02417-C

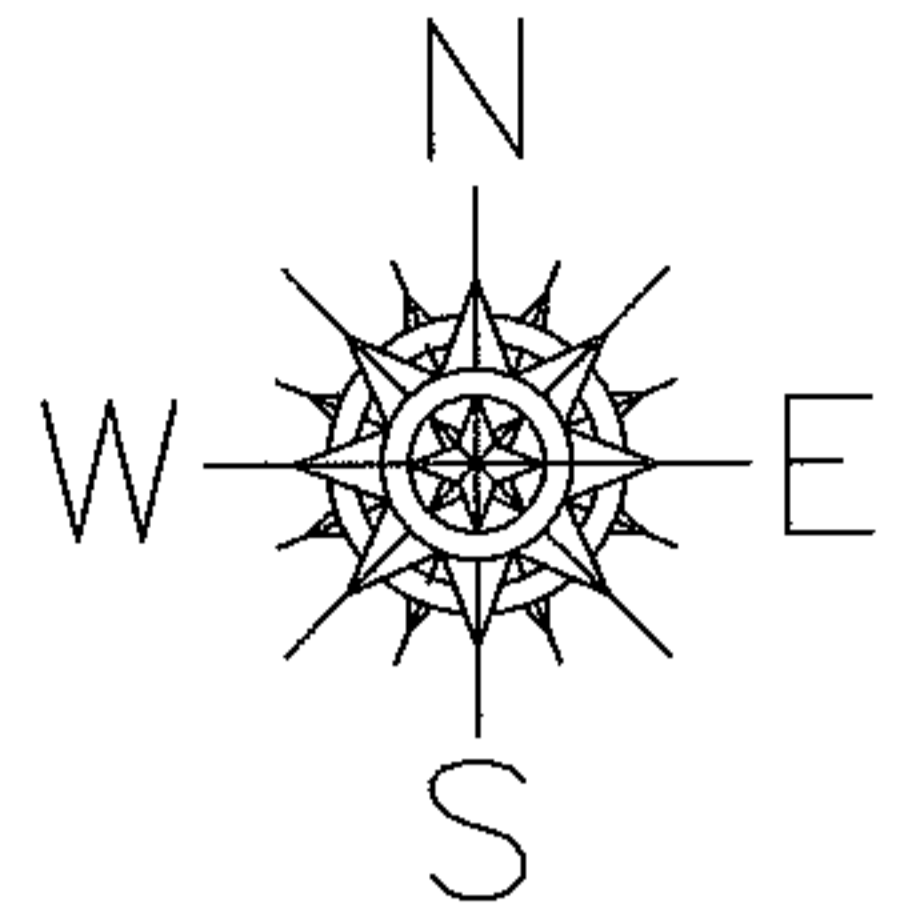


FRONTAGE AND DEPTH CORRECTION

06-26-066-000-002

42.15 X 83.09

~~42.11 X 83~~

PER SURV. D.HAYWOOD

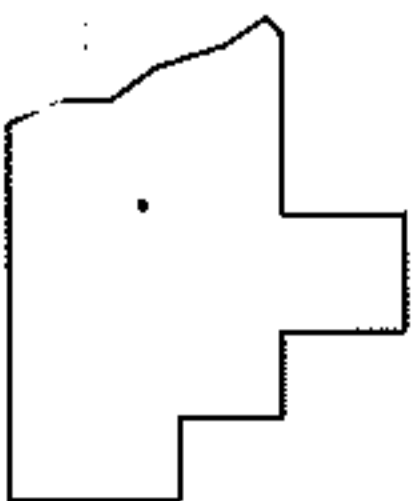

SPLITS/DEEDS PROCESSED

LORAIN COUNTY TAX MAP DEPARTMENT
226 MIDDLE AVE. ELYRIA, OHIO

SURVEYED BY: DALE R. HAYWOOD

CLOSURE: .01:10,000

MAP PAGE(S): 6-118

APPROVED BY: RRM DATE: 1-5-12

SCALE: 1" = 50' PRIOR INST.: OR 396/78