
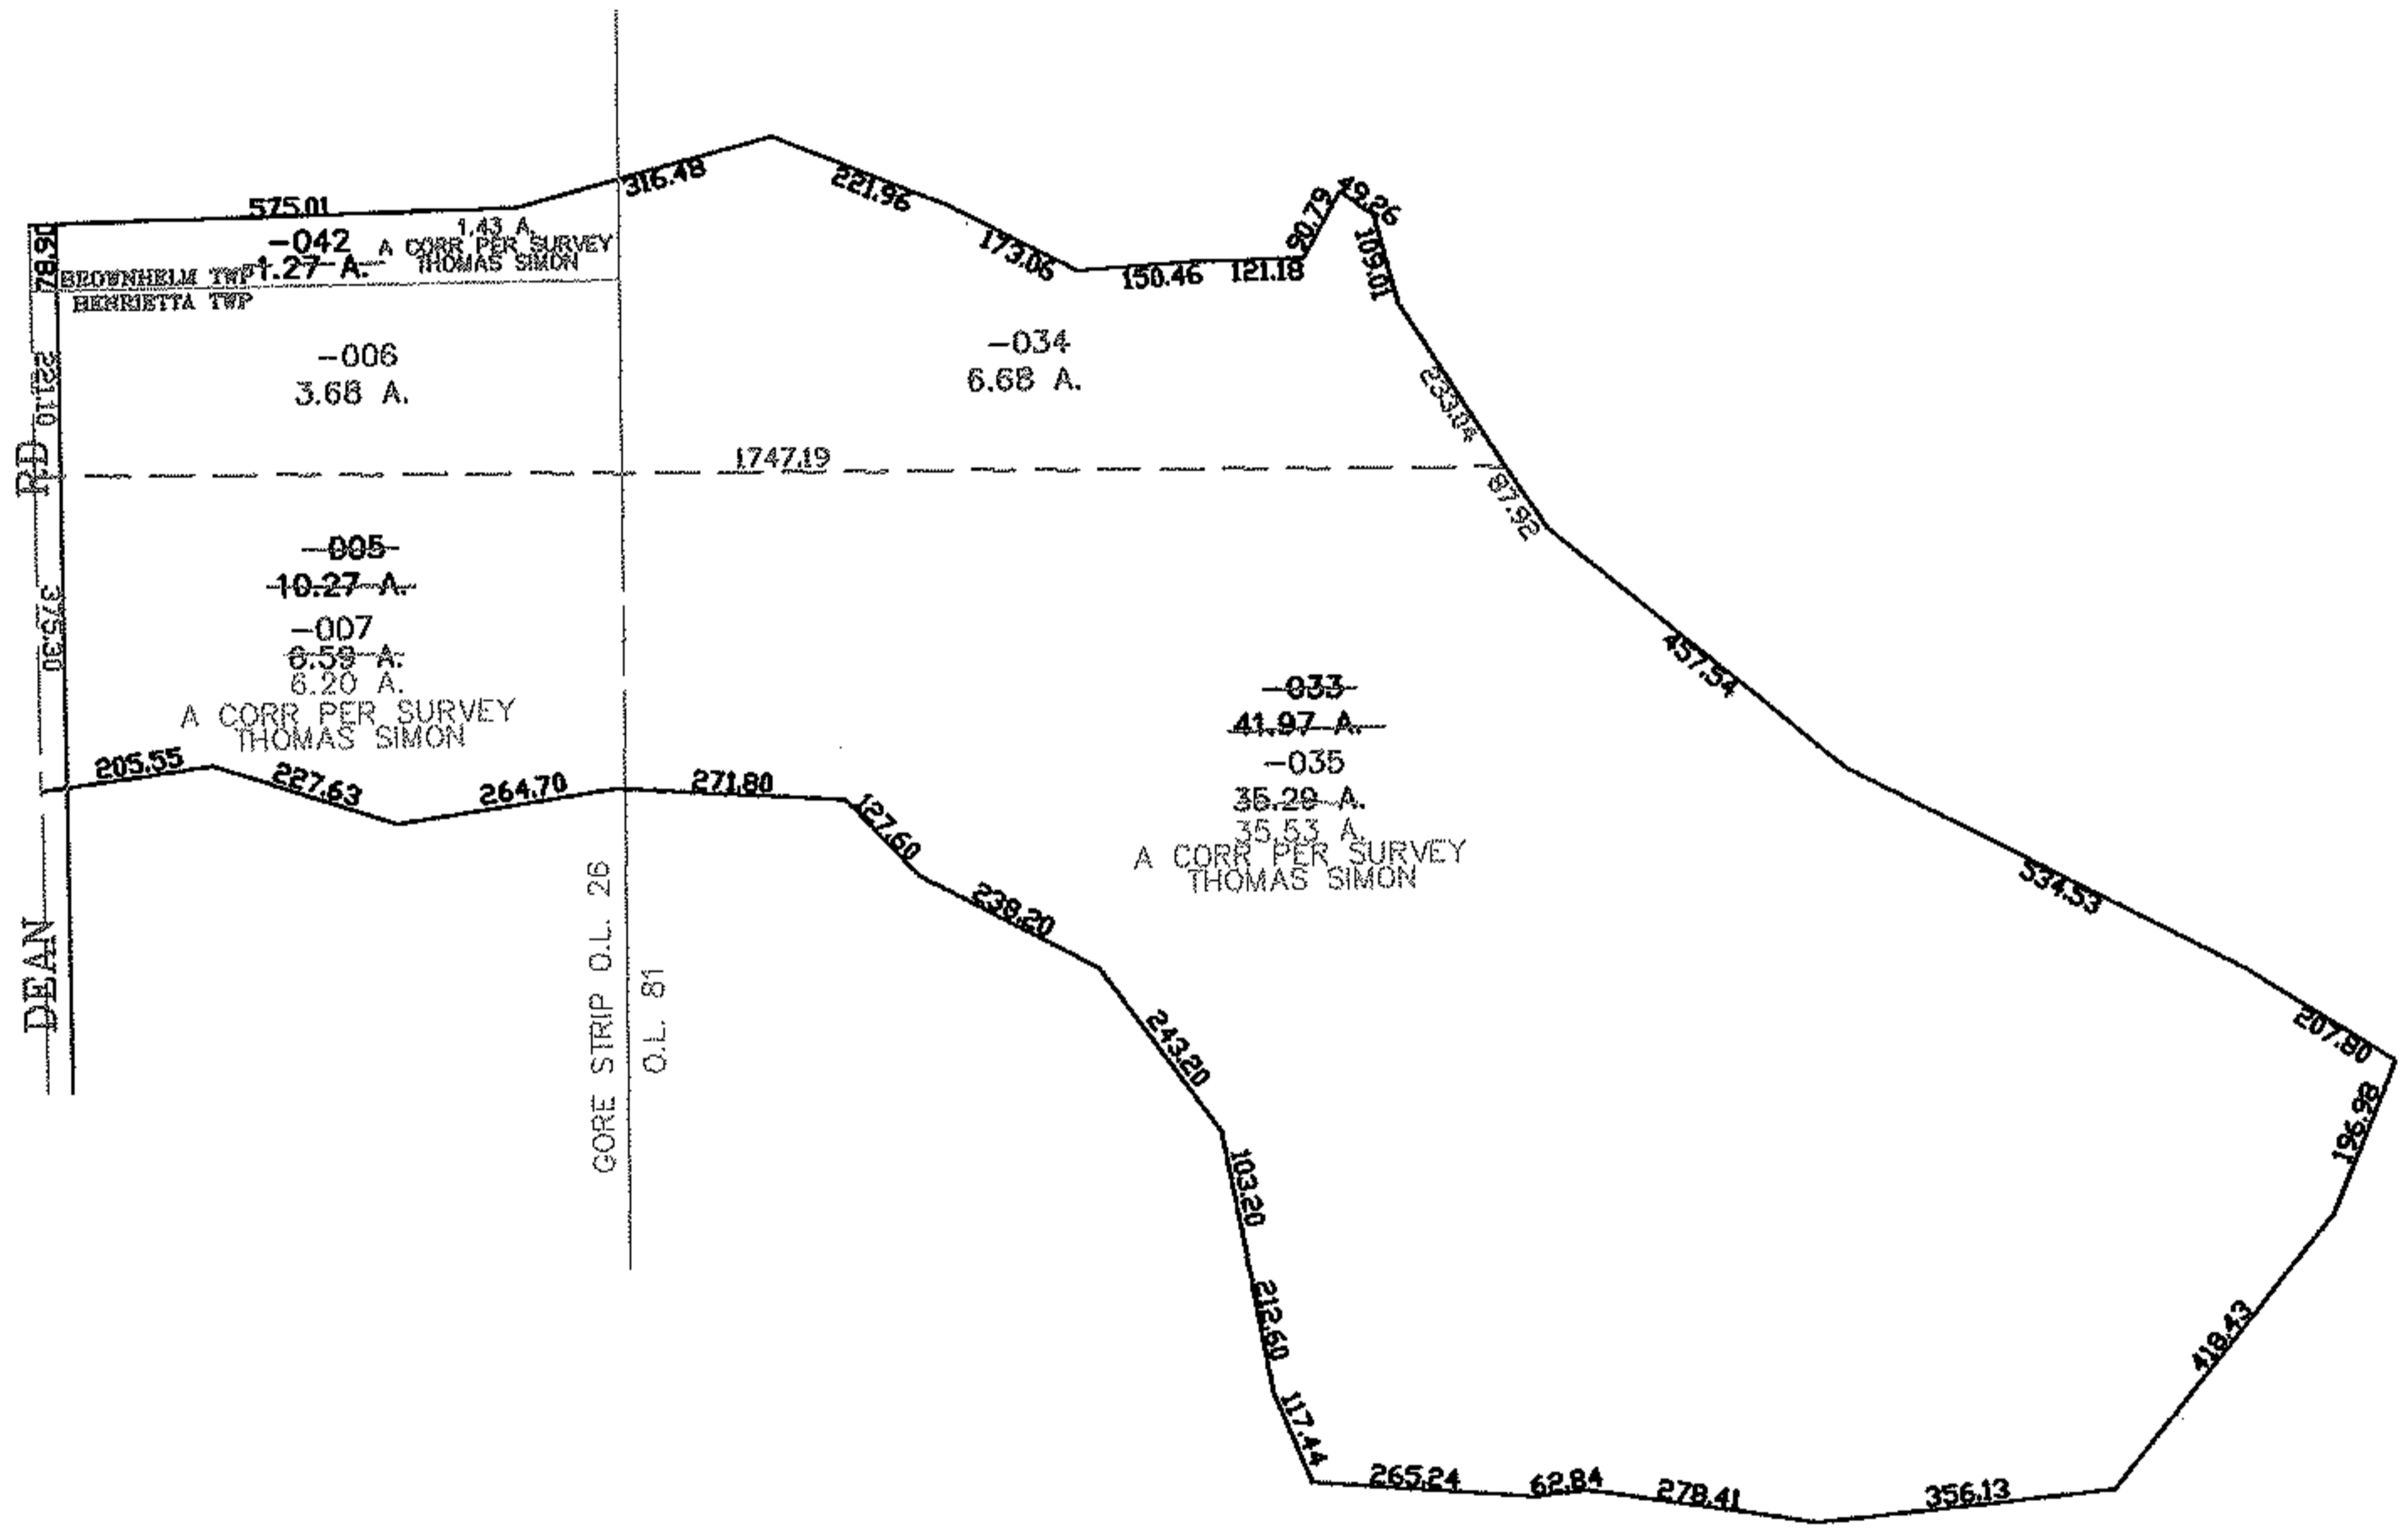


RASTER

PARENT PARCEL: 08-20-026-000-005, 08-00-081-000-033
CHILD PARCEL: 08-20-026-000-006, -007 08-00-081-000-034, -035
STARTING POINT: CENTERLINE OF DEAN RD & BROWNHelm TWP LINE

07-02418

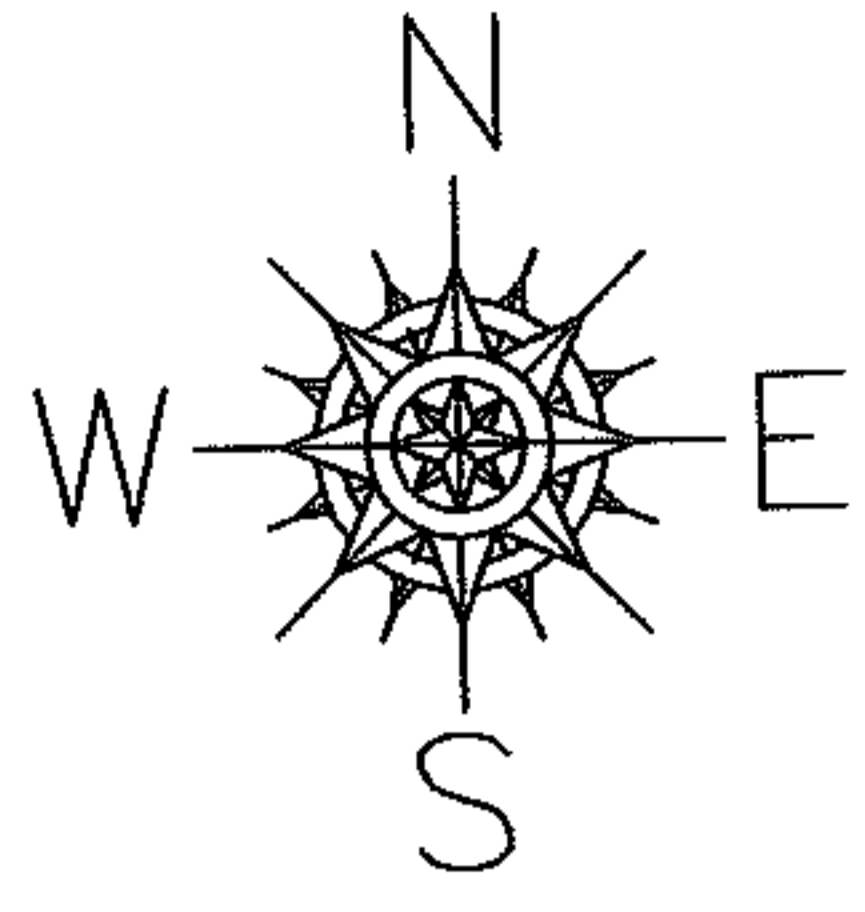

SPLITS/DEEDS PROCESSED

LORAIN COUNTY TAX MAP DEPARTMENT
226 MIDDLE AVE. ELYRIA, OHIO

SURVEYED BY: THOMAS SIMON
CLOSURE: 0.00 : 10,000
MAP PAGE(S): 08-00-081-A
APPROVED BY: JAH DATE: 7-5-07
SCALE: 1" = 400 PRIOR INSTRUMENT: 980522476