


RASTER

PARENT PARCEL: 01-00-002-101-033

CHILD PARCEL: 01-00-002-101-097, -098


STARTING POINT: CENTERLINE OF FORD LN & CINEMA CT

07-02419

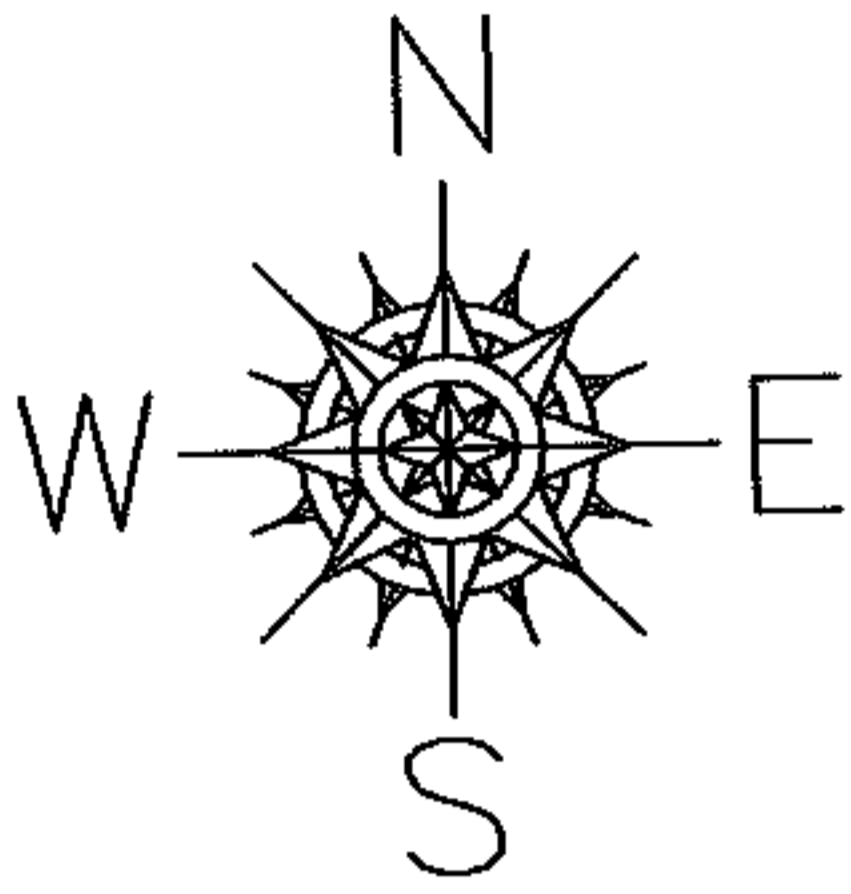

CINEMA CT

FORD LN

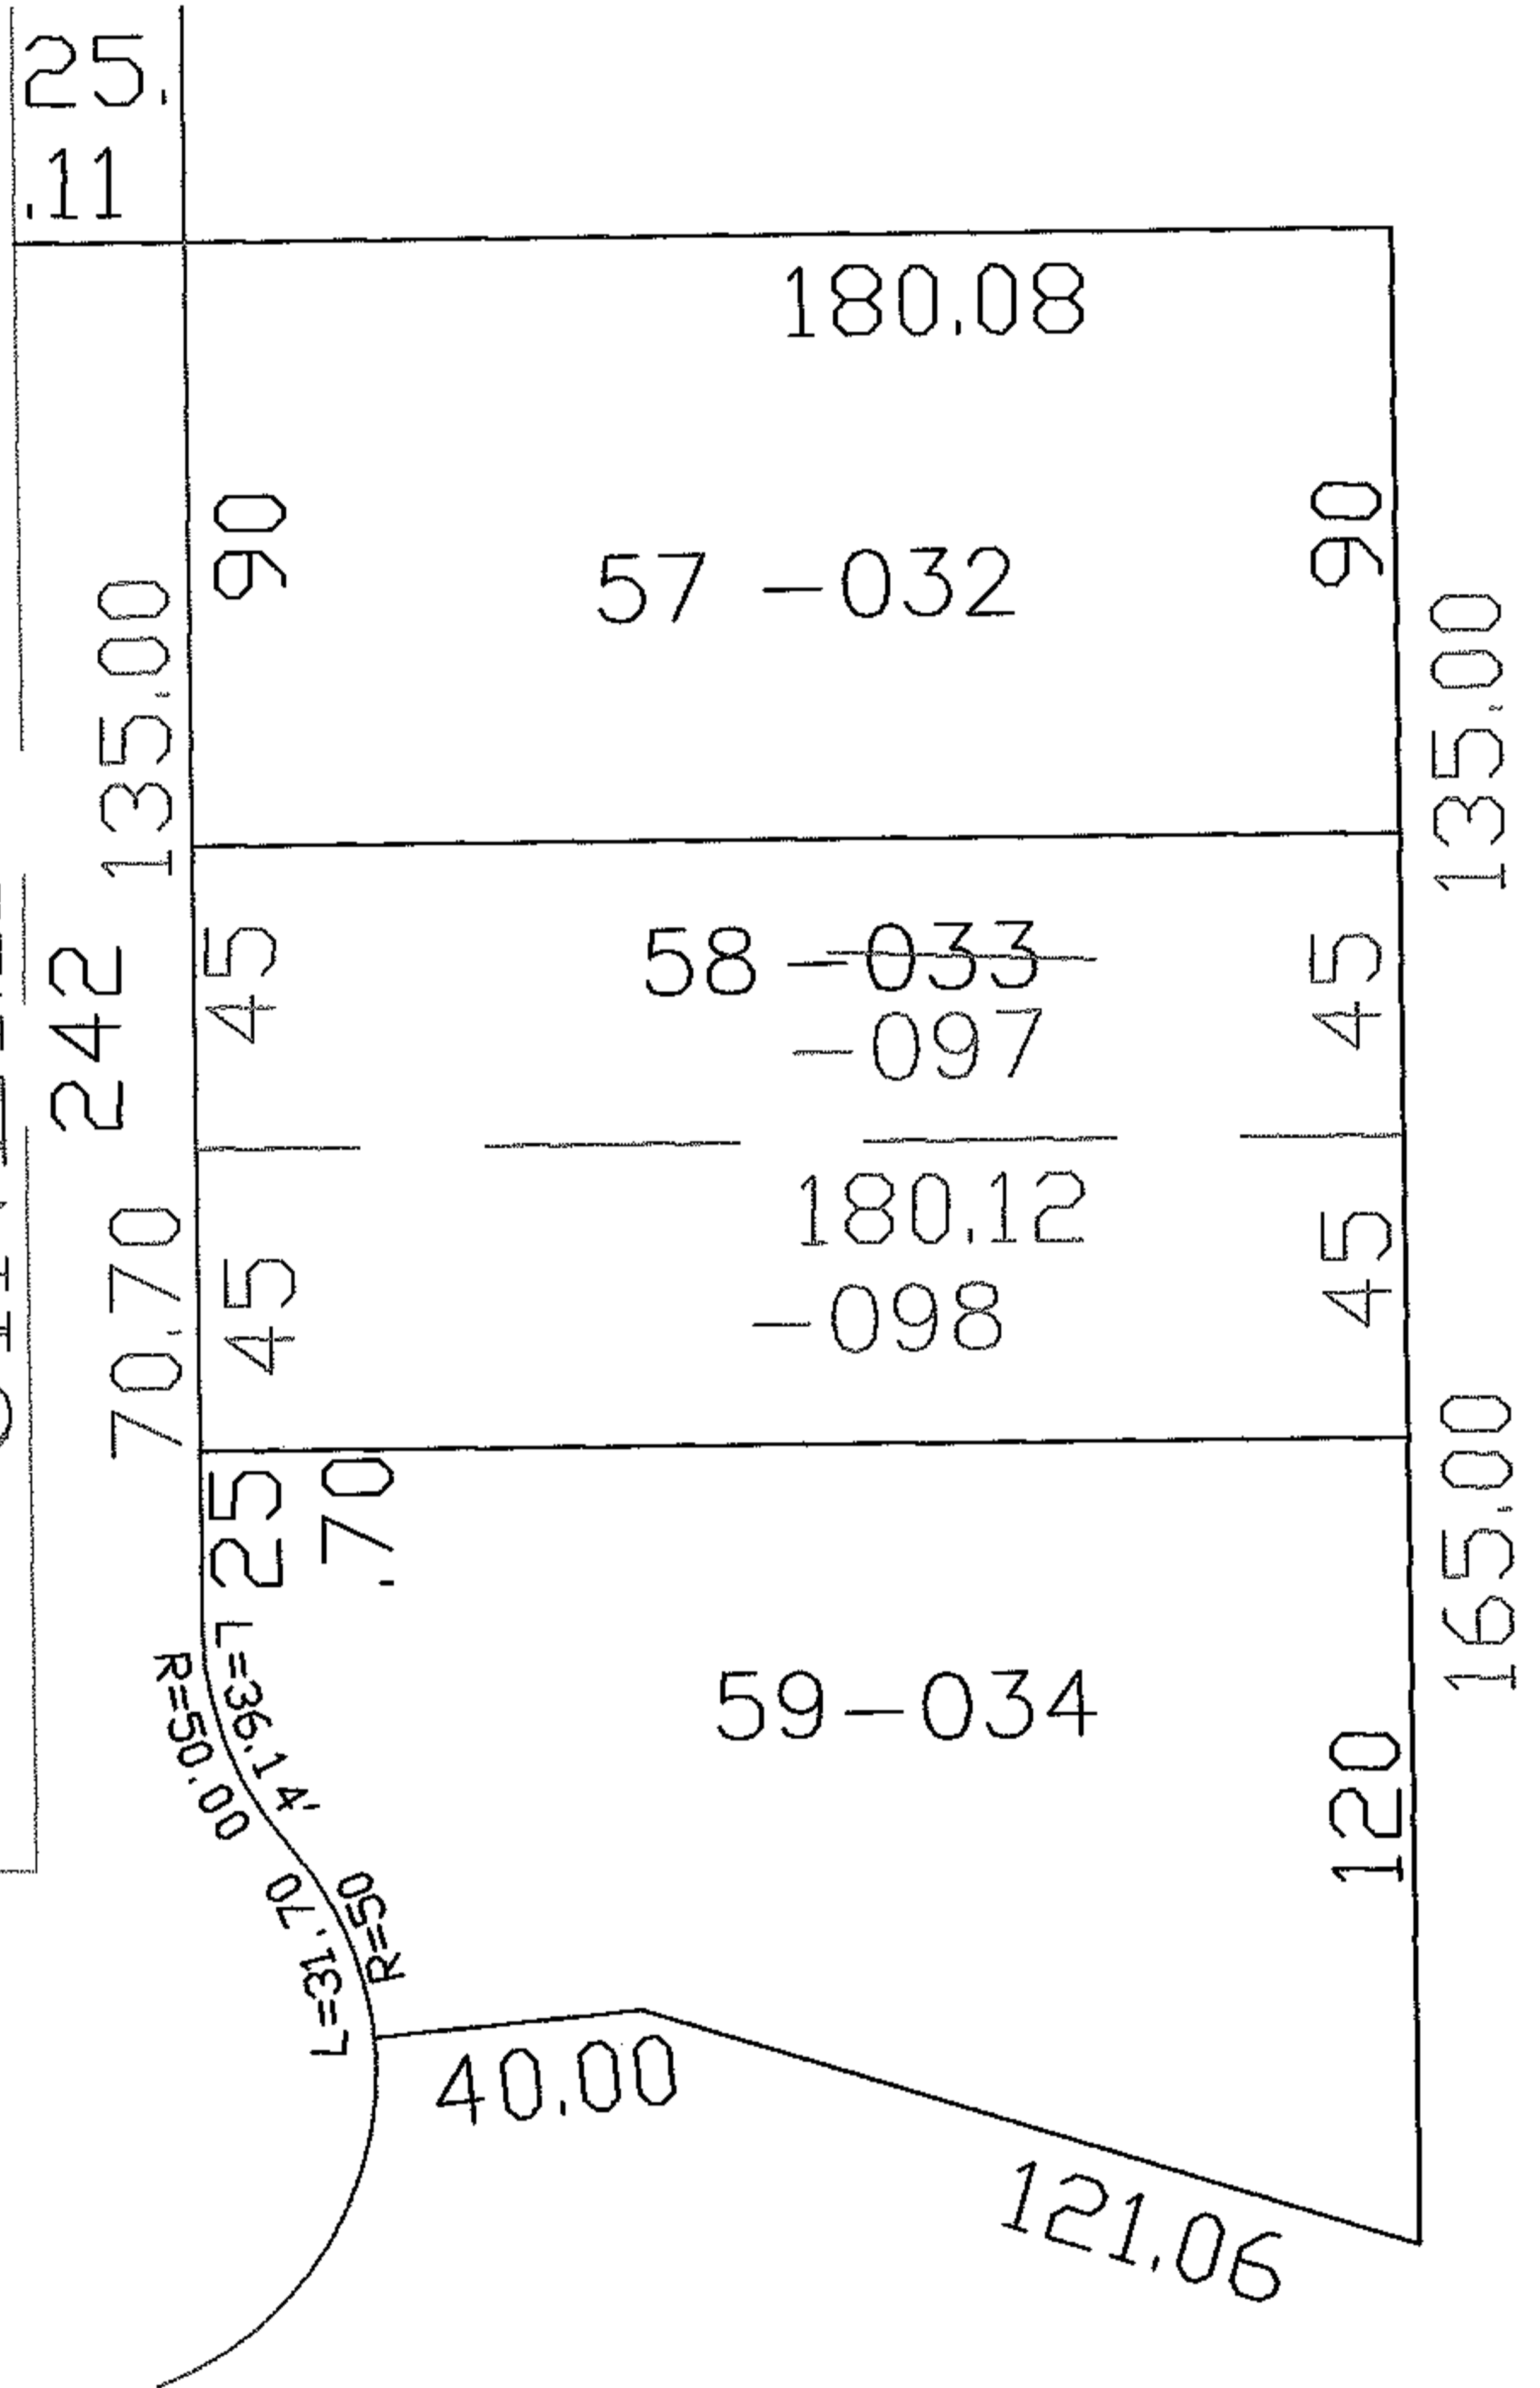

SPLITS/DEEDS PROCESSED

LORAIN COUNTY TAX MAP DEPARTMENT  
226 MIDDLE AVE. ELYRIA, OHIO

SURVEYED BY: JOHN E DAMM

CLOSURE: 0.00 : 10.000

MAP PAGE(S): 01-00-002-A

APPROVED BY: JAH DATE: 7-11-07

SCALE: 1" = 100 PRIOR INSTRUMENT: DV 449/661