
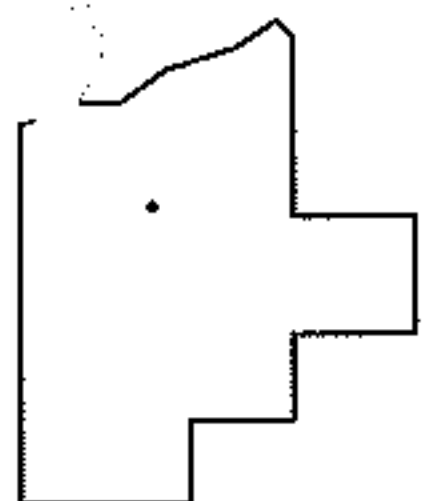
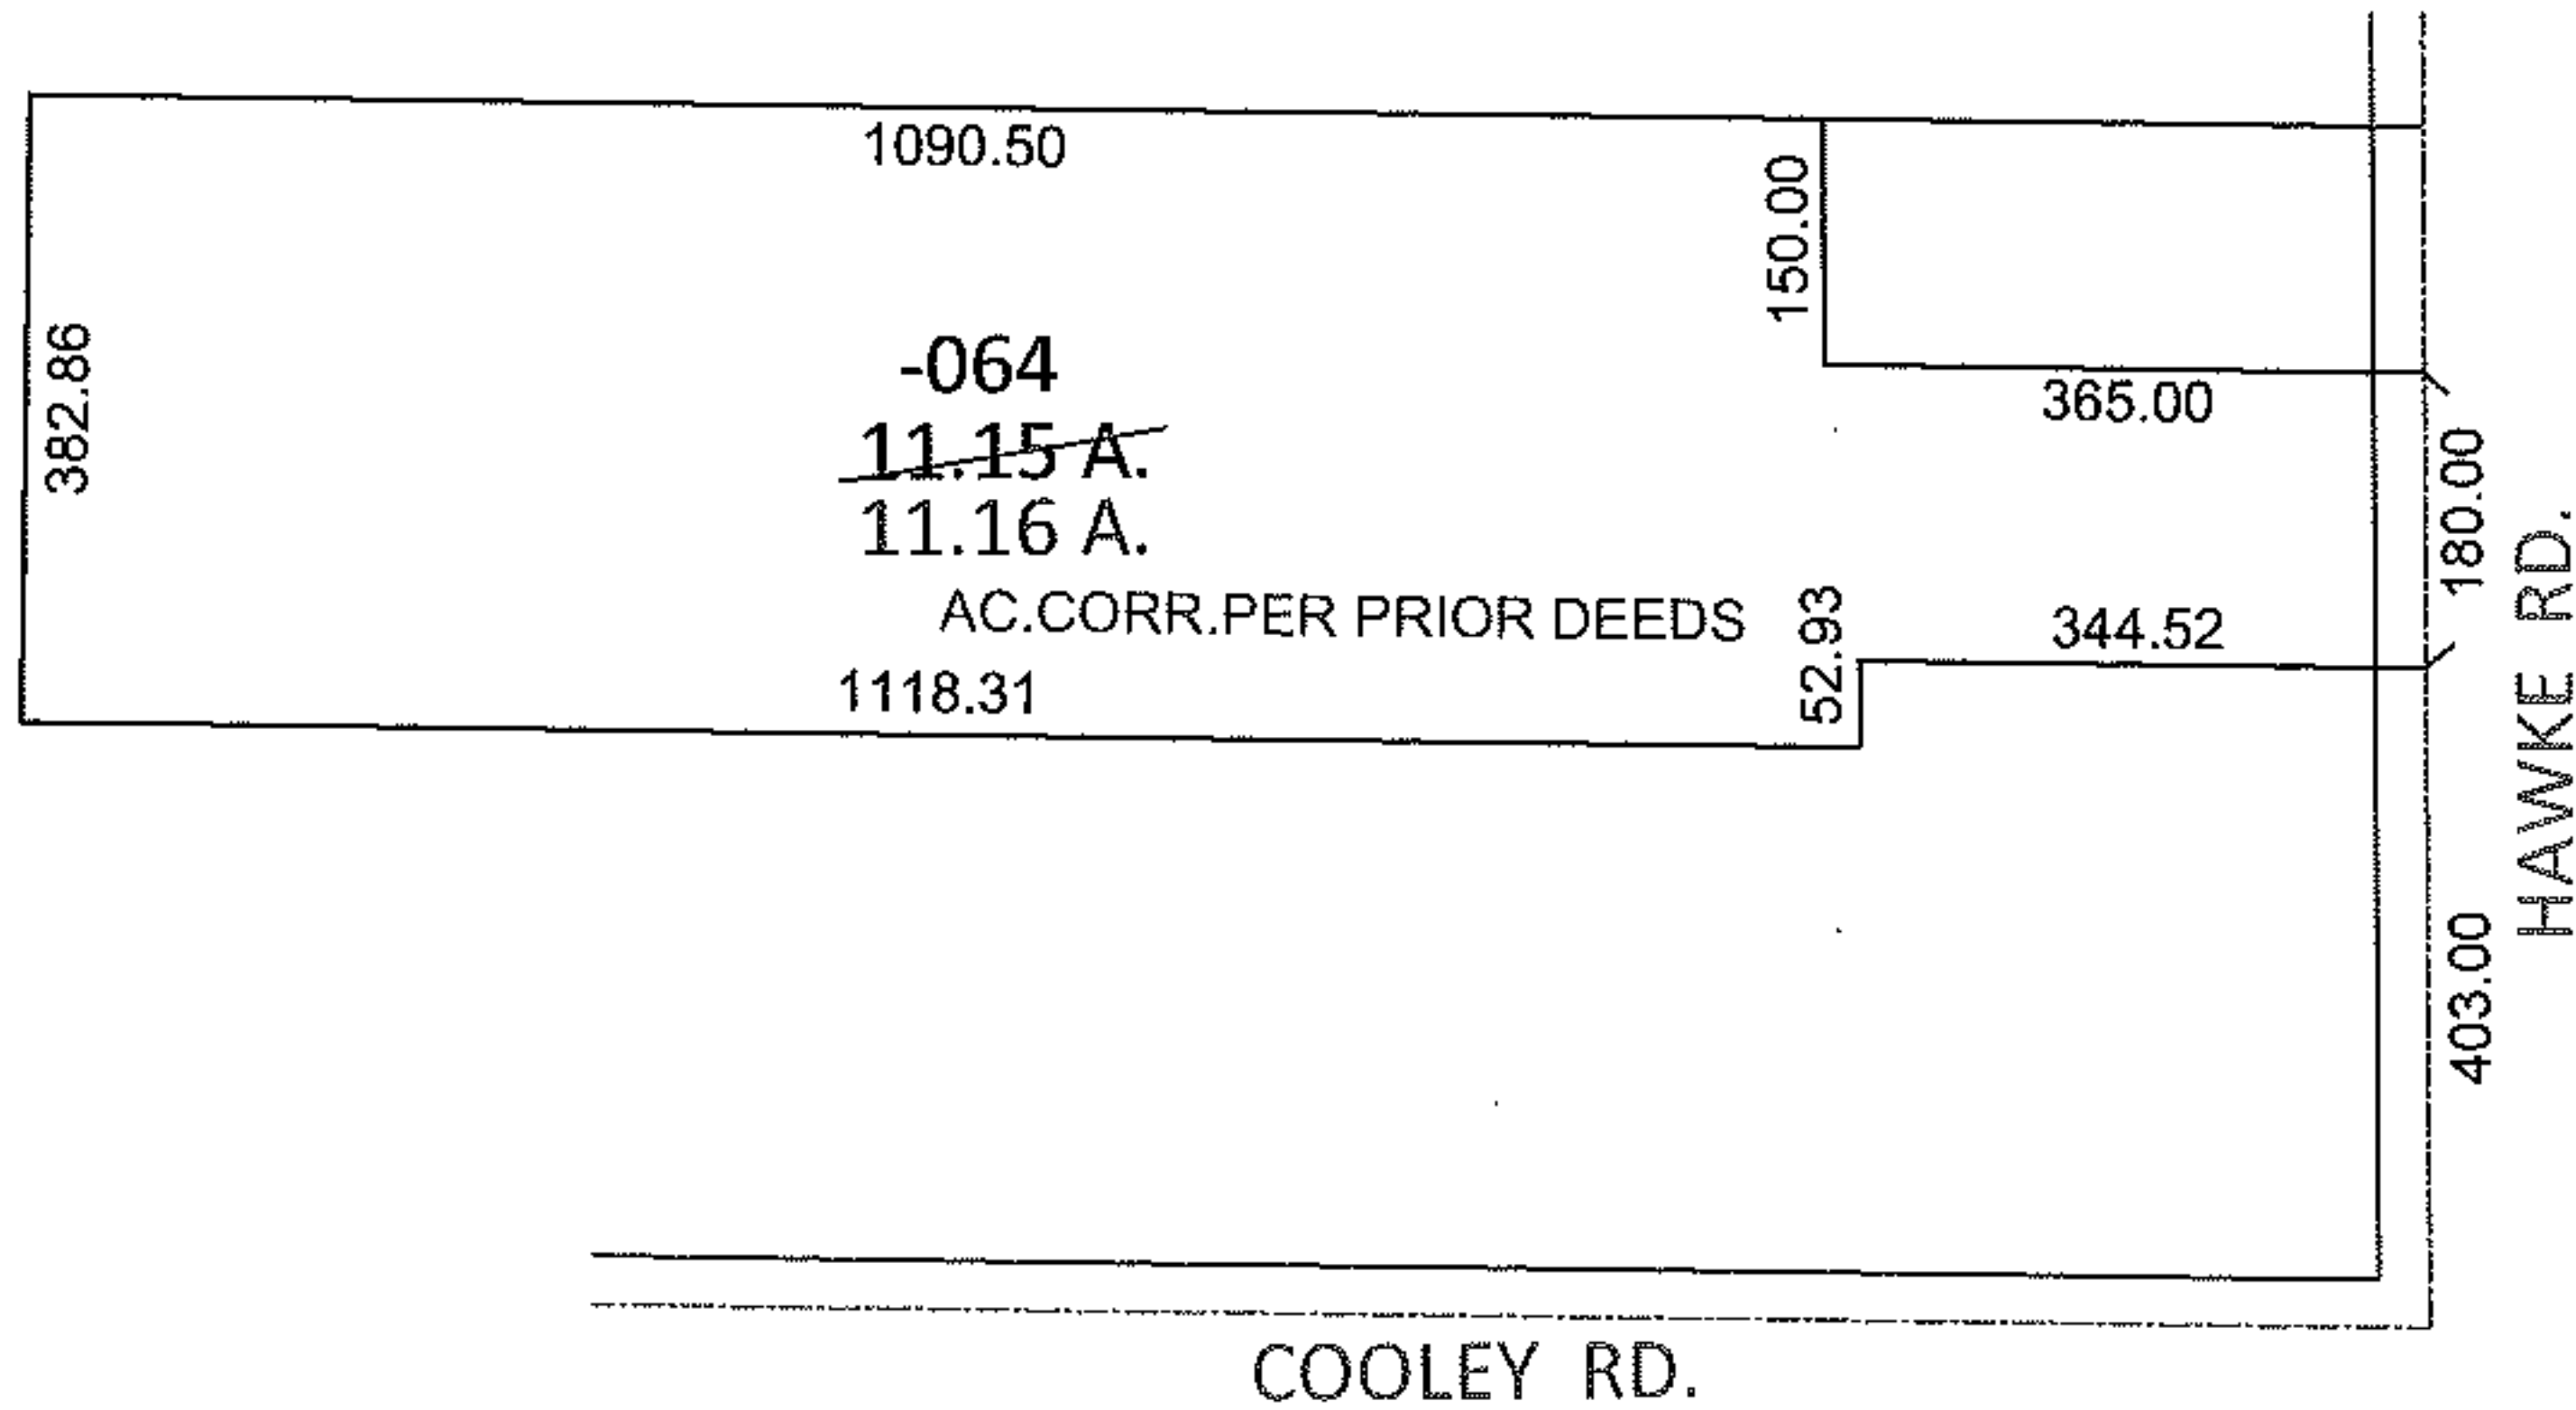


PARENT PARCEL: 11-00-008-000-064

CHILD PARCEL: _____

STARTING POINT: INTERSECTION OF C/L OF COOLEY RD. AND C/L OF HAWKE RD.

12-02420-A

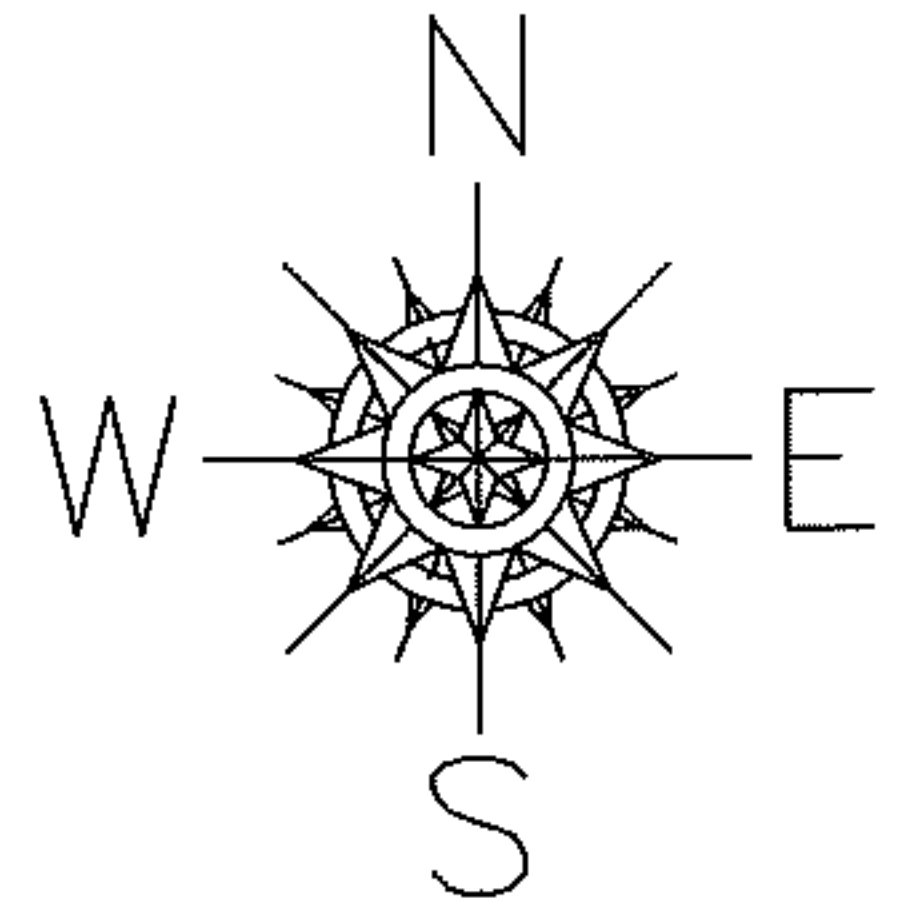

SPLITS/DEEDS PROCESSED

LORAIN COUNTY TAX MAP DEPARTMENT
226 MIDDLE AVE. ELYRIA, OHIO

SURVEYED BY: N/A

CLOSURE: .01:10,000

MAP PAGE(S): 11-00-008-B

APPROVED BY: RRM DATE: 1-9-12

SCALE: 1" = 300 PRIOR INST.: OR 1331/214