
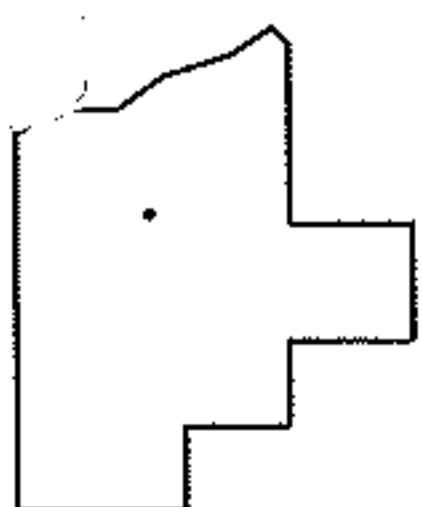
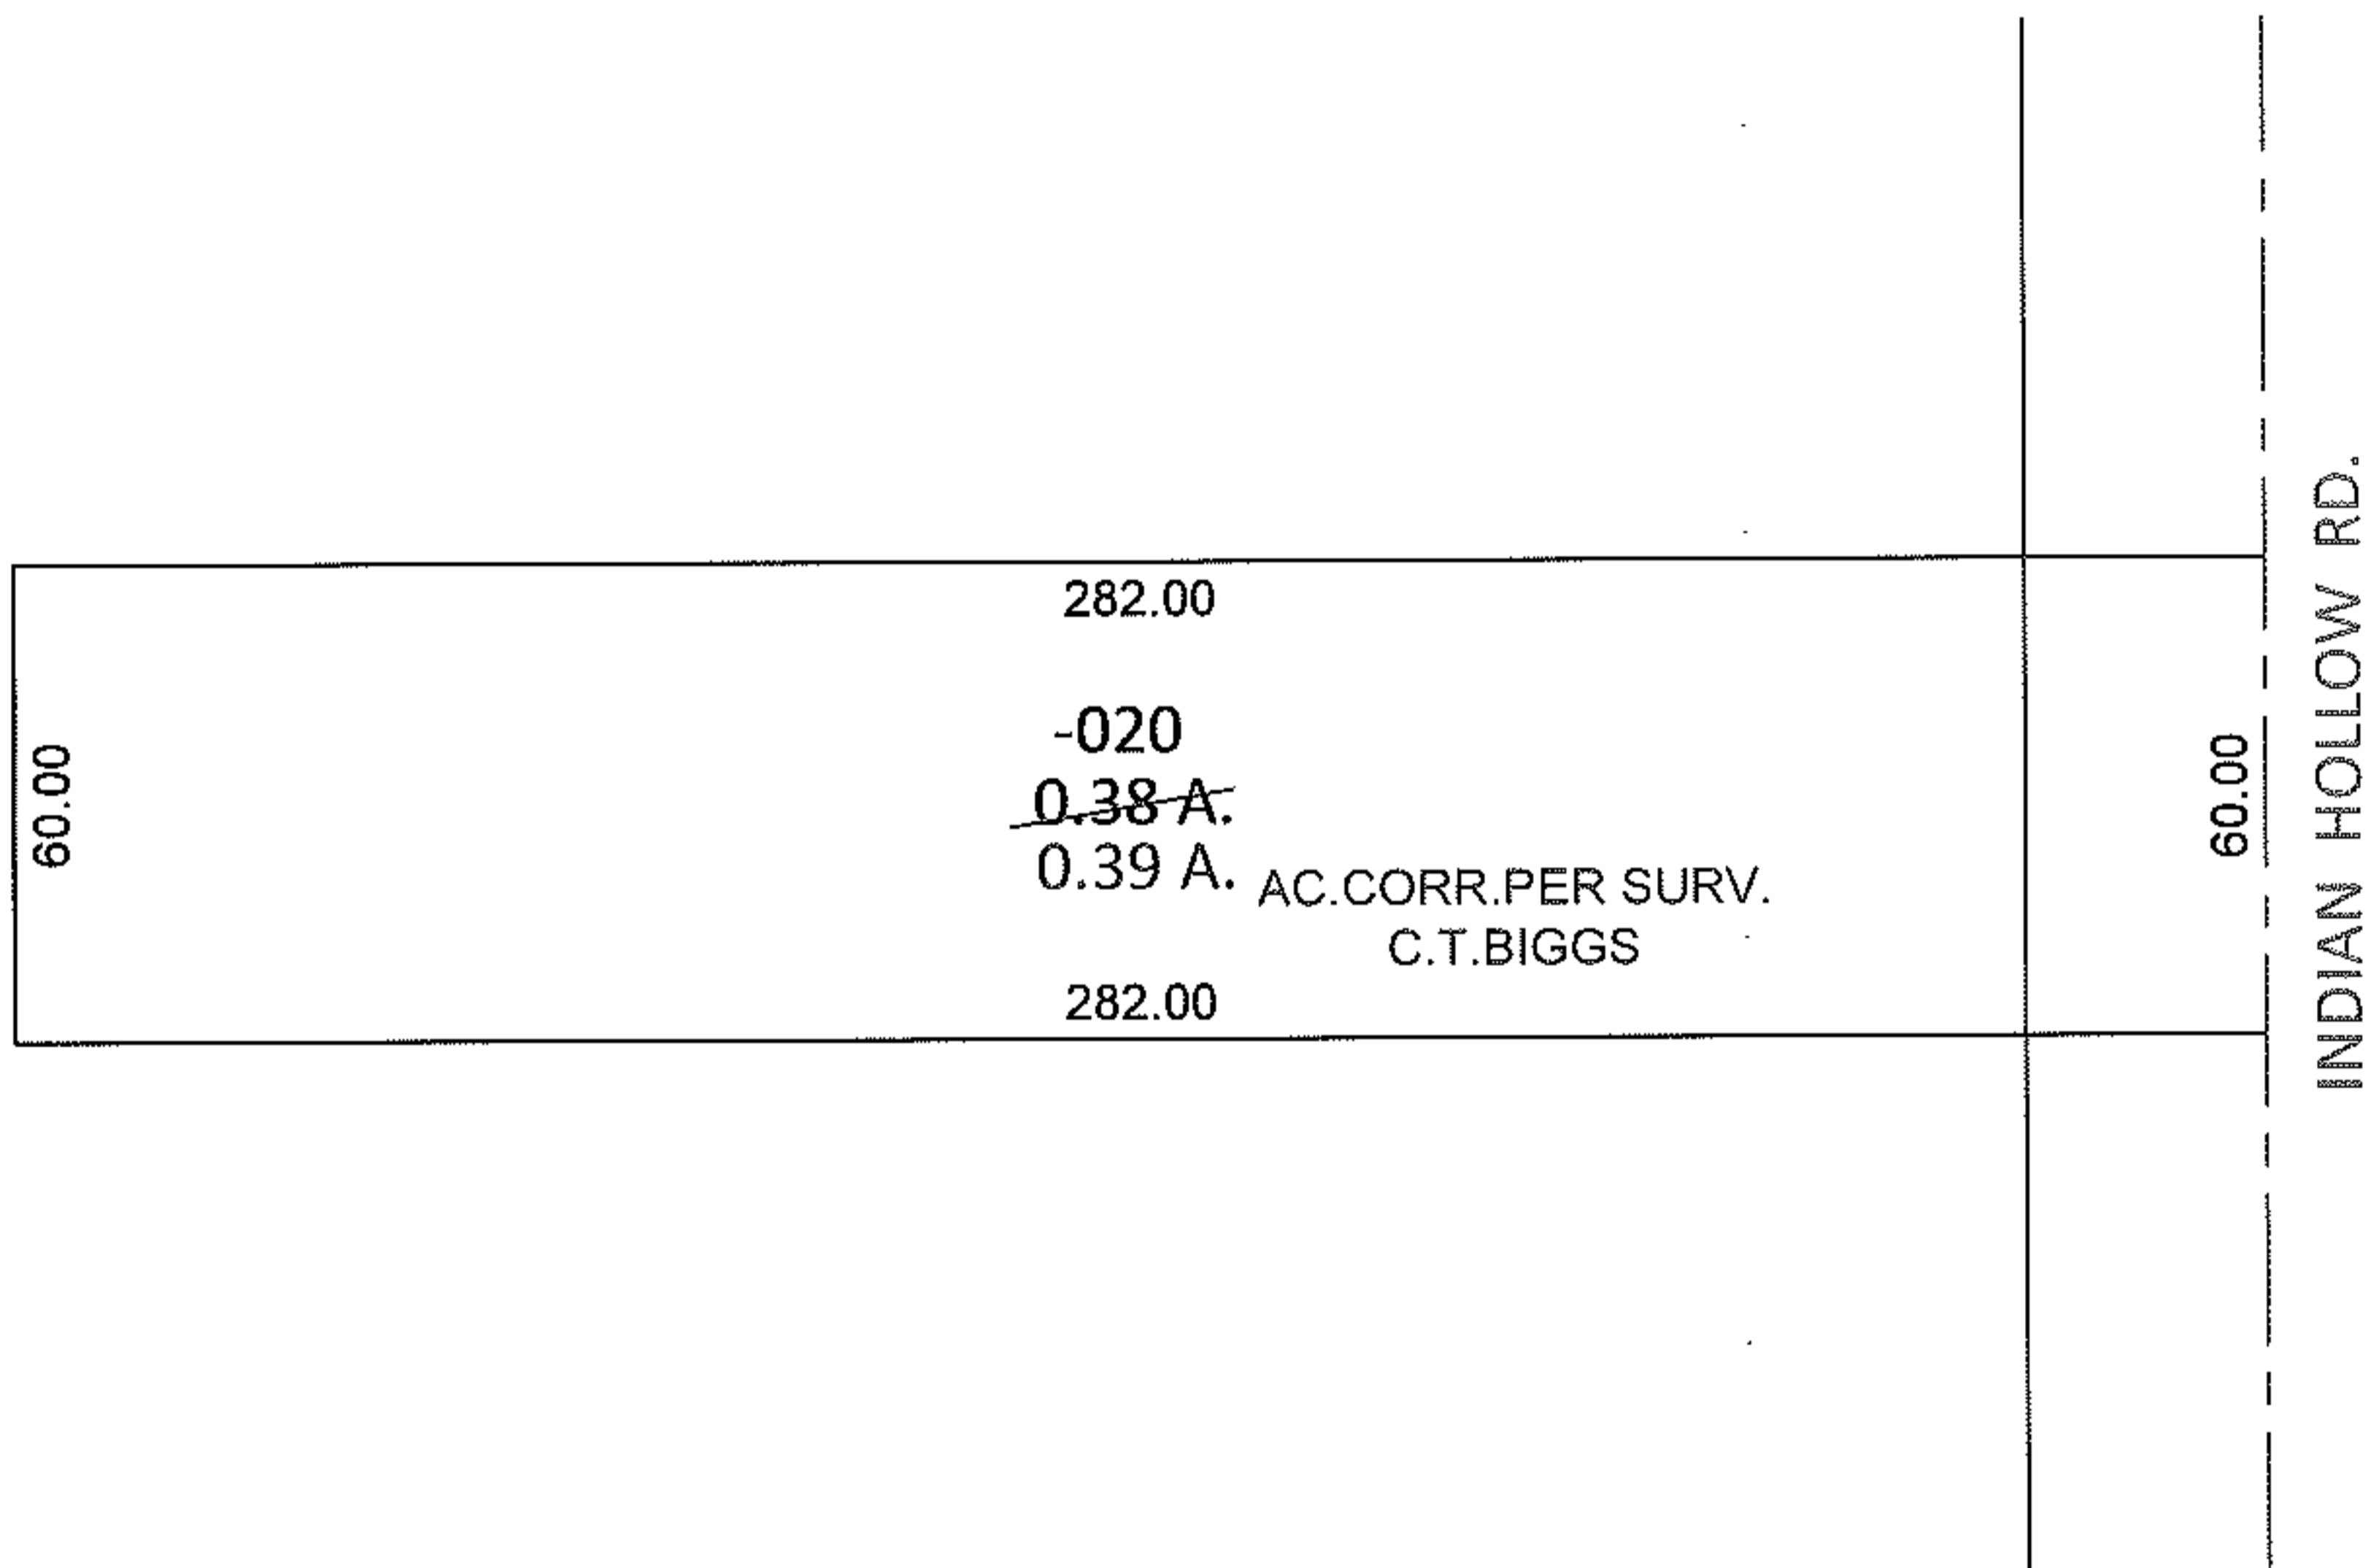


PARENT PARCEL: 10-00-004-127-020

12-02421-A

CHILD PARCEL: _____

STARTING POINT: SOUTHEAST CORNER OF LAND CONVEYED TO MAYNARD L. & NORMA HUENE (DV 284/379)

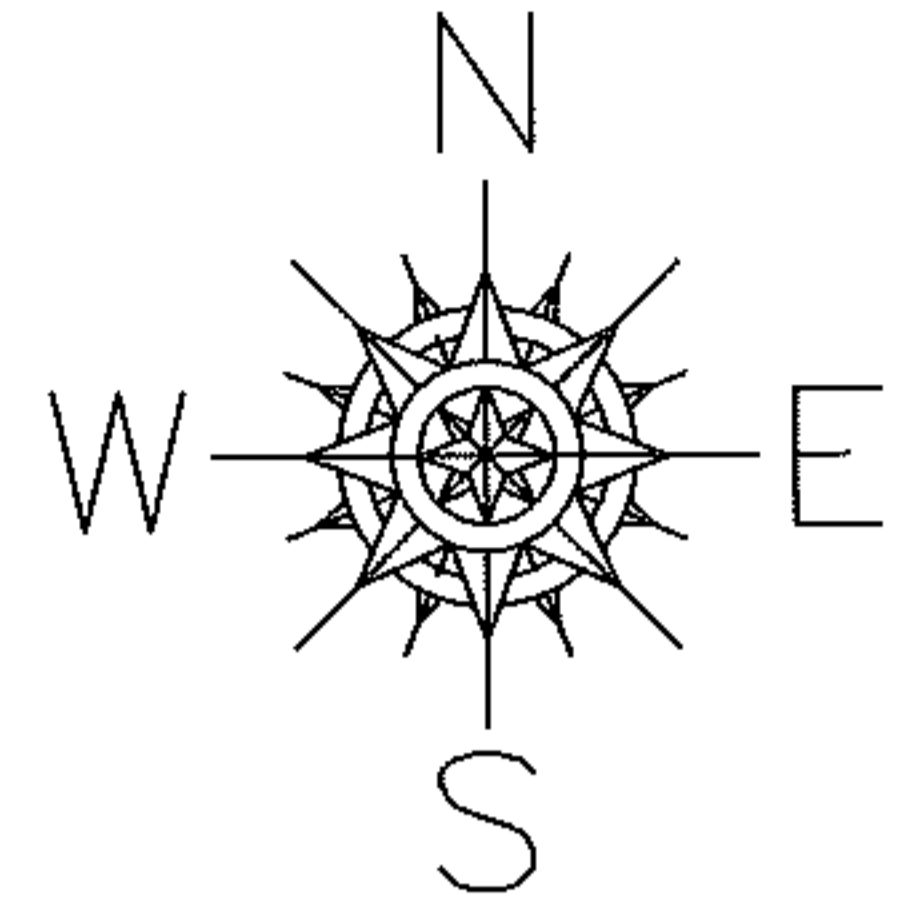

SPLITS/DEEDS PROCESSED

LORAIN COUNTY TAX MAP DEPARTMENT
226 MIDDLE AVE. ELYRIA, OHIO

SURVEYED BY: C.T. BIGGS

CLOSURE: N/A

MAP PAGE(S): 10-00-004-H

APPROVED BY: RRM DATE: 1-9-12

SCALE: 1"= 50' PRIOR INST.: OR 1343/493