
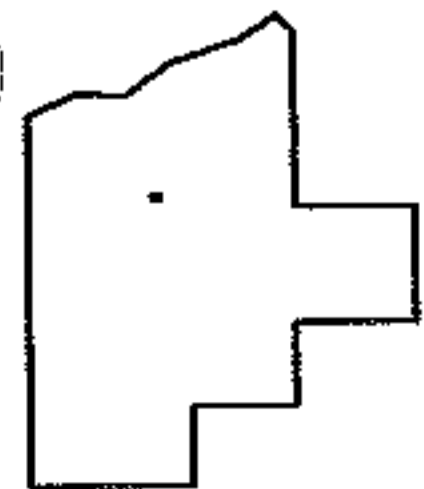
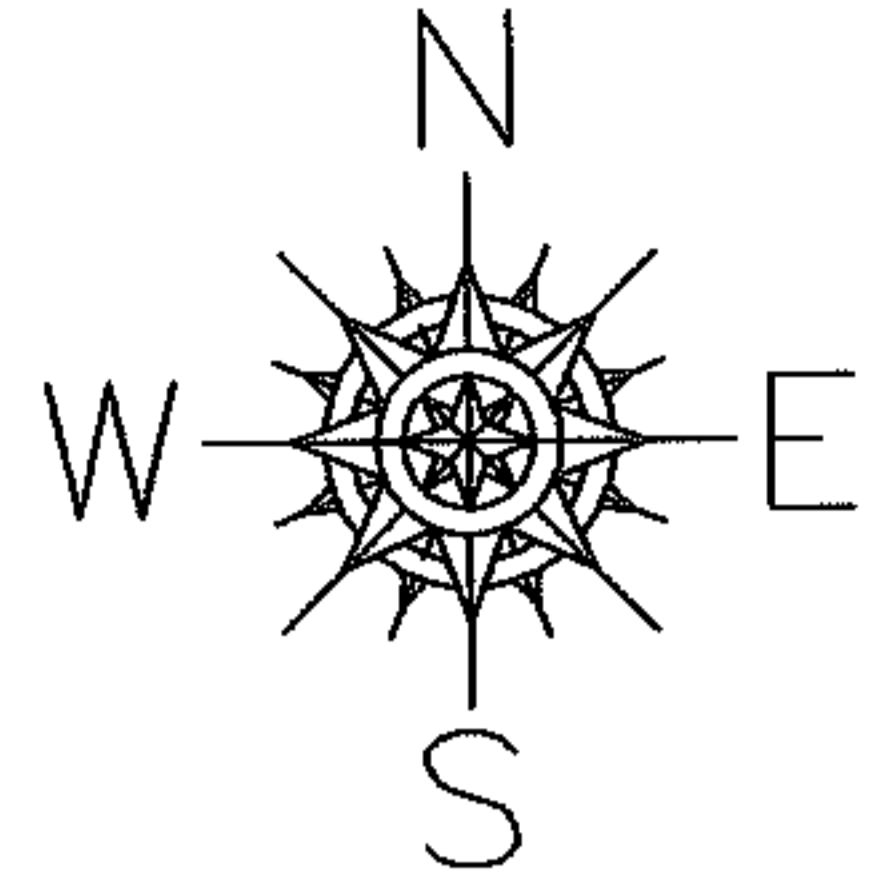


PARENT PARCEL: 04-00-013-000-487

CHILD PARCEL: 04-00-013-000-562, 563

STARTING POINT: CENTERLINE OF AVON BELDEN RD & MILLS RD

07-02425

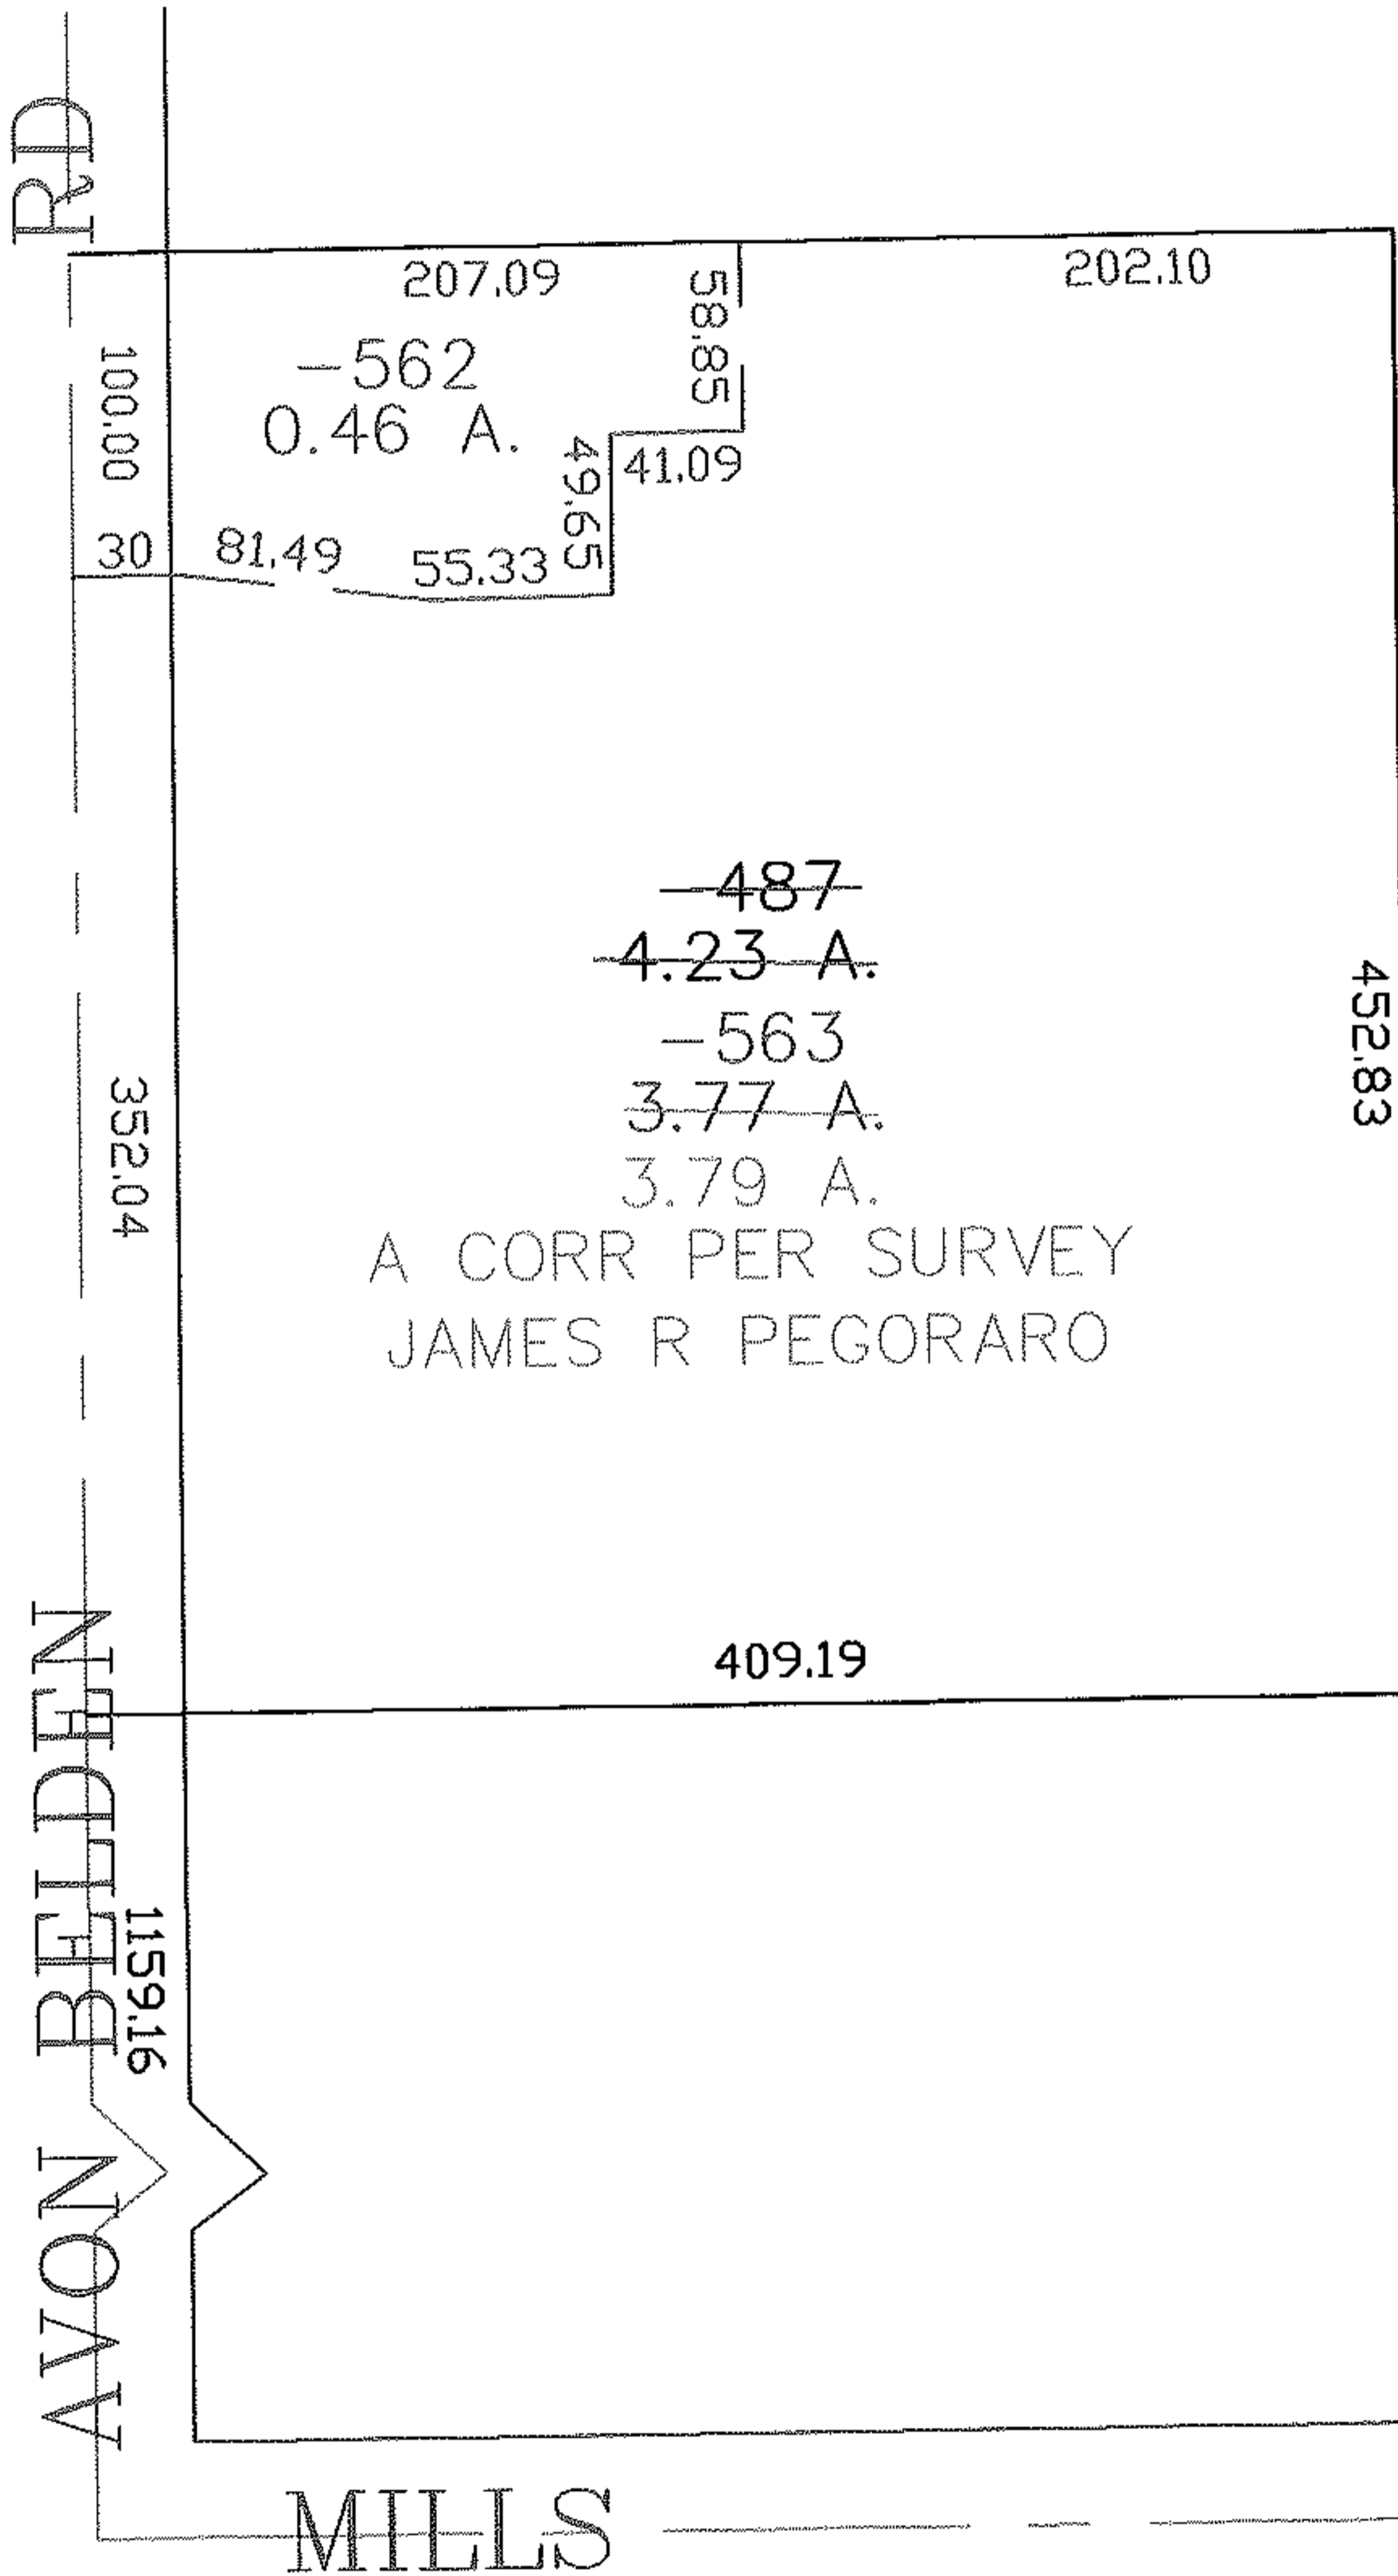

SPLITS/DEEDS PROCESSED

LORAIN COUNTY TAX MAP DEPARTMENT
226 MIDDLE AVE. ELYRIA, OHIO

SURVEYED BY: JAMES R PEGORARO

CLOSURE: 0.00 : 10.000

MAP PAGE(S): 04-00-013-G

APPROVED BY: JAH DATE: 7-19-07

SCALE: 1" = 100' PRIOR INSTRUMENT: 20010787652