



RASTER

PARENT PARCEL: 03-00-029-104-002

CHILD PARCEL: _____

STARTING POINT: ALL OF S/L 92 & PT. OF S/L'S 93 & 91 IN BLOCK D OF KNICKERBOCKER SUB. NO.2 (VOL.12 PG.16)

12-02426-C

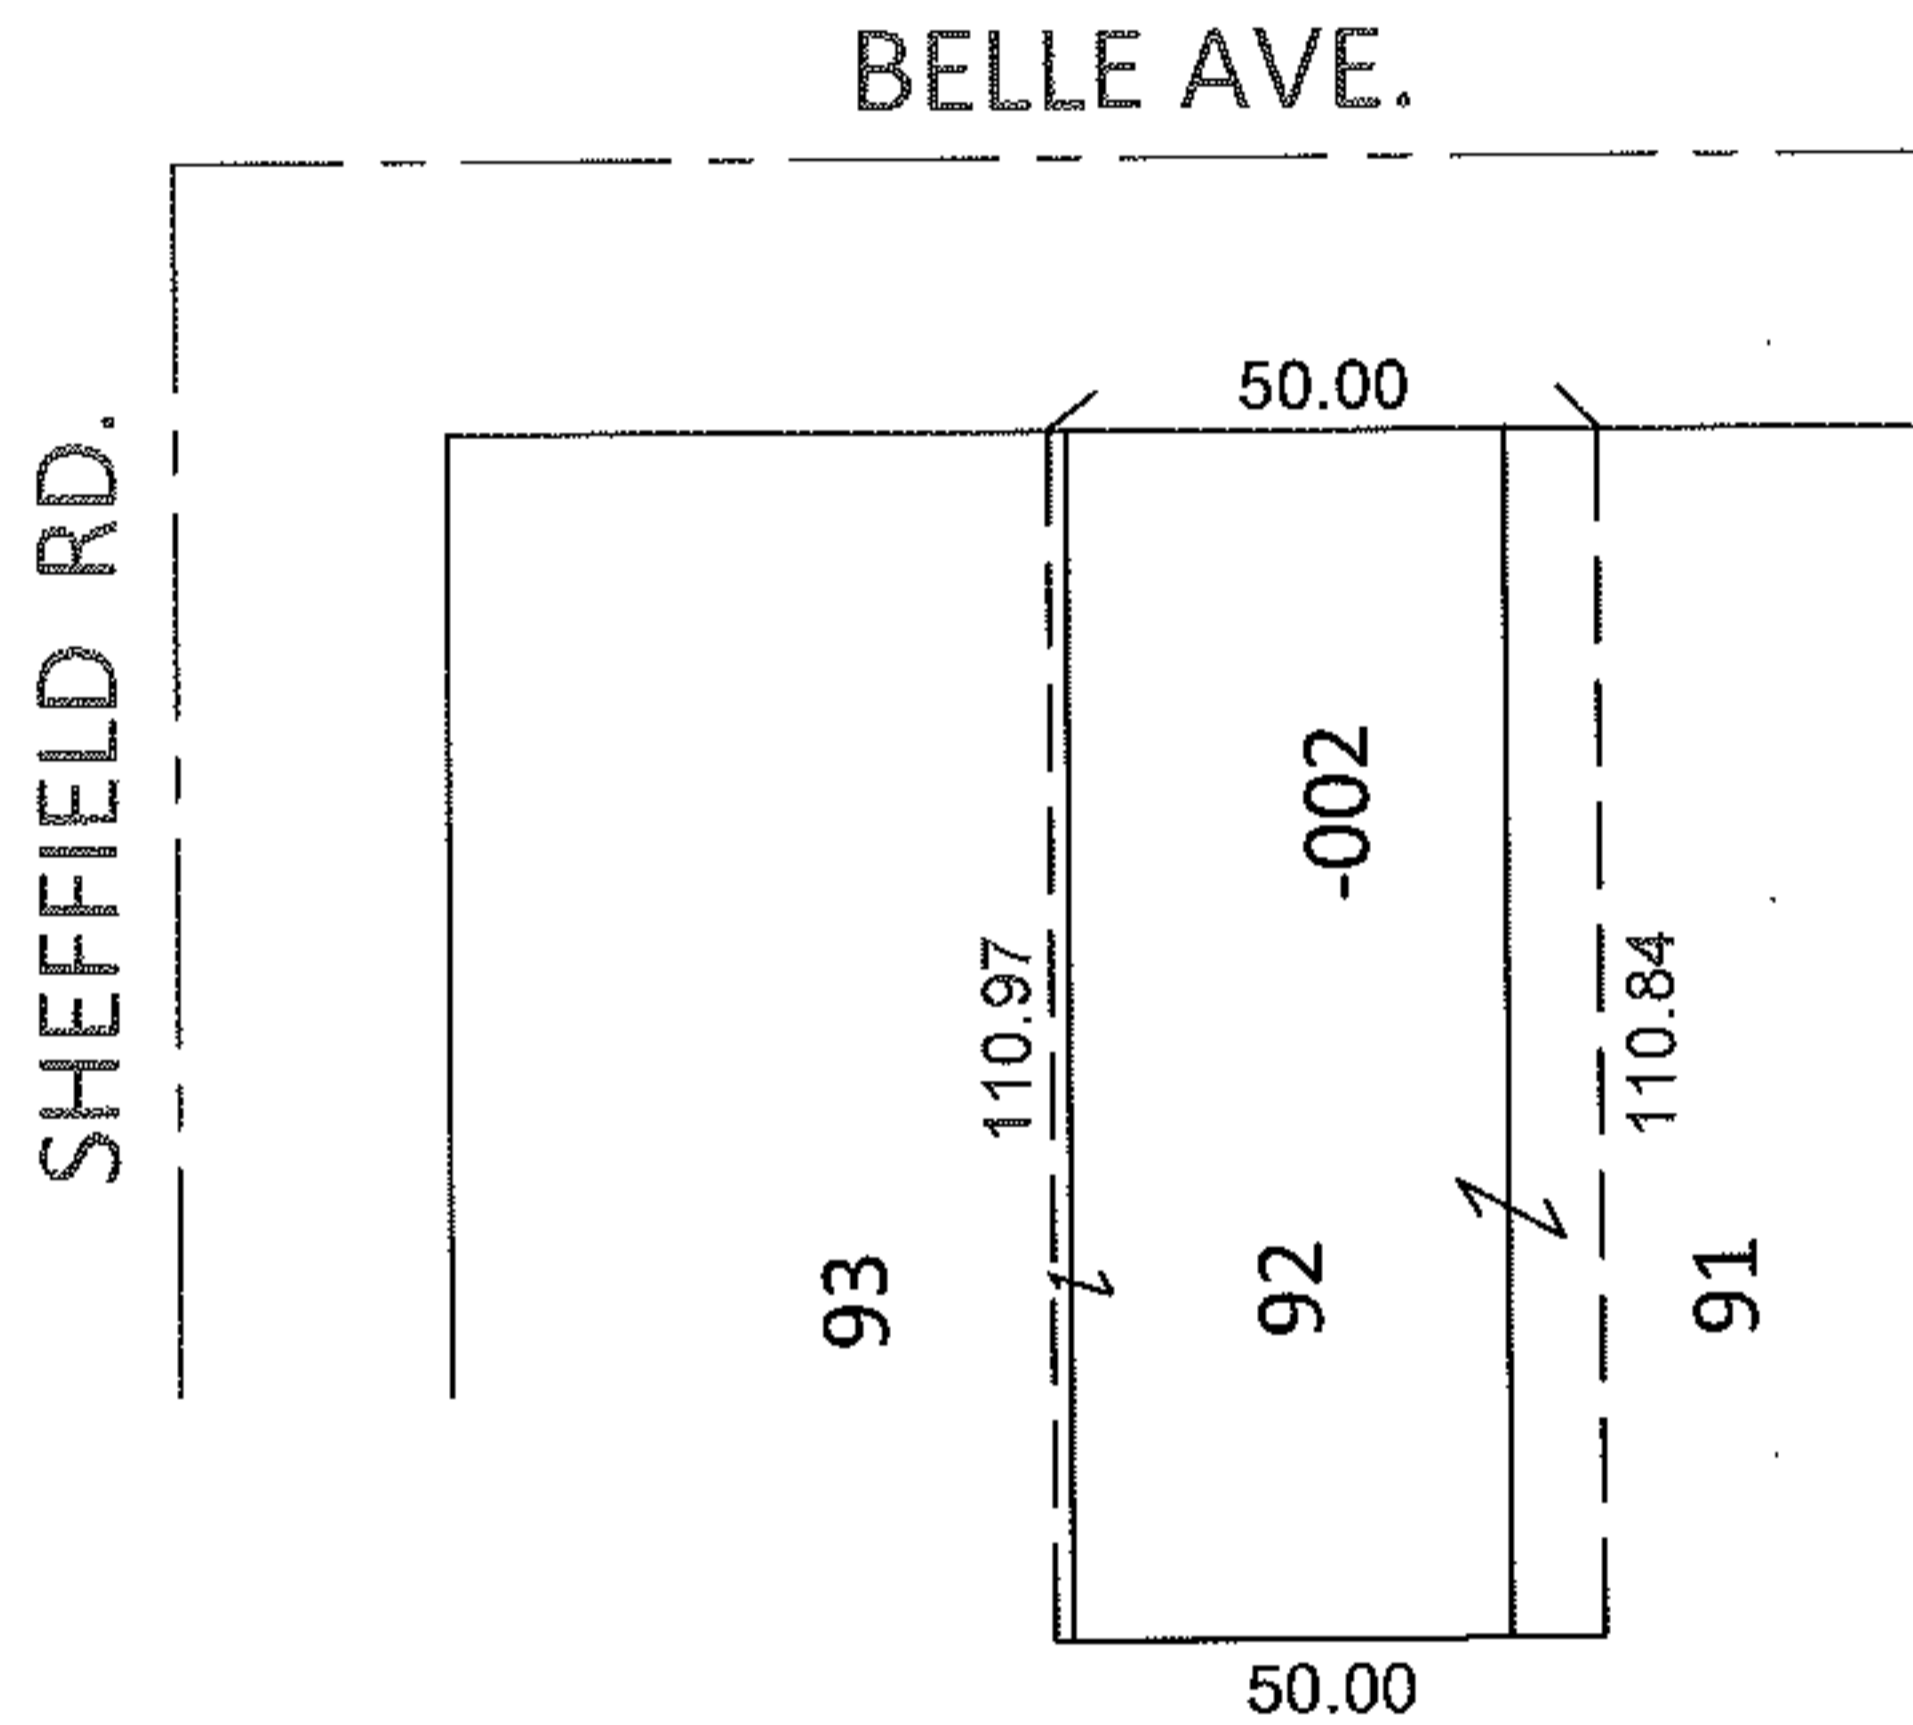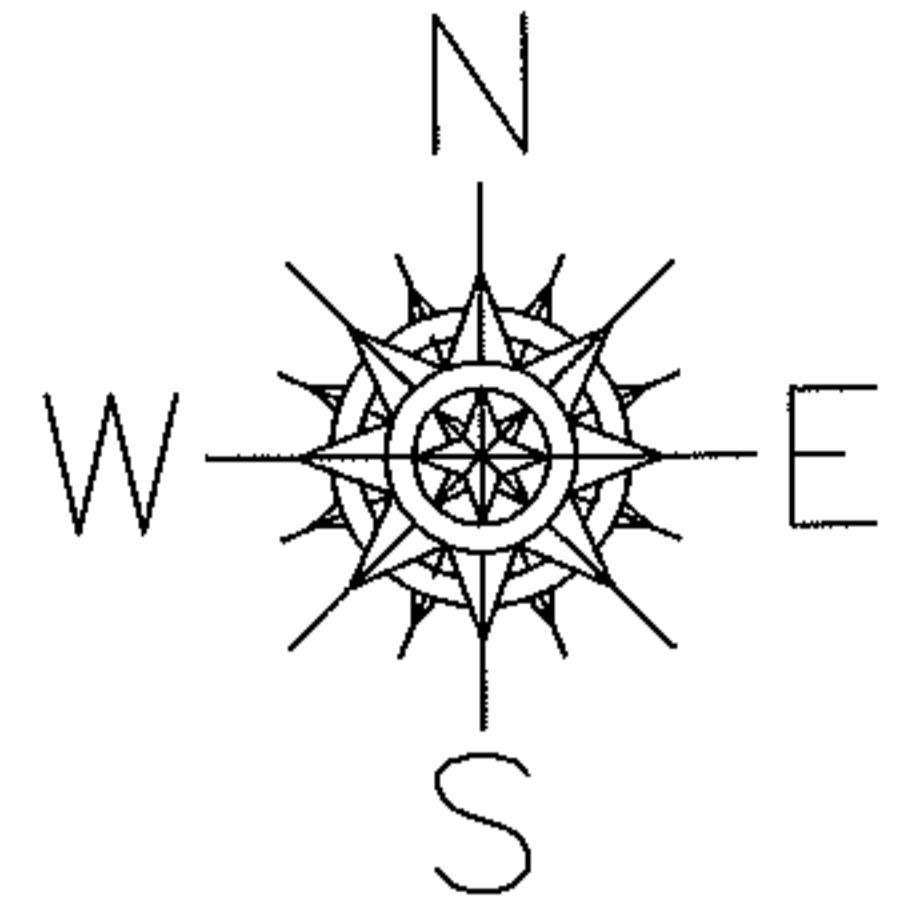


DEPTH CORRECTION

03-00-029-104-002

110.97

50 X ~~111~~

PER PRIOR DEEDS

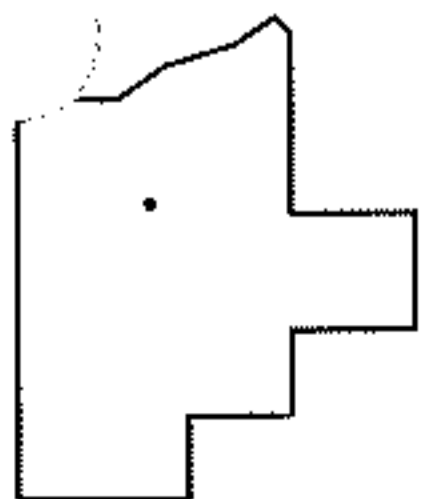

SPLITS/DEEDS PROCESSED

LORAIN COUNTY TAX MAP DEPARTMENT
226 MIDDLE AVE. ELYRIA, OHIO

SURVEYED BY: N/A

CLOSURE: N/A

MAP PAGE(S): 3-00-029-B

APPROVED BY: RRM DATE: 1-10-12

SCALE: 1" = 50' PRIOR INST.: OR 1144/454