




RASTER

PARENT PARCEL: 05-00-057-000-361, -362

CHILD PARCEL: 05-00-057-000-363, -364

STARTING POINT: SIDELINE OF MIDDLE RIDGE RD & HIDDEN VALLEY RD

07-02427

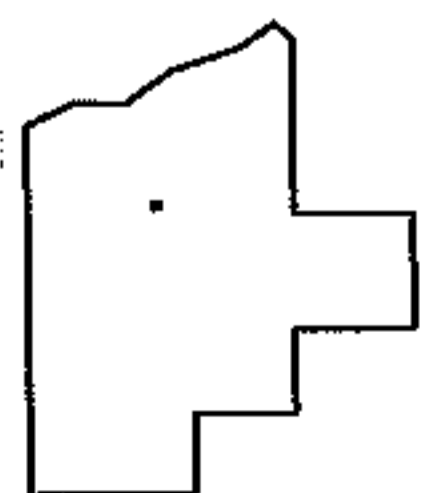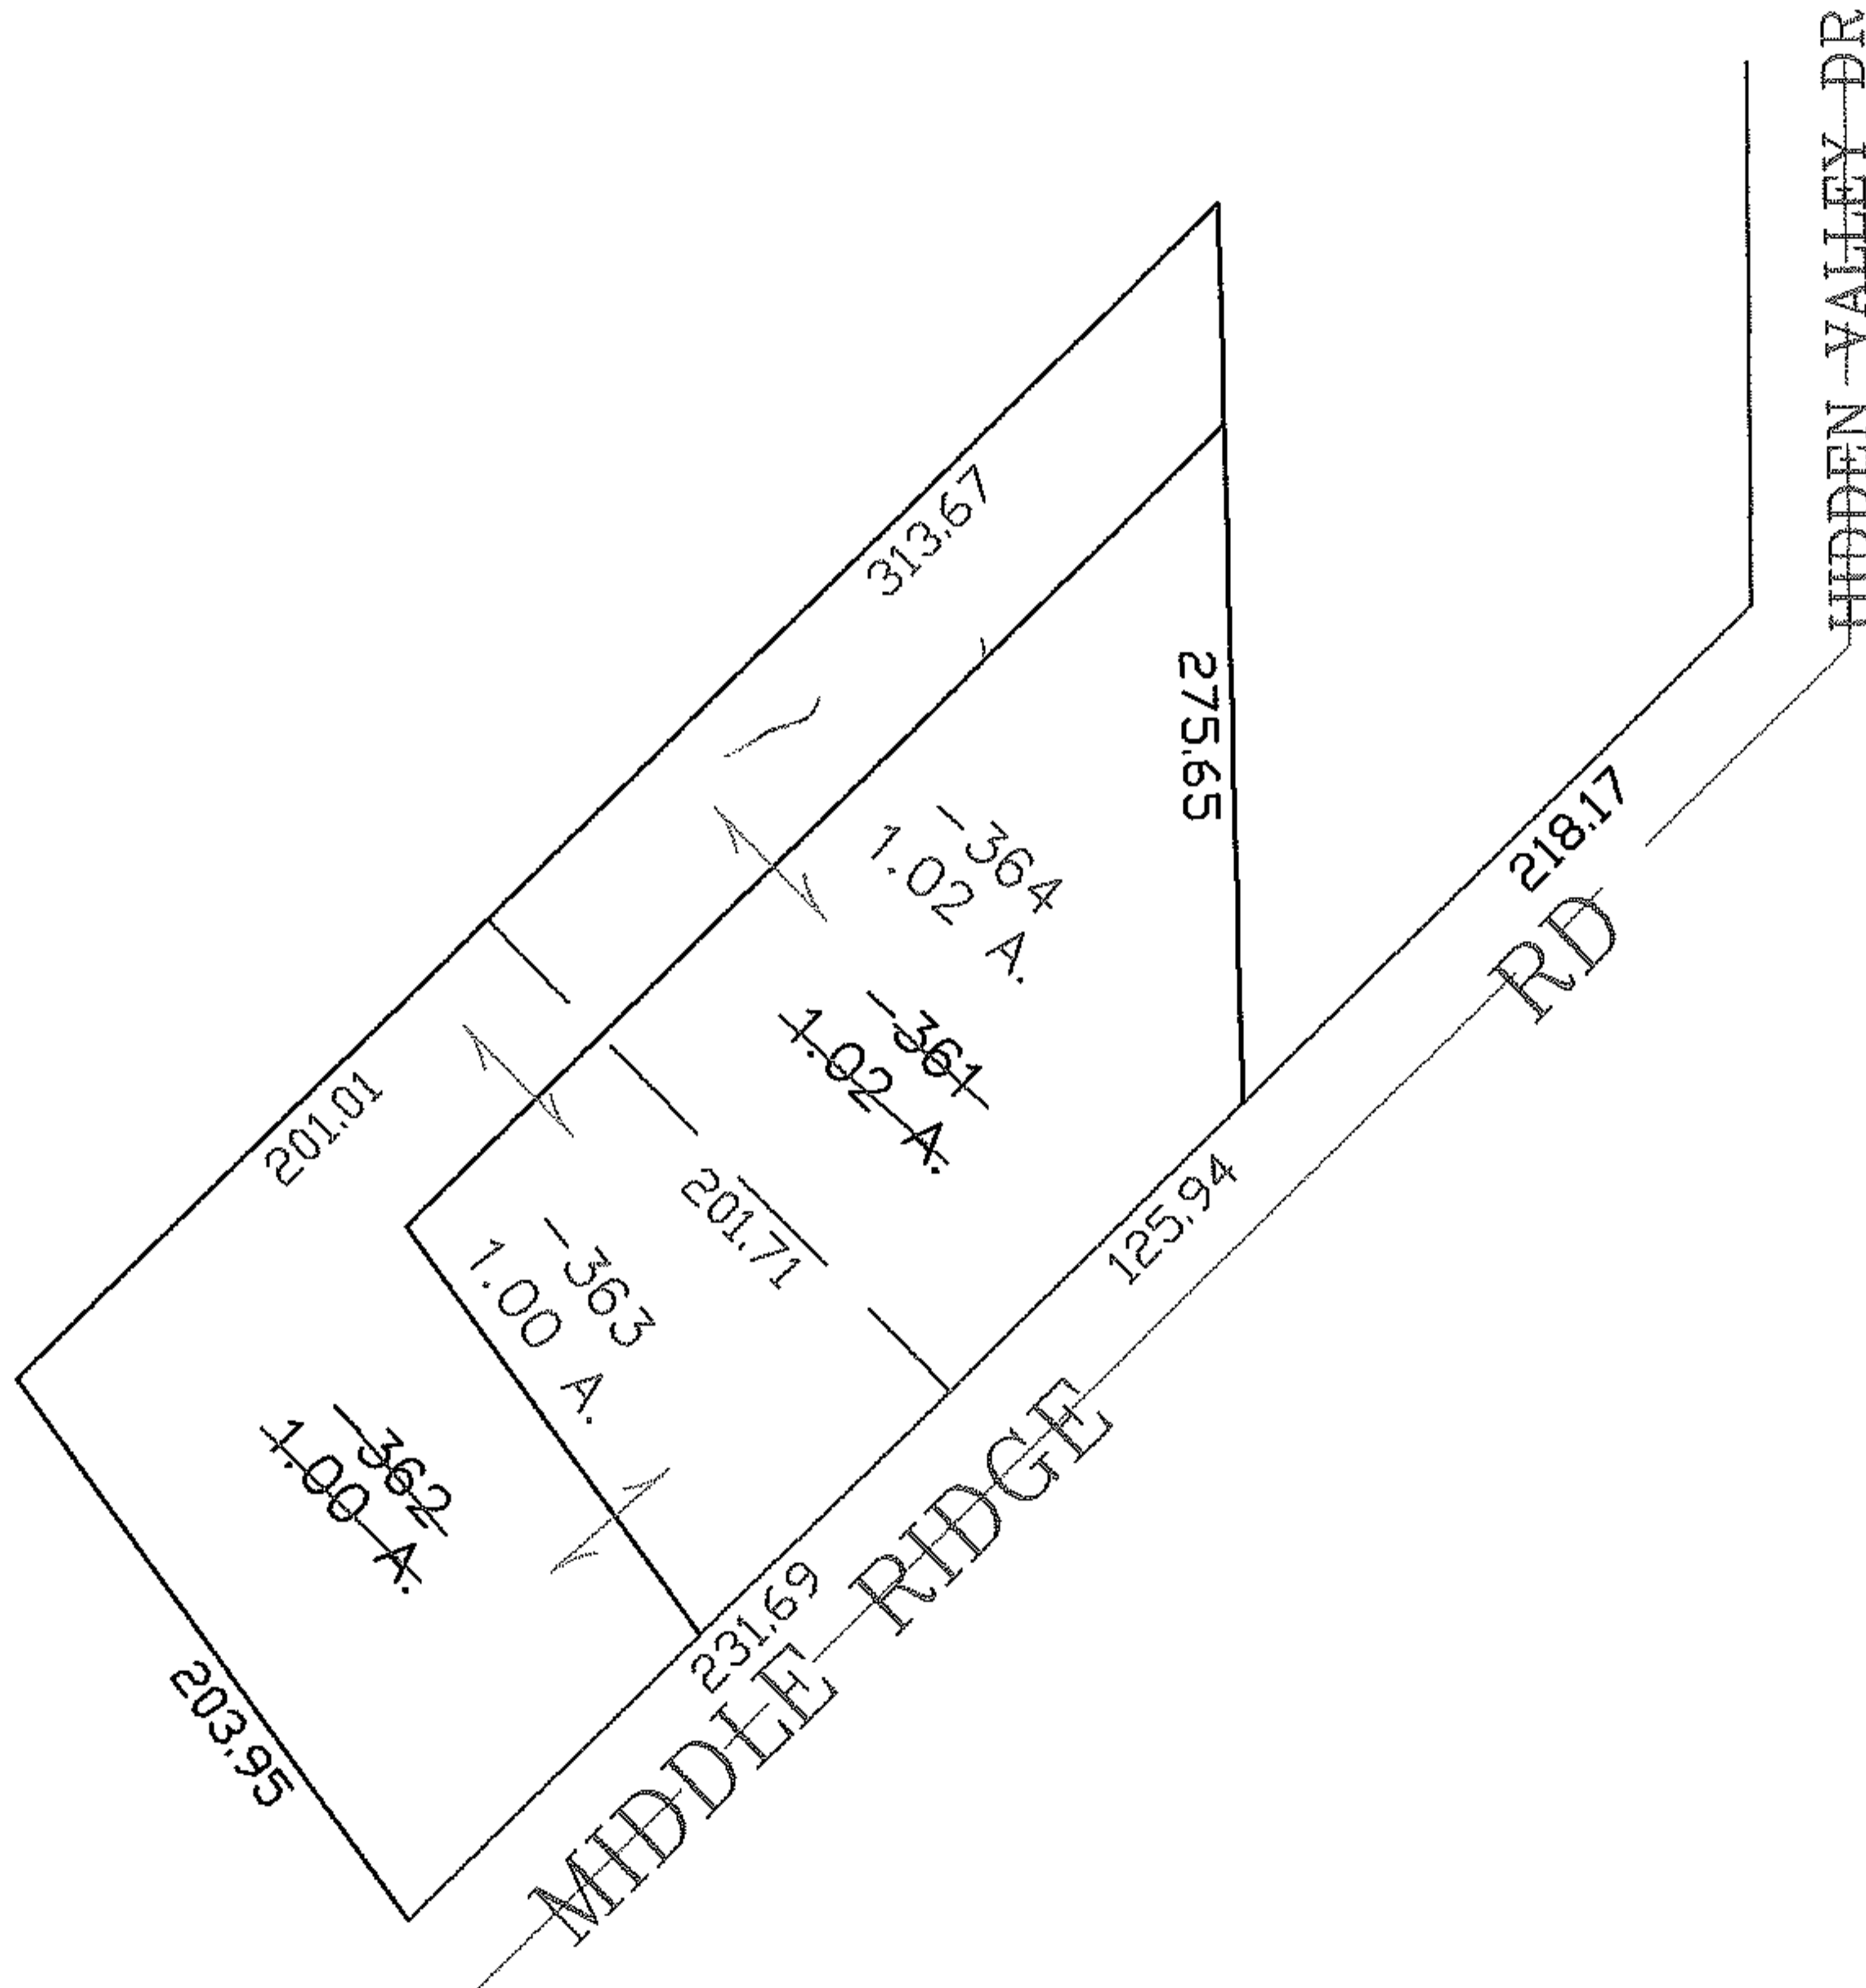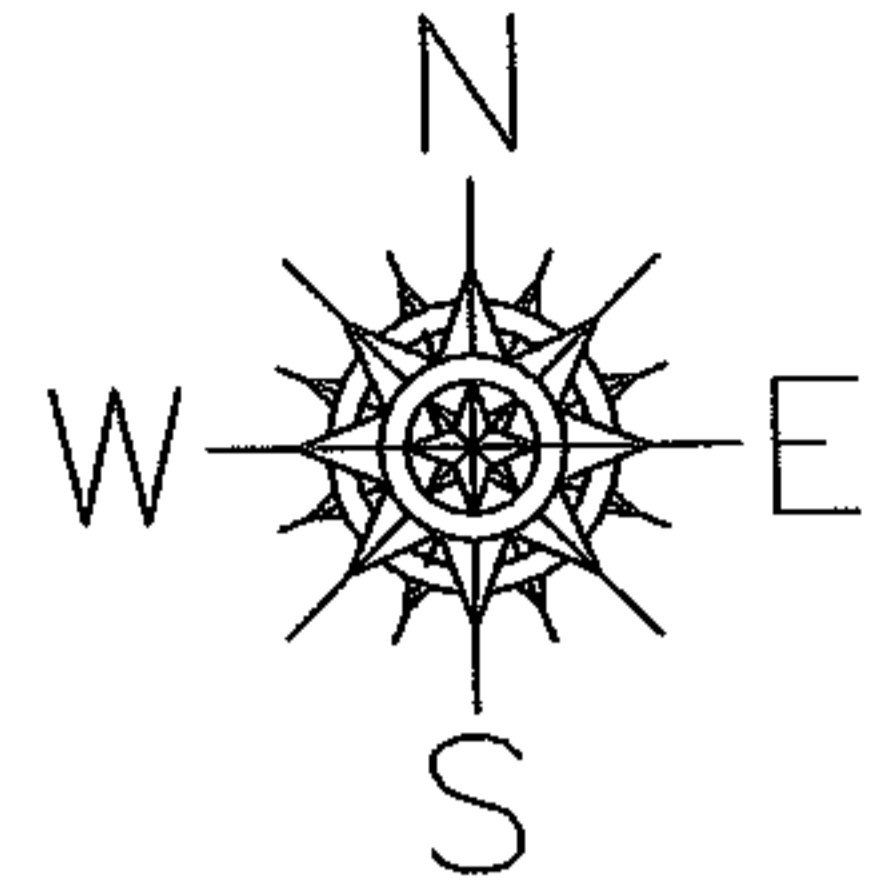

SPLITS/DEEDS PROCESSED

LORAIN COUNTY TAX MAP DEPARTMENT
226 MIDDLE AVE. ELYRIA, OHIO

SURVEYED BY: DALE HAYWOOD

CLOSURE: 0.00 : 10.000

MAP PAGE(S): 05-00-057-B

APPROVED BY: JAH DATE: 7-23-07

SCALE: 1" = 100 PRIOR INSTRUMENT: 20070206123