
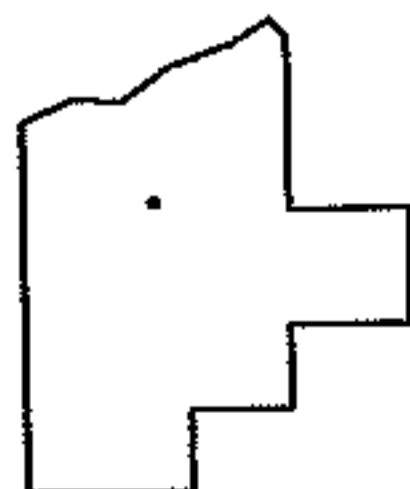
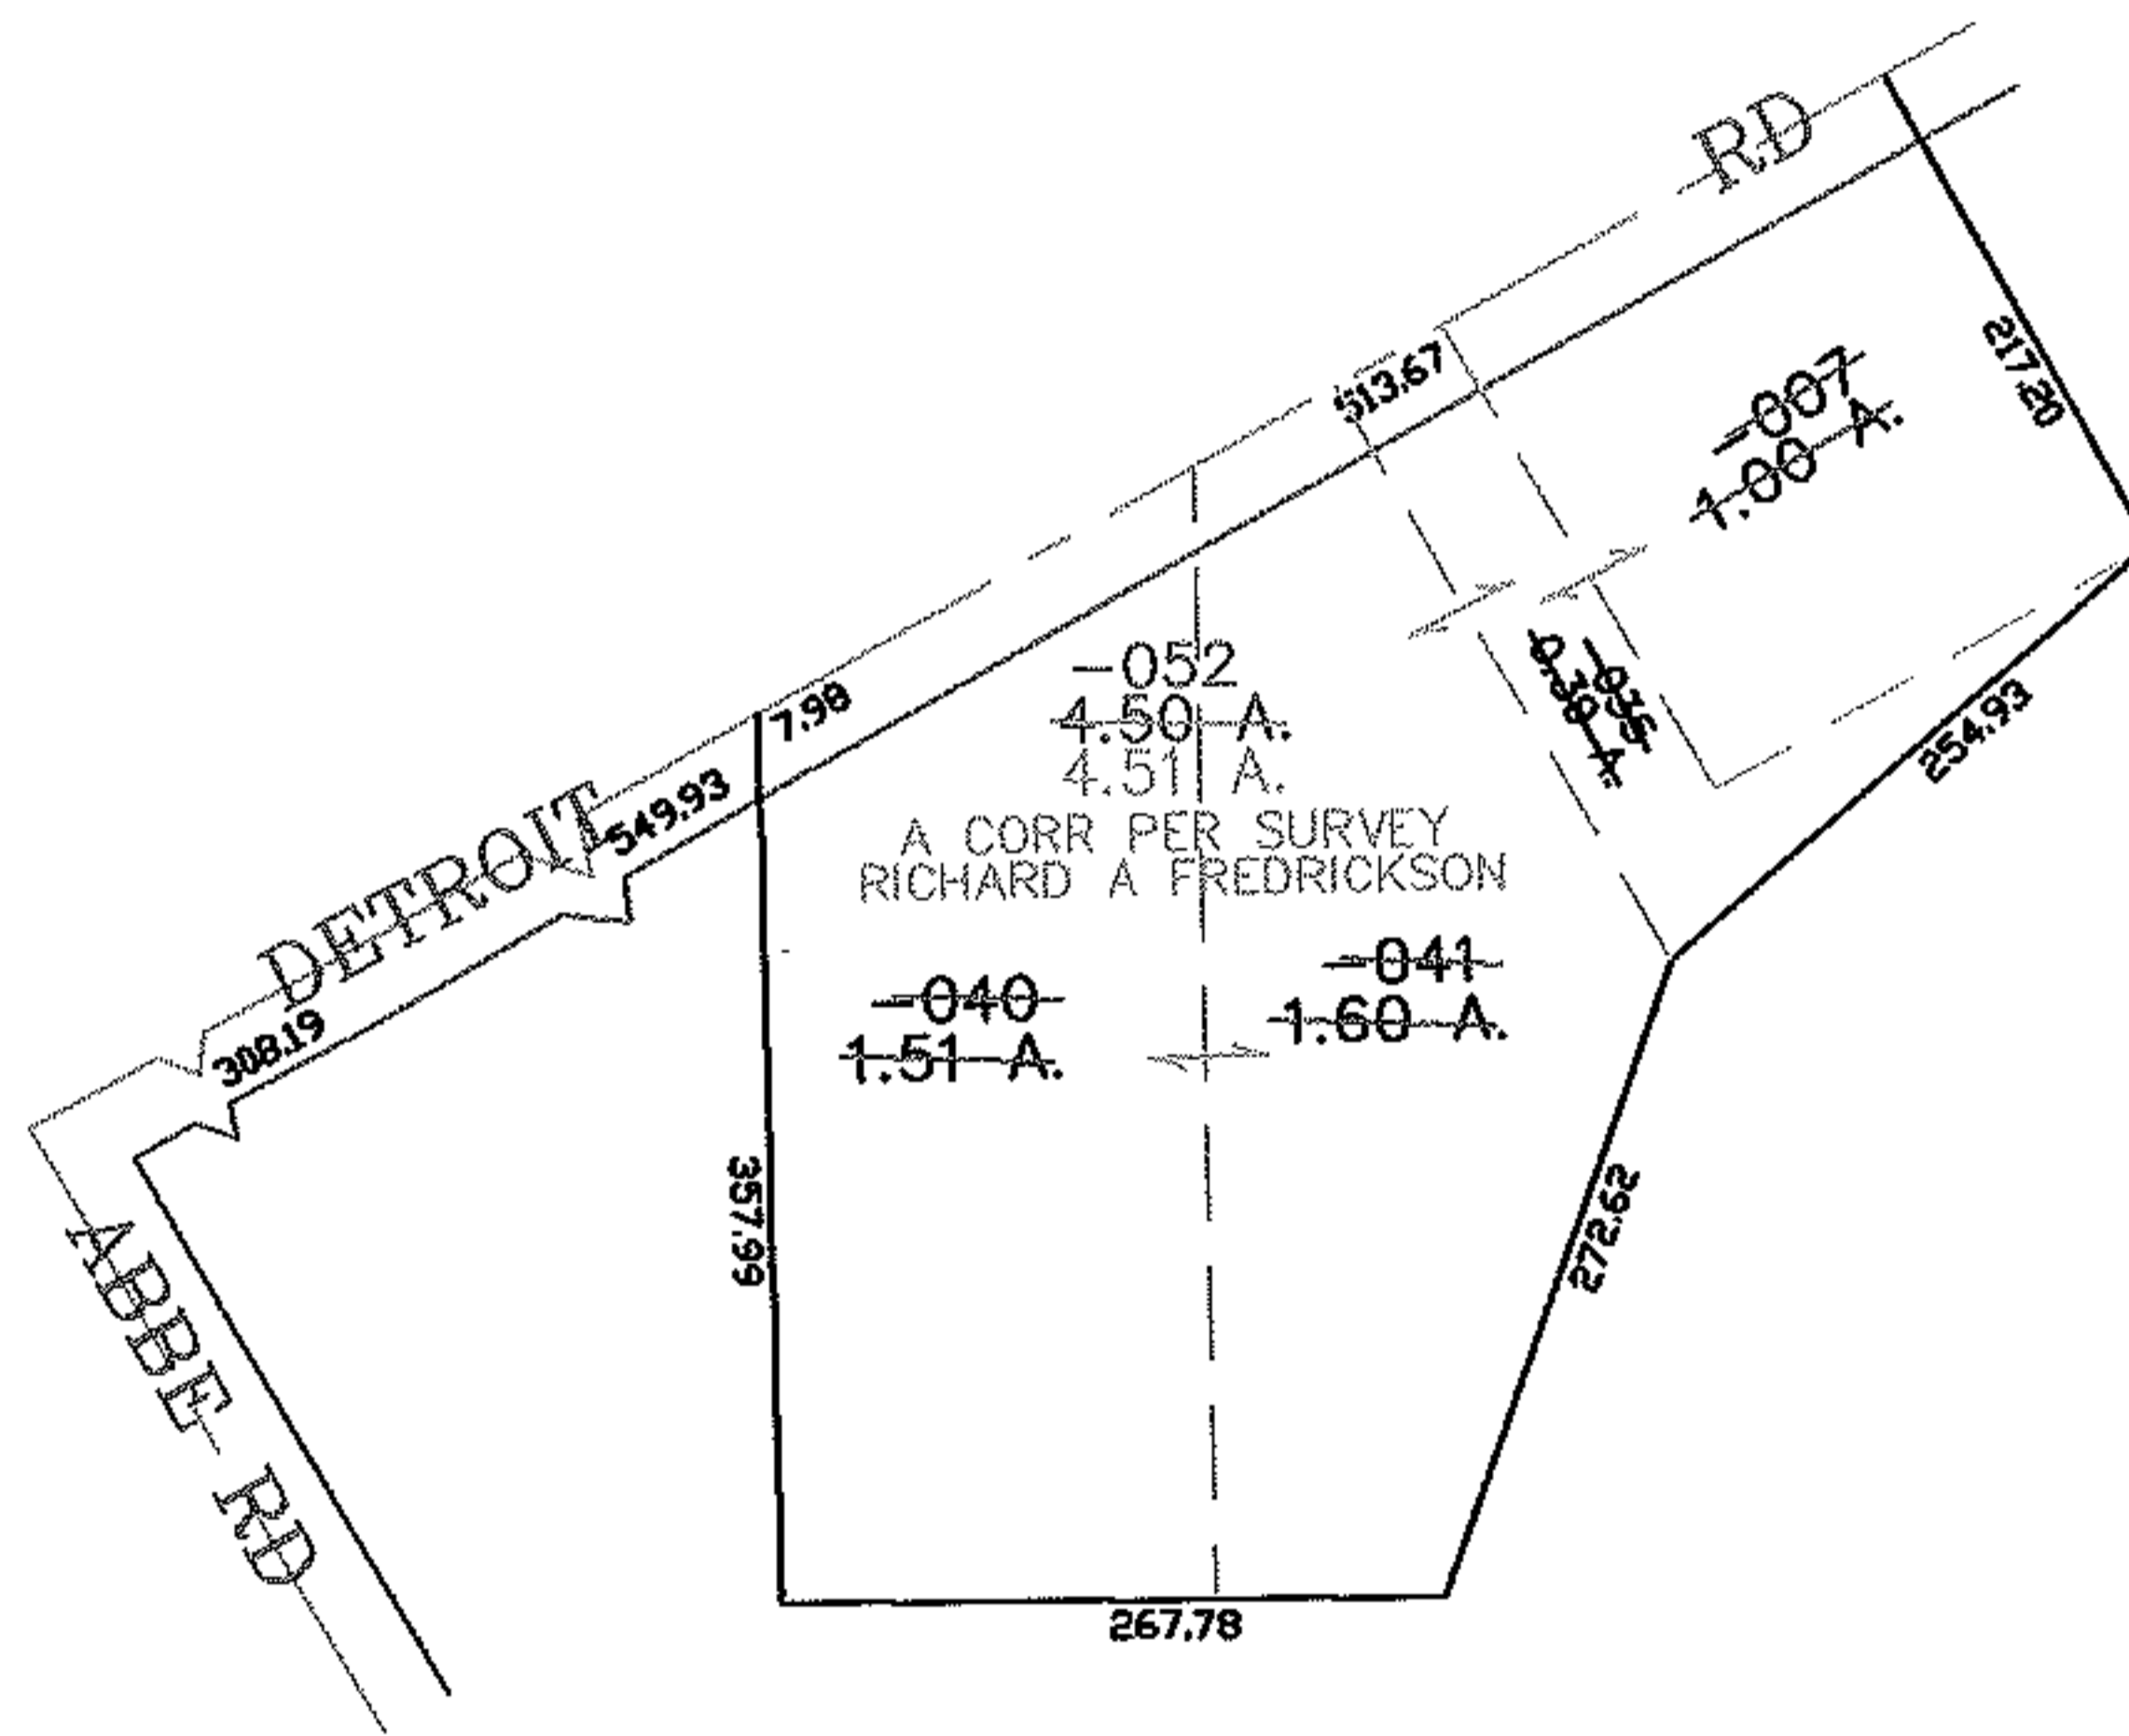


PARENT PARCEL: 03-00-002-102-040, -035, -007, -041

07-02428

CHILD PARCEL: 03-00-002-102-052

STARTING POINT: CENTERLINE OF ABBE RD & DETROIT RD

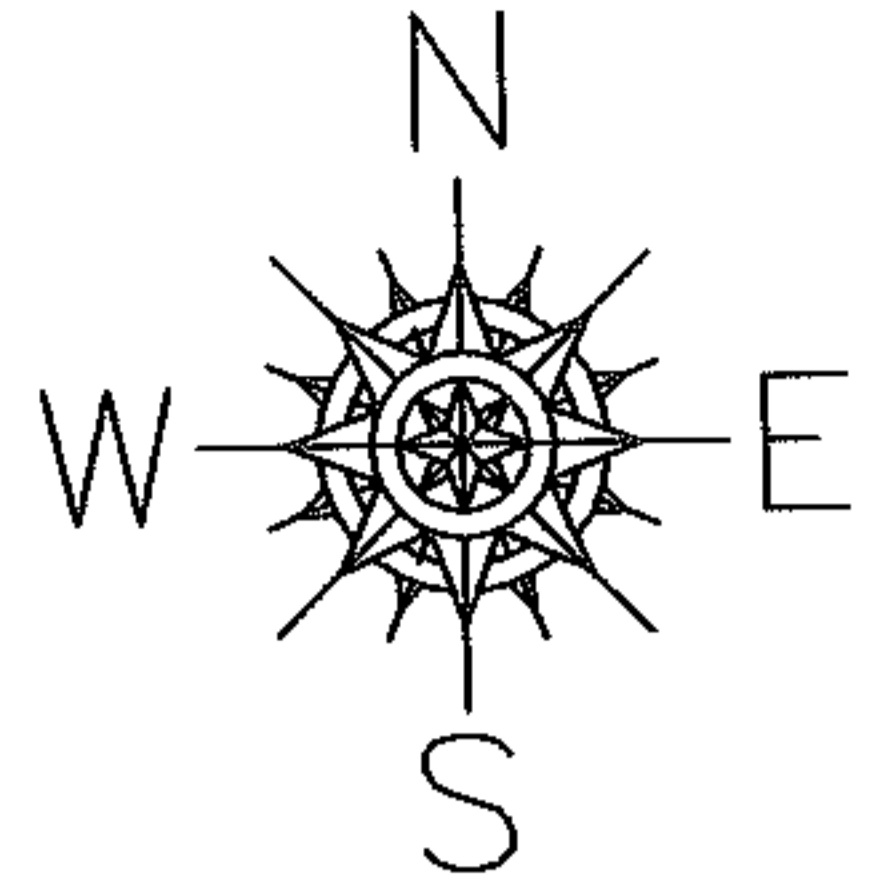

SPLITS/DEEDS PROCESSED

LORAIN COUNTY TAX MAP DEPARTMENT
226 MIDDLE AVE. ELYRIA, OHIO

SURVEYED BY: RICHARD FREDRICKSON

CLOSURE: 0.00 : 10.000

MAP PAGE(S): 03-00-002-A

APPROVED BY: JAH DATE: 7-25-07

SCALE: 1" = 200' PRIOR INSTRUMENT: 19970506297