

Resar


PARENT PARCEL: 21-11-000-000-011

CHILD PARCEL: _____

STARTING POINT: INTERSECTION OF C/L OF S.R.162 AND C/L OF S.R.58

12-02429-D

NEW LONDON - LAFAYETTE RD. (S.R.162)

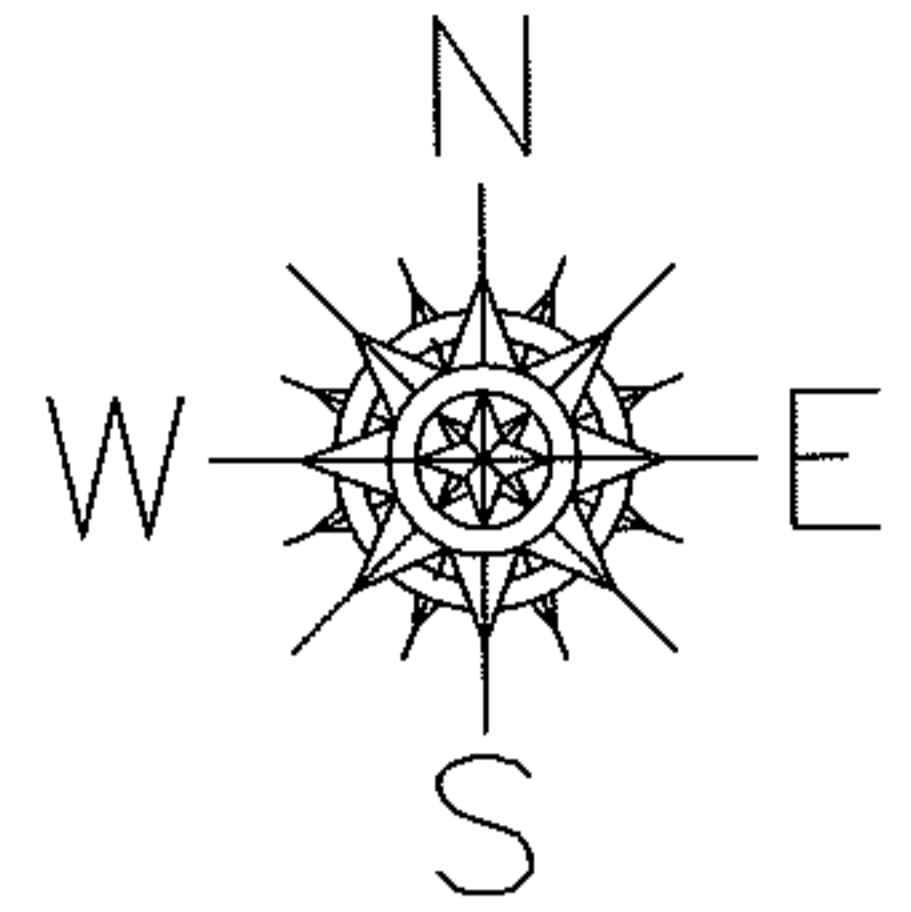

ASHLAND - OBERLIN RD. (S.R.58)

974.64

116.09

218.61

-011

~~0.50 A.~~


0.59 A.

AC.CORR.PER SRUV.

J.RESAR

222.16

117.29

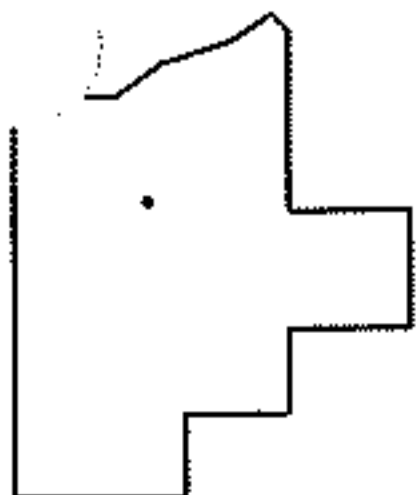

SPLITS/DEEDS PROCESSED

LORAIN COUNTY TAX MAP DEPARTMENT
226 MIDDLE AVE. ELYRIA, OHIO

SURVEYED BY: JAMES A. RESAR

CLOSURE: .01:10,000

MAP PAGE(S): 21-11-000-A

APPROVED BY: RRM DATE: 1-18-12

SCALE: 1"= 100 PRIOR INST.: 20060148795