



RASTER

PARENT PARCEL: 08-00-090-000-018

07-02434

CHILD PARCEL: 08-00-090-000-040, -041

STARTING POINT: CENTERLINE OF BAUMHART RD & RUSSIA RD

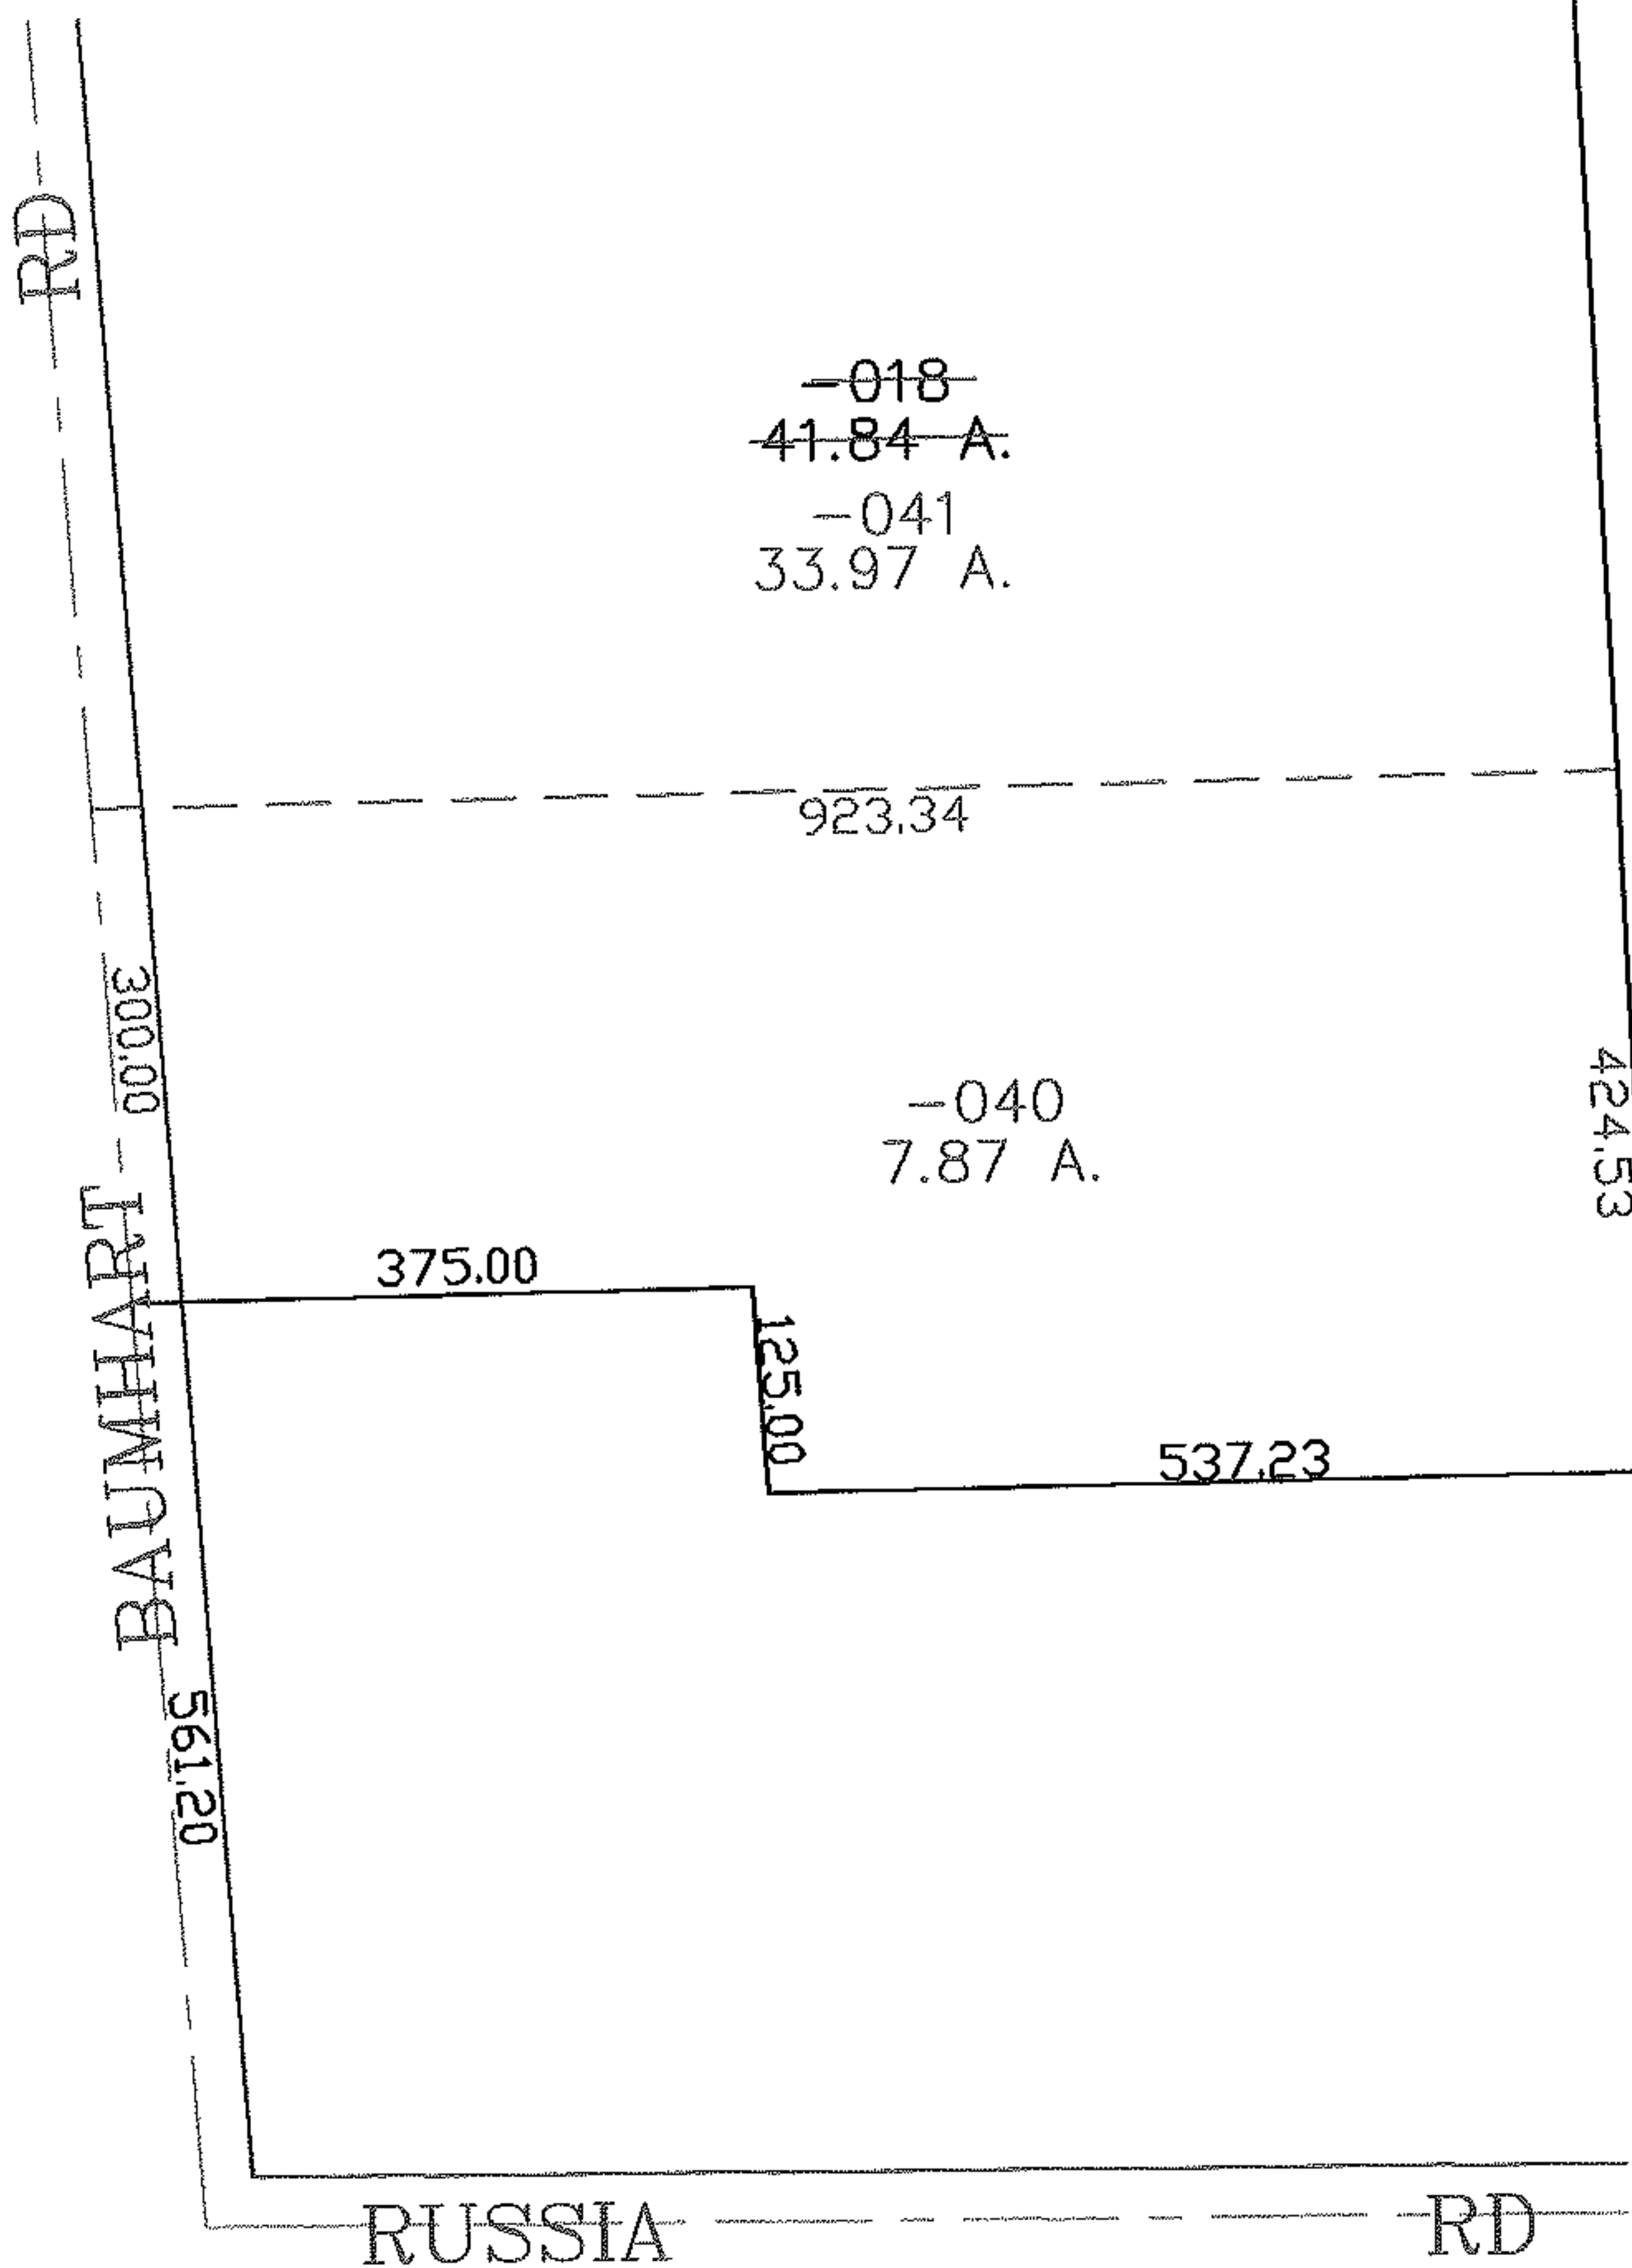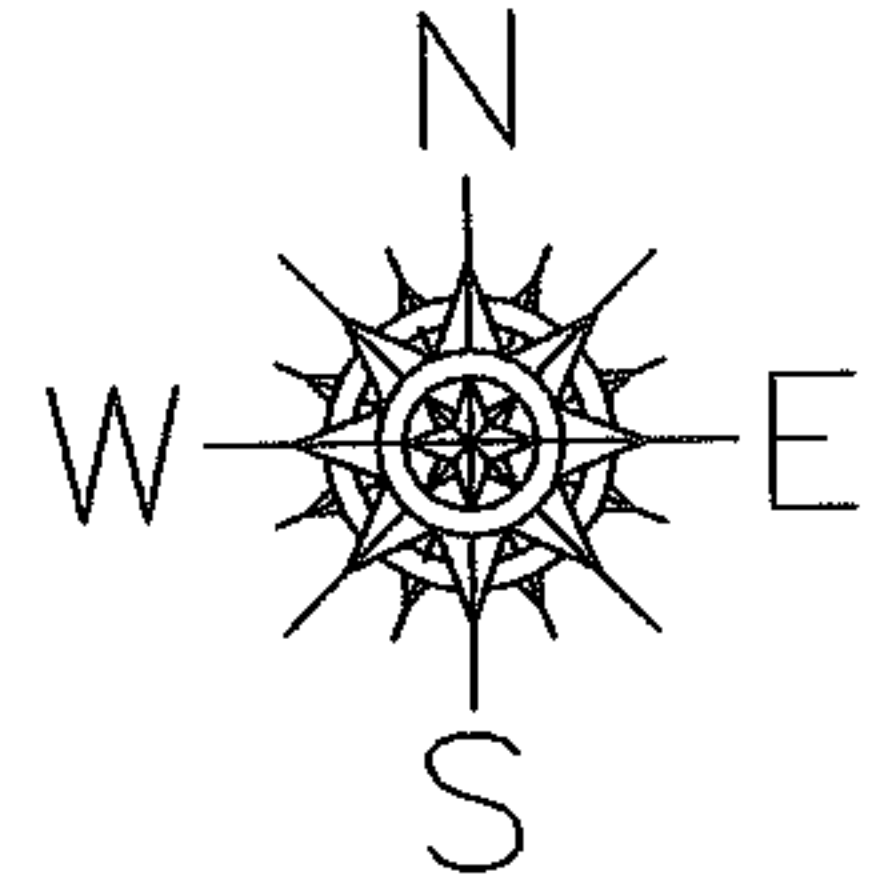

~~-018~~
41.84 A.
~~-041~~
33.97 A.

-040
7.87 A.

SPLITS/DEEDS PROCESSED

LORAIN COUNTY TAX MAP DEPARTMENT
226 MIDDLE AVE. ELYRIA, OHIO

SURVEYED BY: CHARLES WARYU

CLOSURE: 0.00 : 10.000

MAP PAGE(S): 08-00-090-B

APPROVED BY: JAH DATE: 8-6-07

SCALE: 1" = 200 PRIOR INSTRUMENT: 20010788205