



Raster

PARENT PARCEL: 04-00-015-103-050


12-02435-A

CHILD PARCEL: _____

STARTING POINT: AT A MON BOX AT THE INTERSECTION OF C/L OF MIDDLETON RD. AND C/L OF S.R. 254

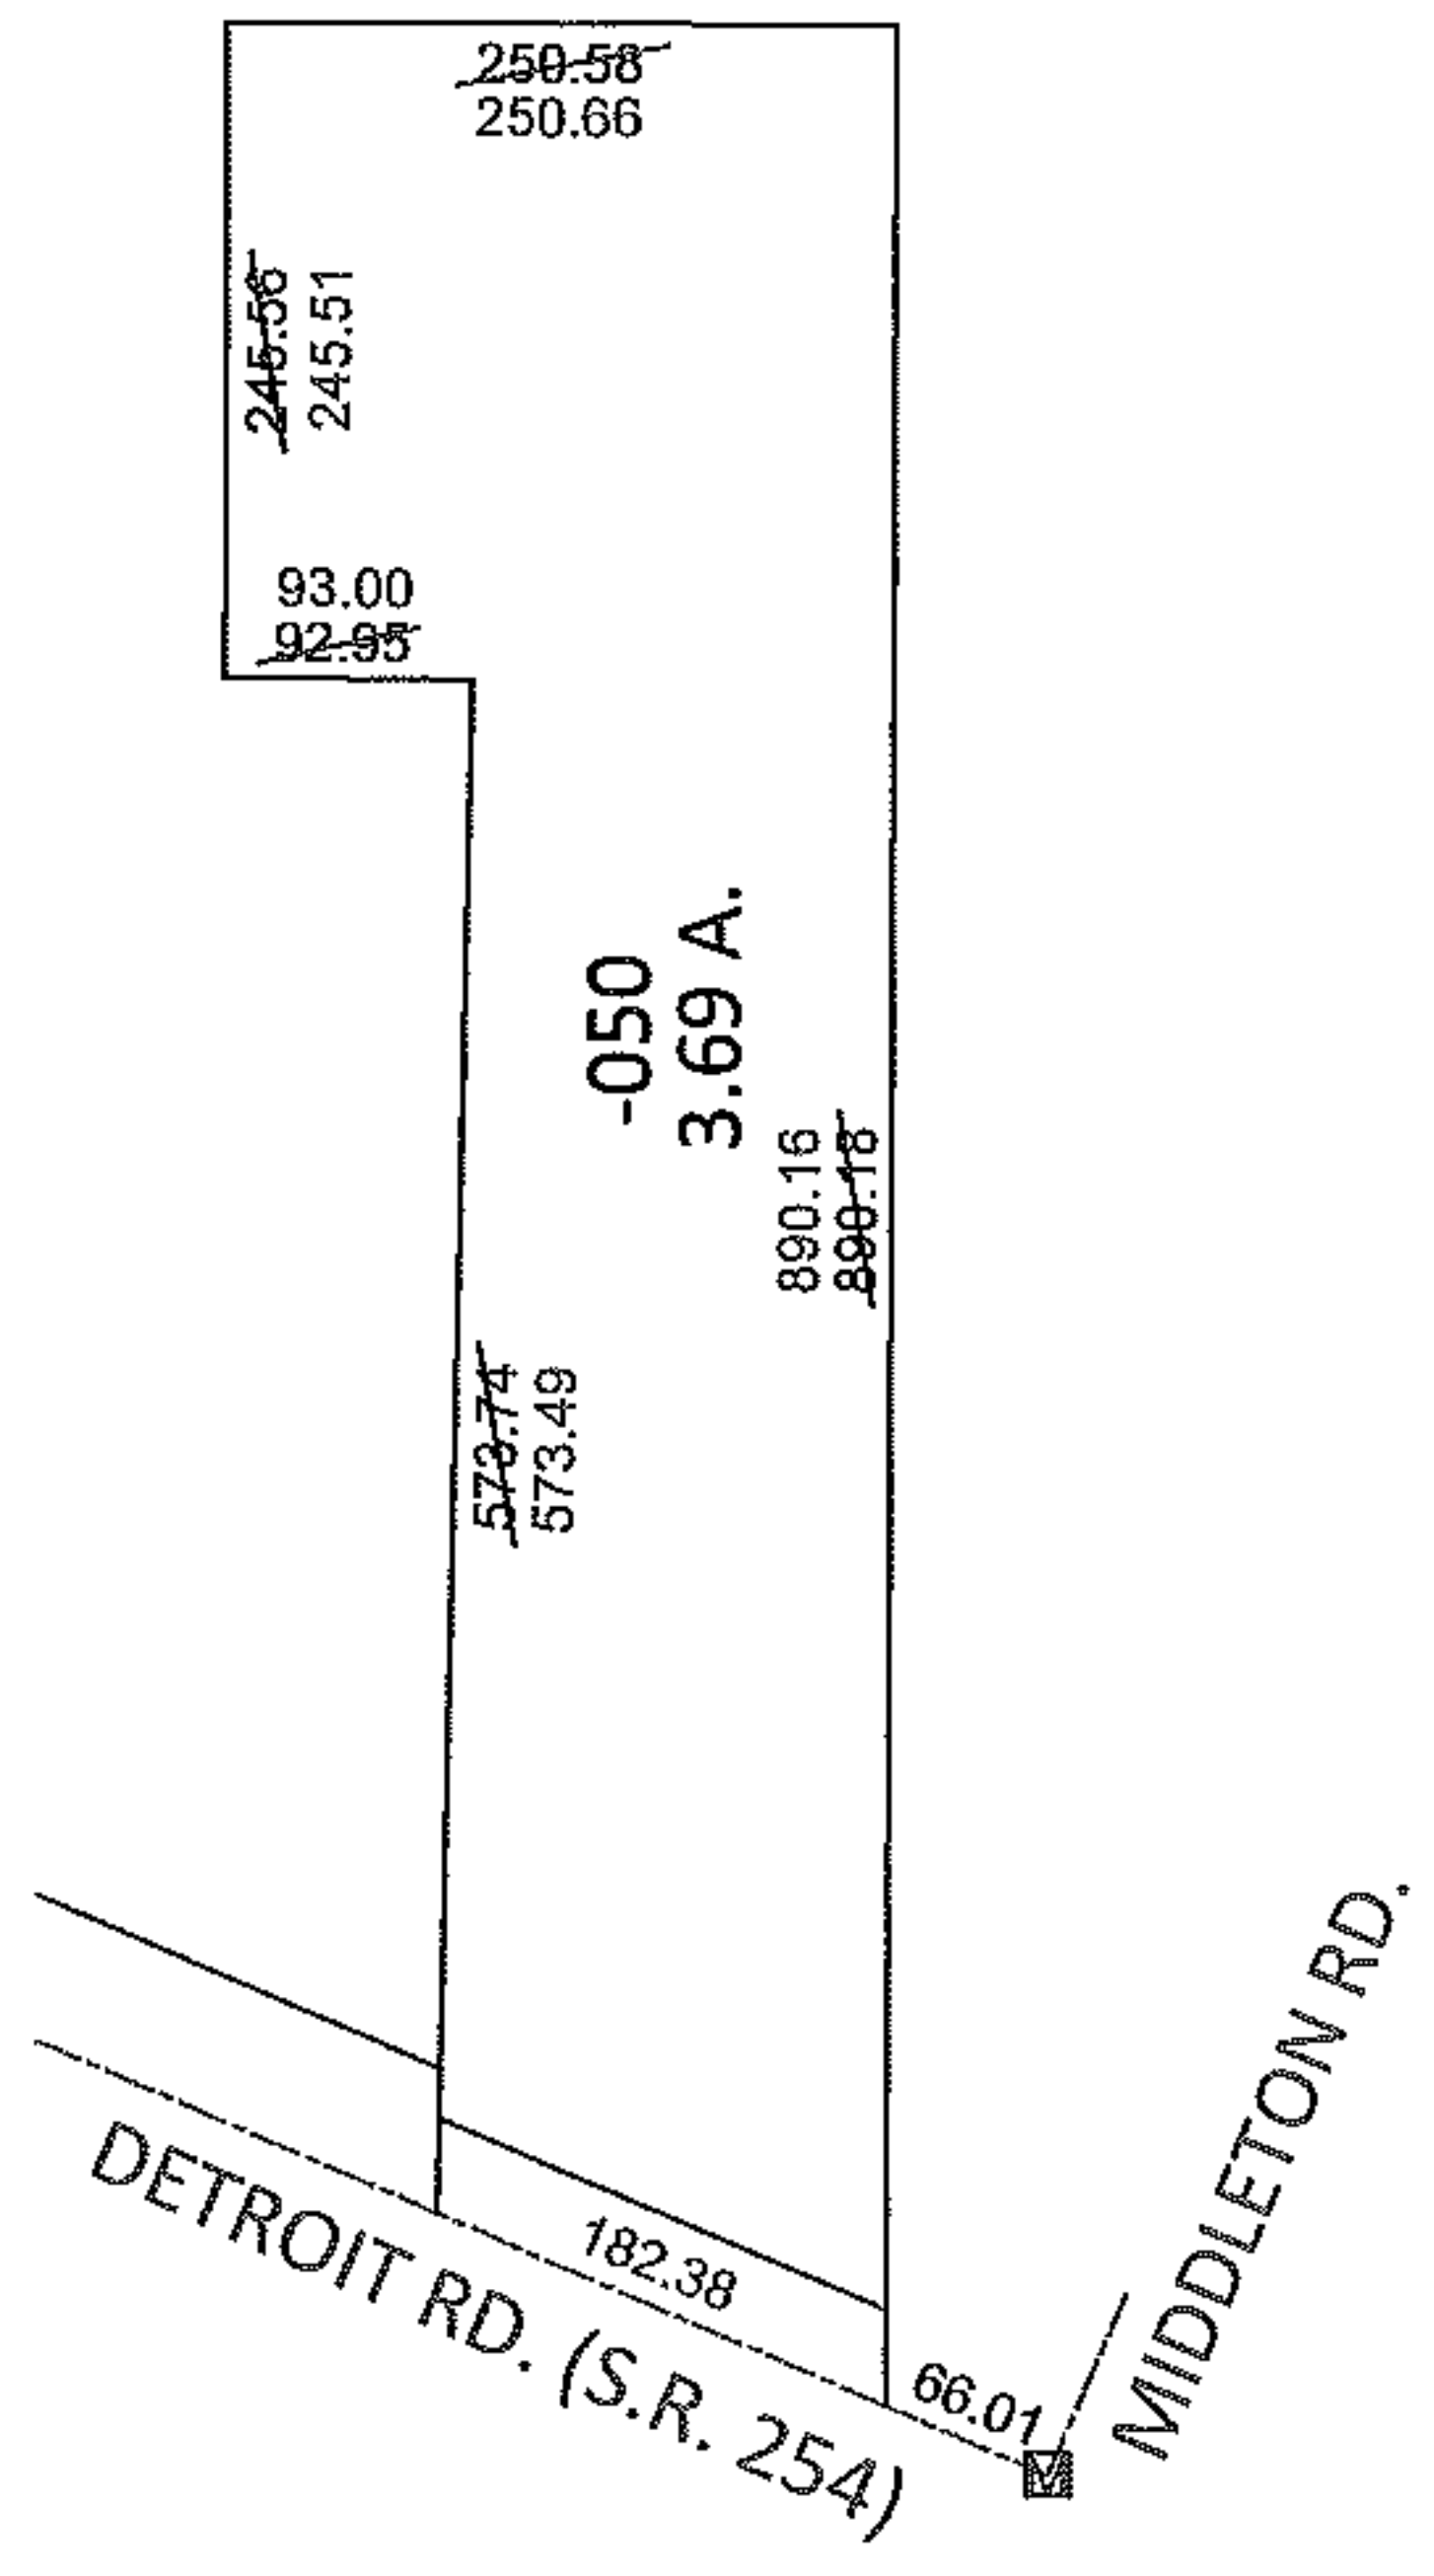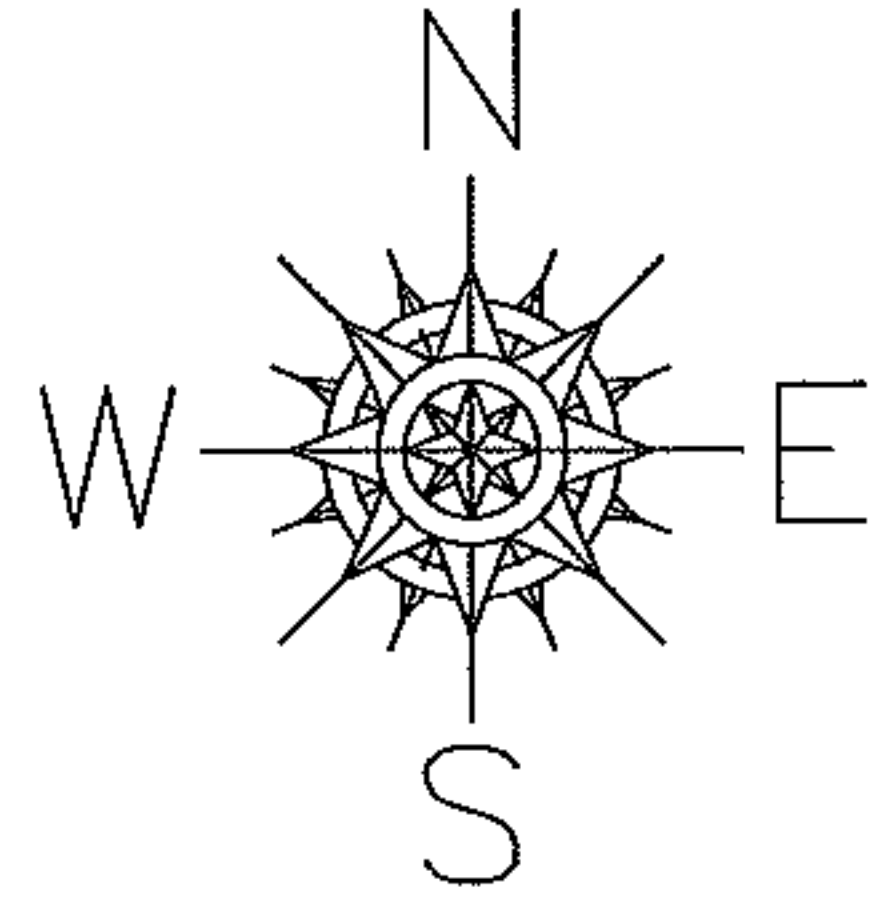

MAP CORRECTION ONLY
PER SURV. M.SPELLACY

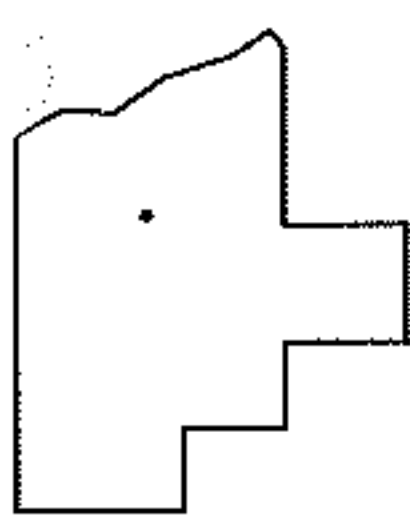

SPLITS/DEEDS PROCESSED
LORAIN COUNTY TAX MAP DEPARTMENT
226 MIDDLE AVE. ELYRIA, OHIO

SURVEYED BY: MICHAEL P. SPELLACY
CLOSURE: .01:10,000
MAP PAGE(S): 4-00-015-D
APPROVED BY: RRM DATE: 1-30-12
SCALE: 1"= 200 PRIOR INST.: 20080262049