




RASTER

PARENT PARCEL: 09-00-080-000-047

07-02435

CHILD PARCEL: 09-00-080-000-051, -052

STARTING POINT: CENTERLINE OF ELYRIA-OBERLIN RD & HALE RD

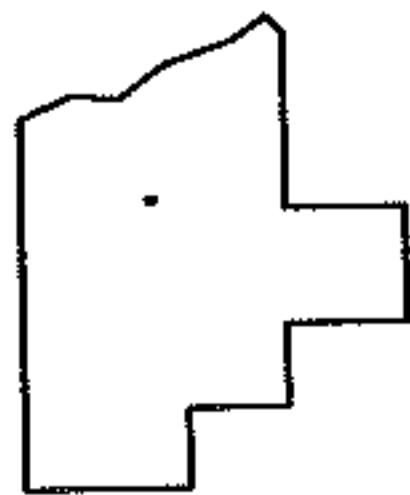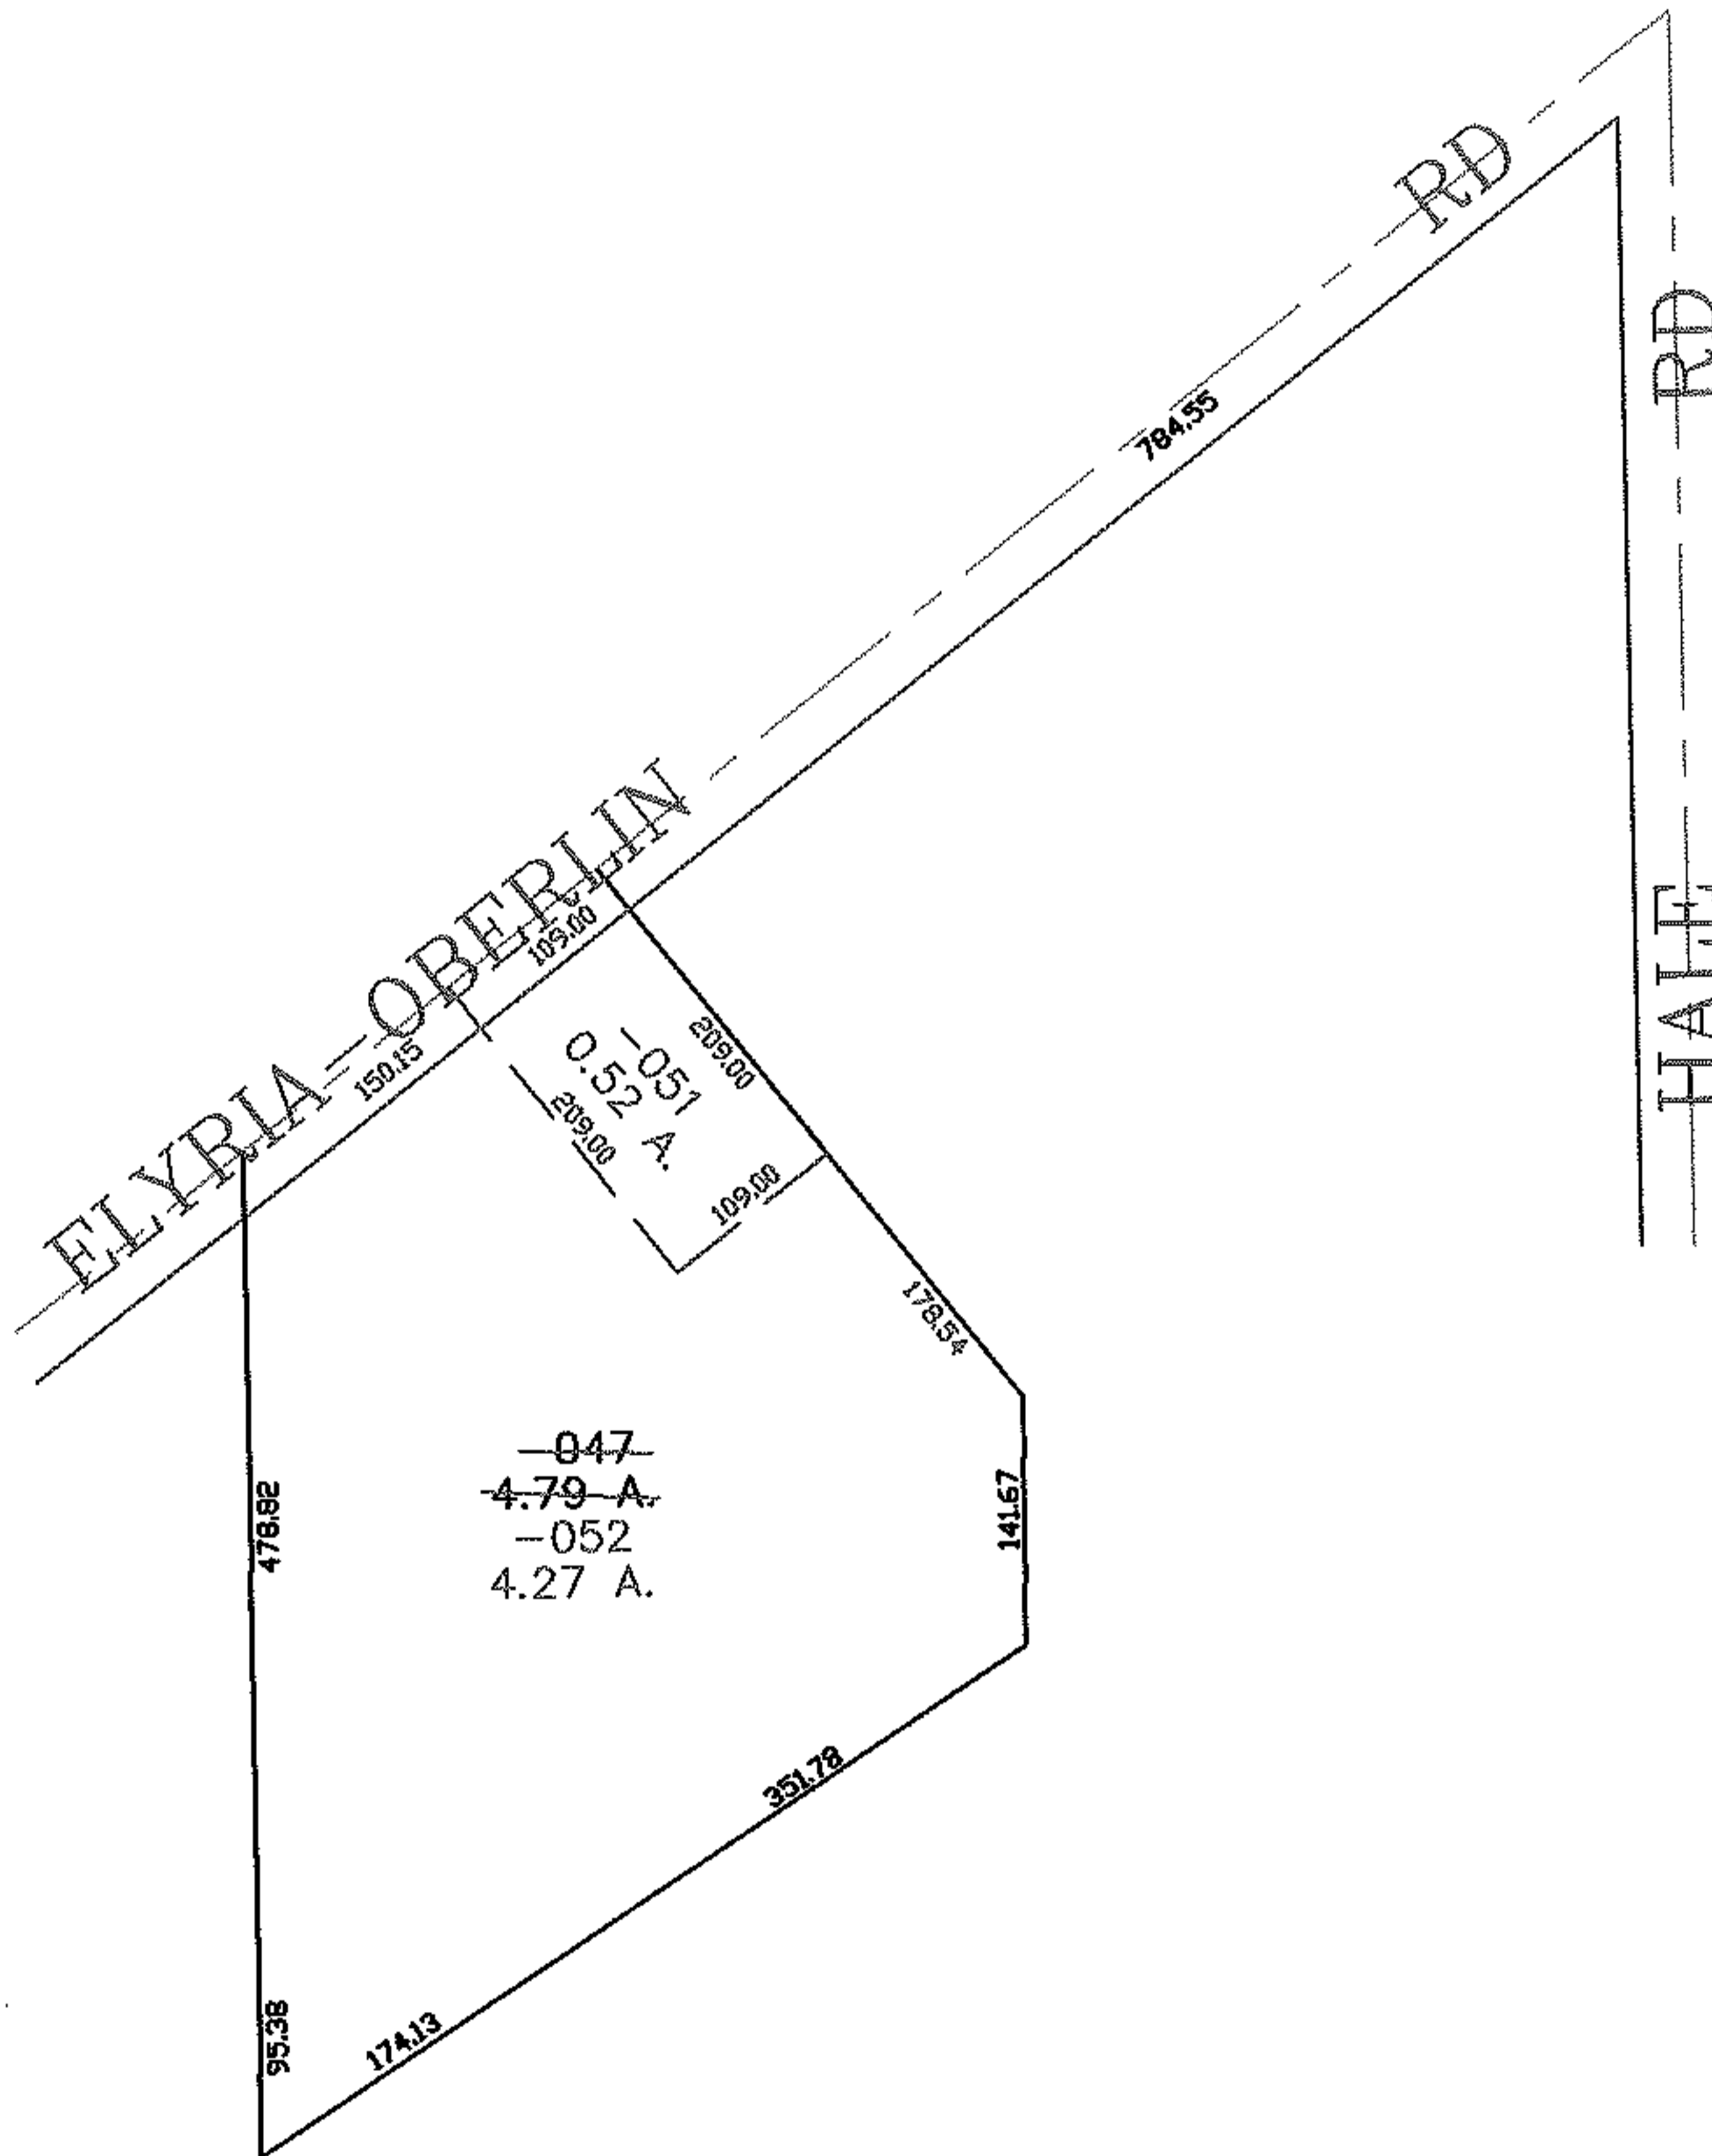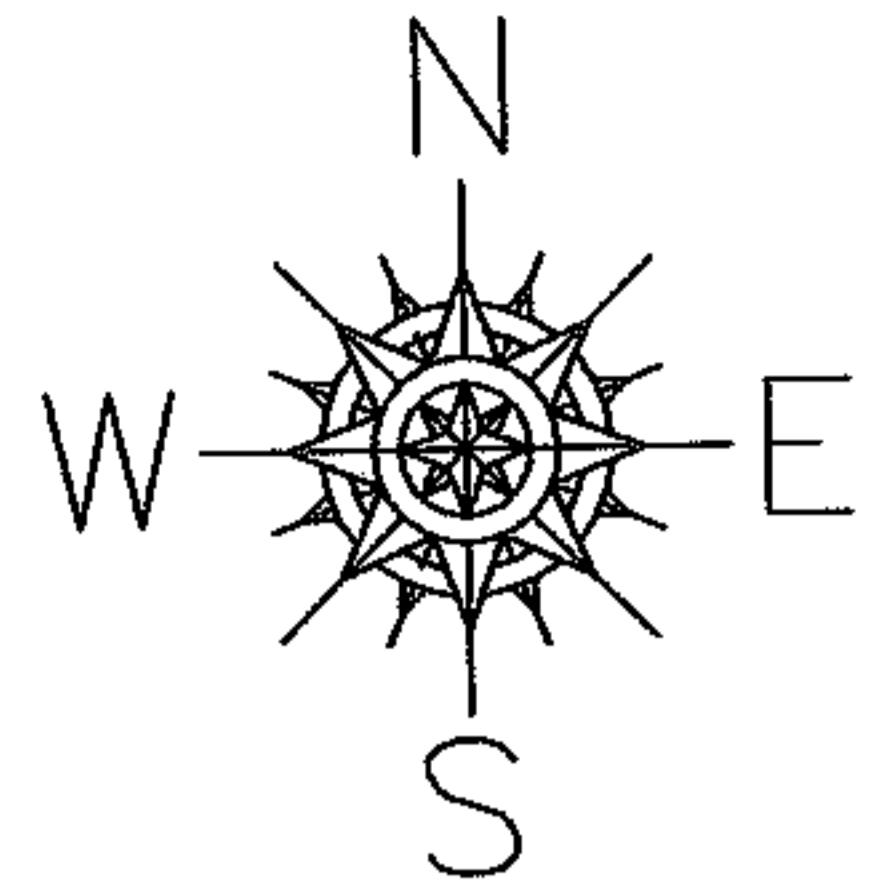

SPLITS/DEEDS PROCESSED

LORAIN COUNTY TAX MAP DEPARTMENT  
226 MIDDLE AVE. ELYRIA, OHIO

SURVEYED BY: GARY PENFOUND

CLOSURE: 0.00 : 10.000

MAP PAGE(S): 09-00-080-B

APPROVED BY: JAH DATE: 8-6-07

SCALE: 1" = 200 PRIOR INSTRUMENT: 19990592607