
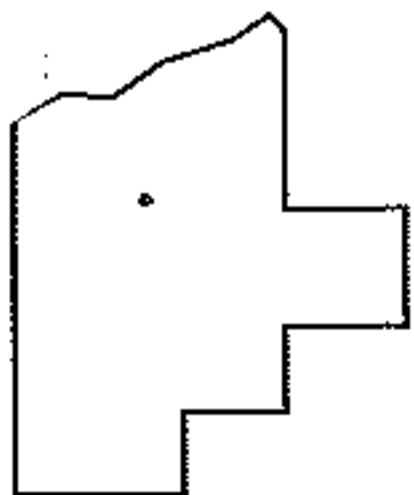
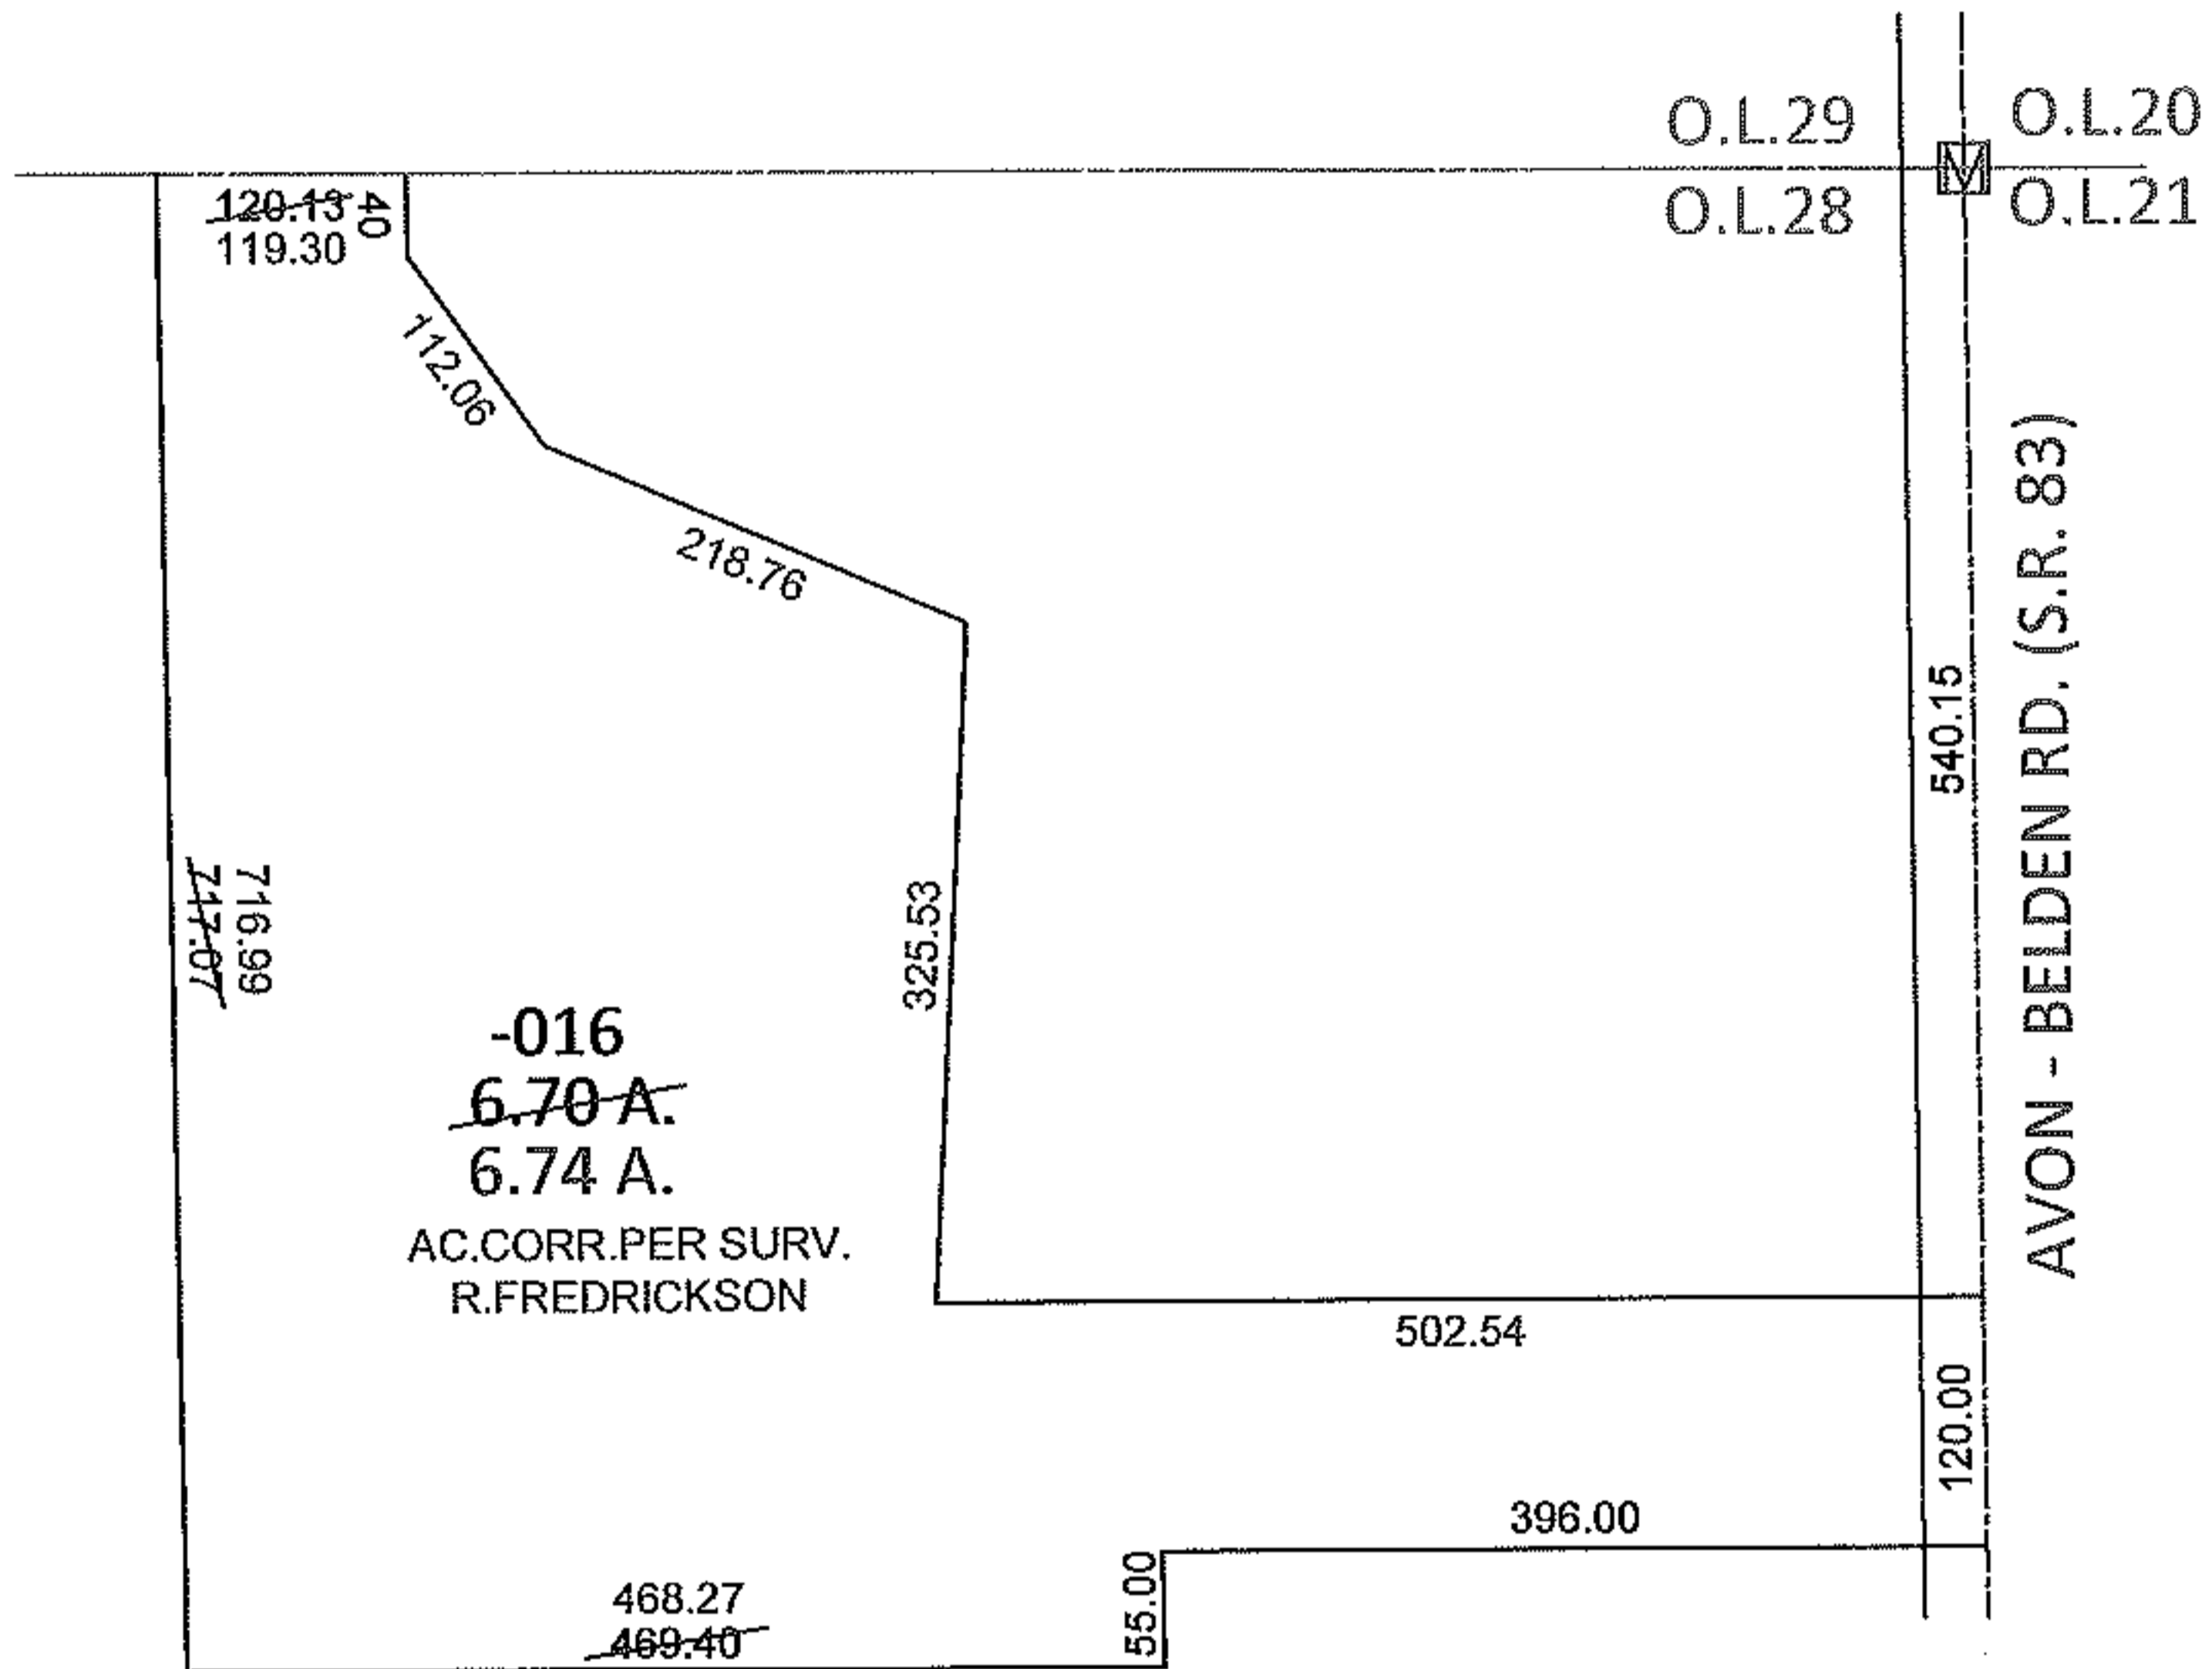


PARENT PARCEL: 07-00-028-102-016

CHILD PARCEL: _____

STARTING POINT: AT A MON BOX AT THE NORTHEAST CORNER OF O.L.28

12-02436-A

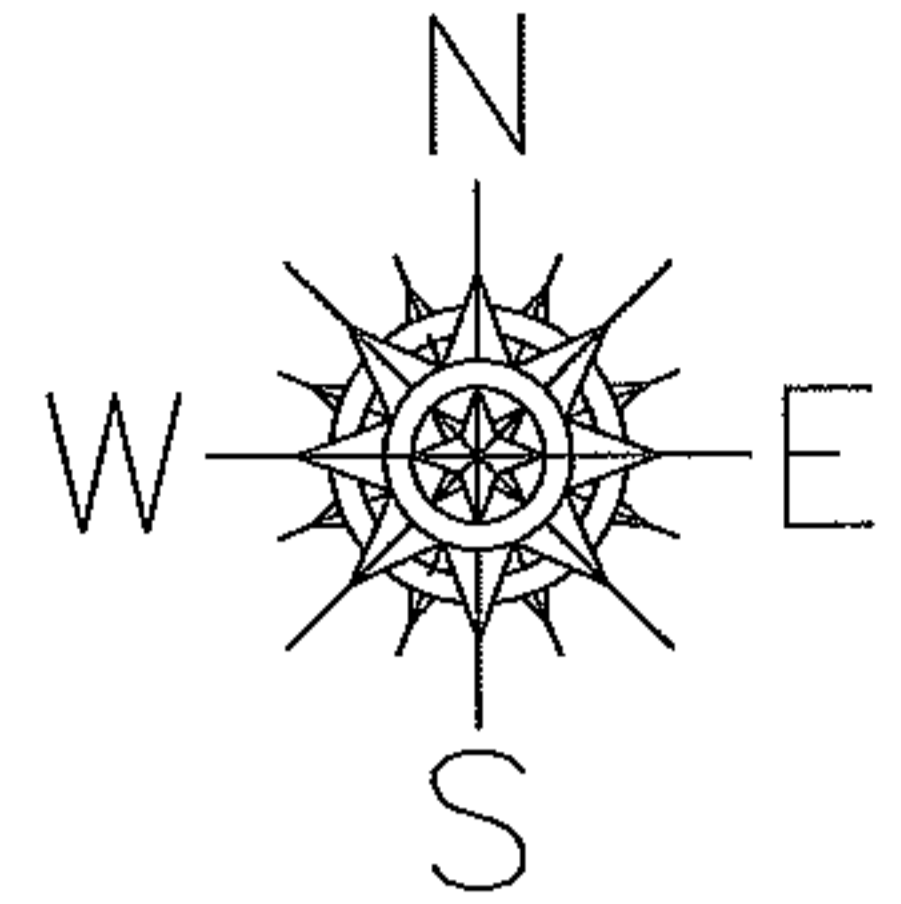

SPLITS/DEEDS PROCESSED

LORAIN COUNTY TAX MAP DEPARTMENT
226 MIDDLE AVE. ELYRIA, OHIO

SURVEYED BY: RICHARD A. FREDRICKSON

CLOSURE: .01:10,000

MAP PAGE(S): 7-00-028-B

APPROVED BY: RRM DATE: 1-30-12

SCALE: 1"= 200 PRIOR INST.: 19990592946