


Raster

PARENT PARCEL: 10-00-025-102-041
CHILD PARCEL: XX-XX-XXX-XXX-XXX
STARTING POINT: CL OF INDIAN HOLLOW & NORTH LINE OF J.H. SHELDON DV 155 PG. 487

12-02437-A

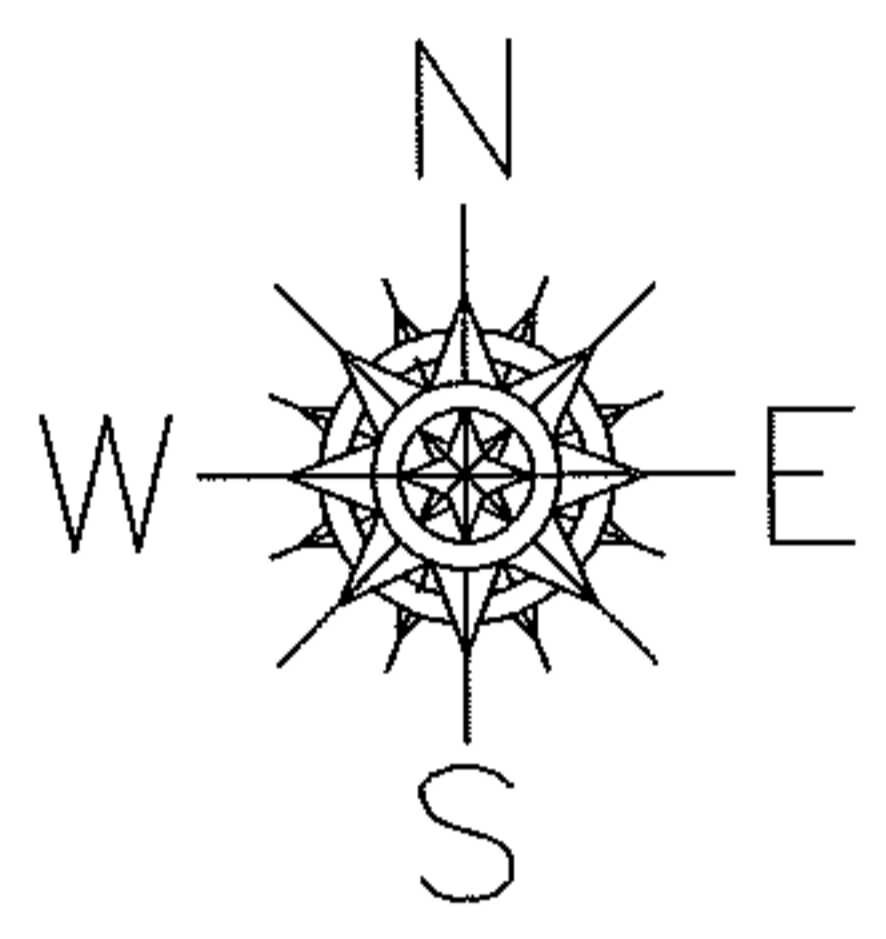



ACREAGE CORRECTION

10-00-025-102-041

~~3.74~~ A.

3.73 A.

CORR. PER SURV.
JOHN L. MENO

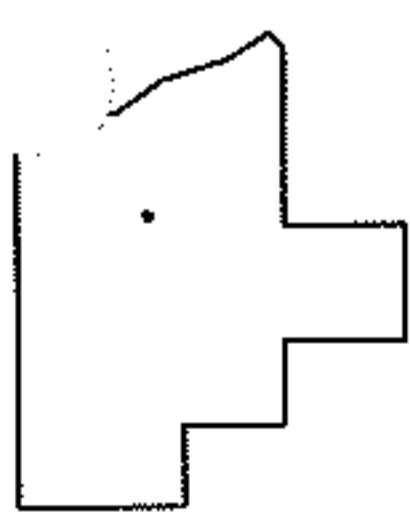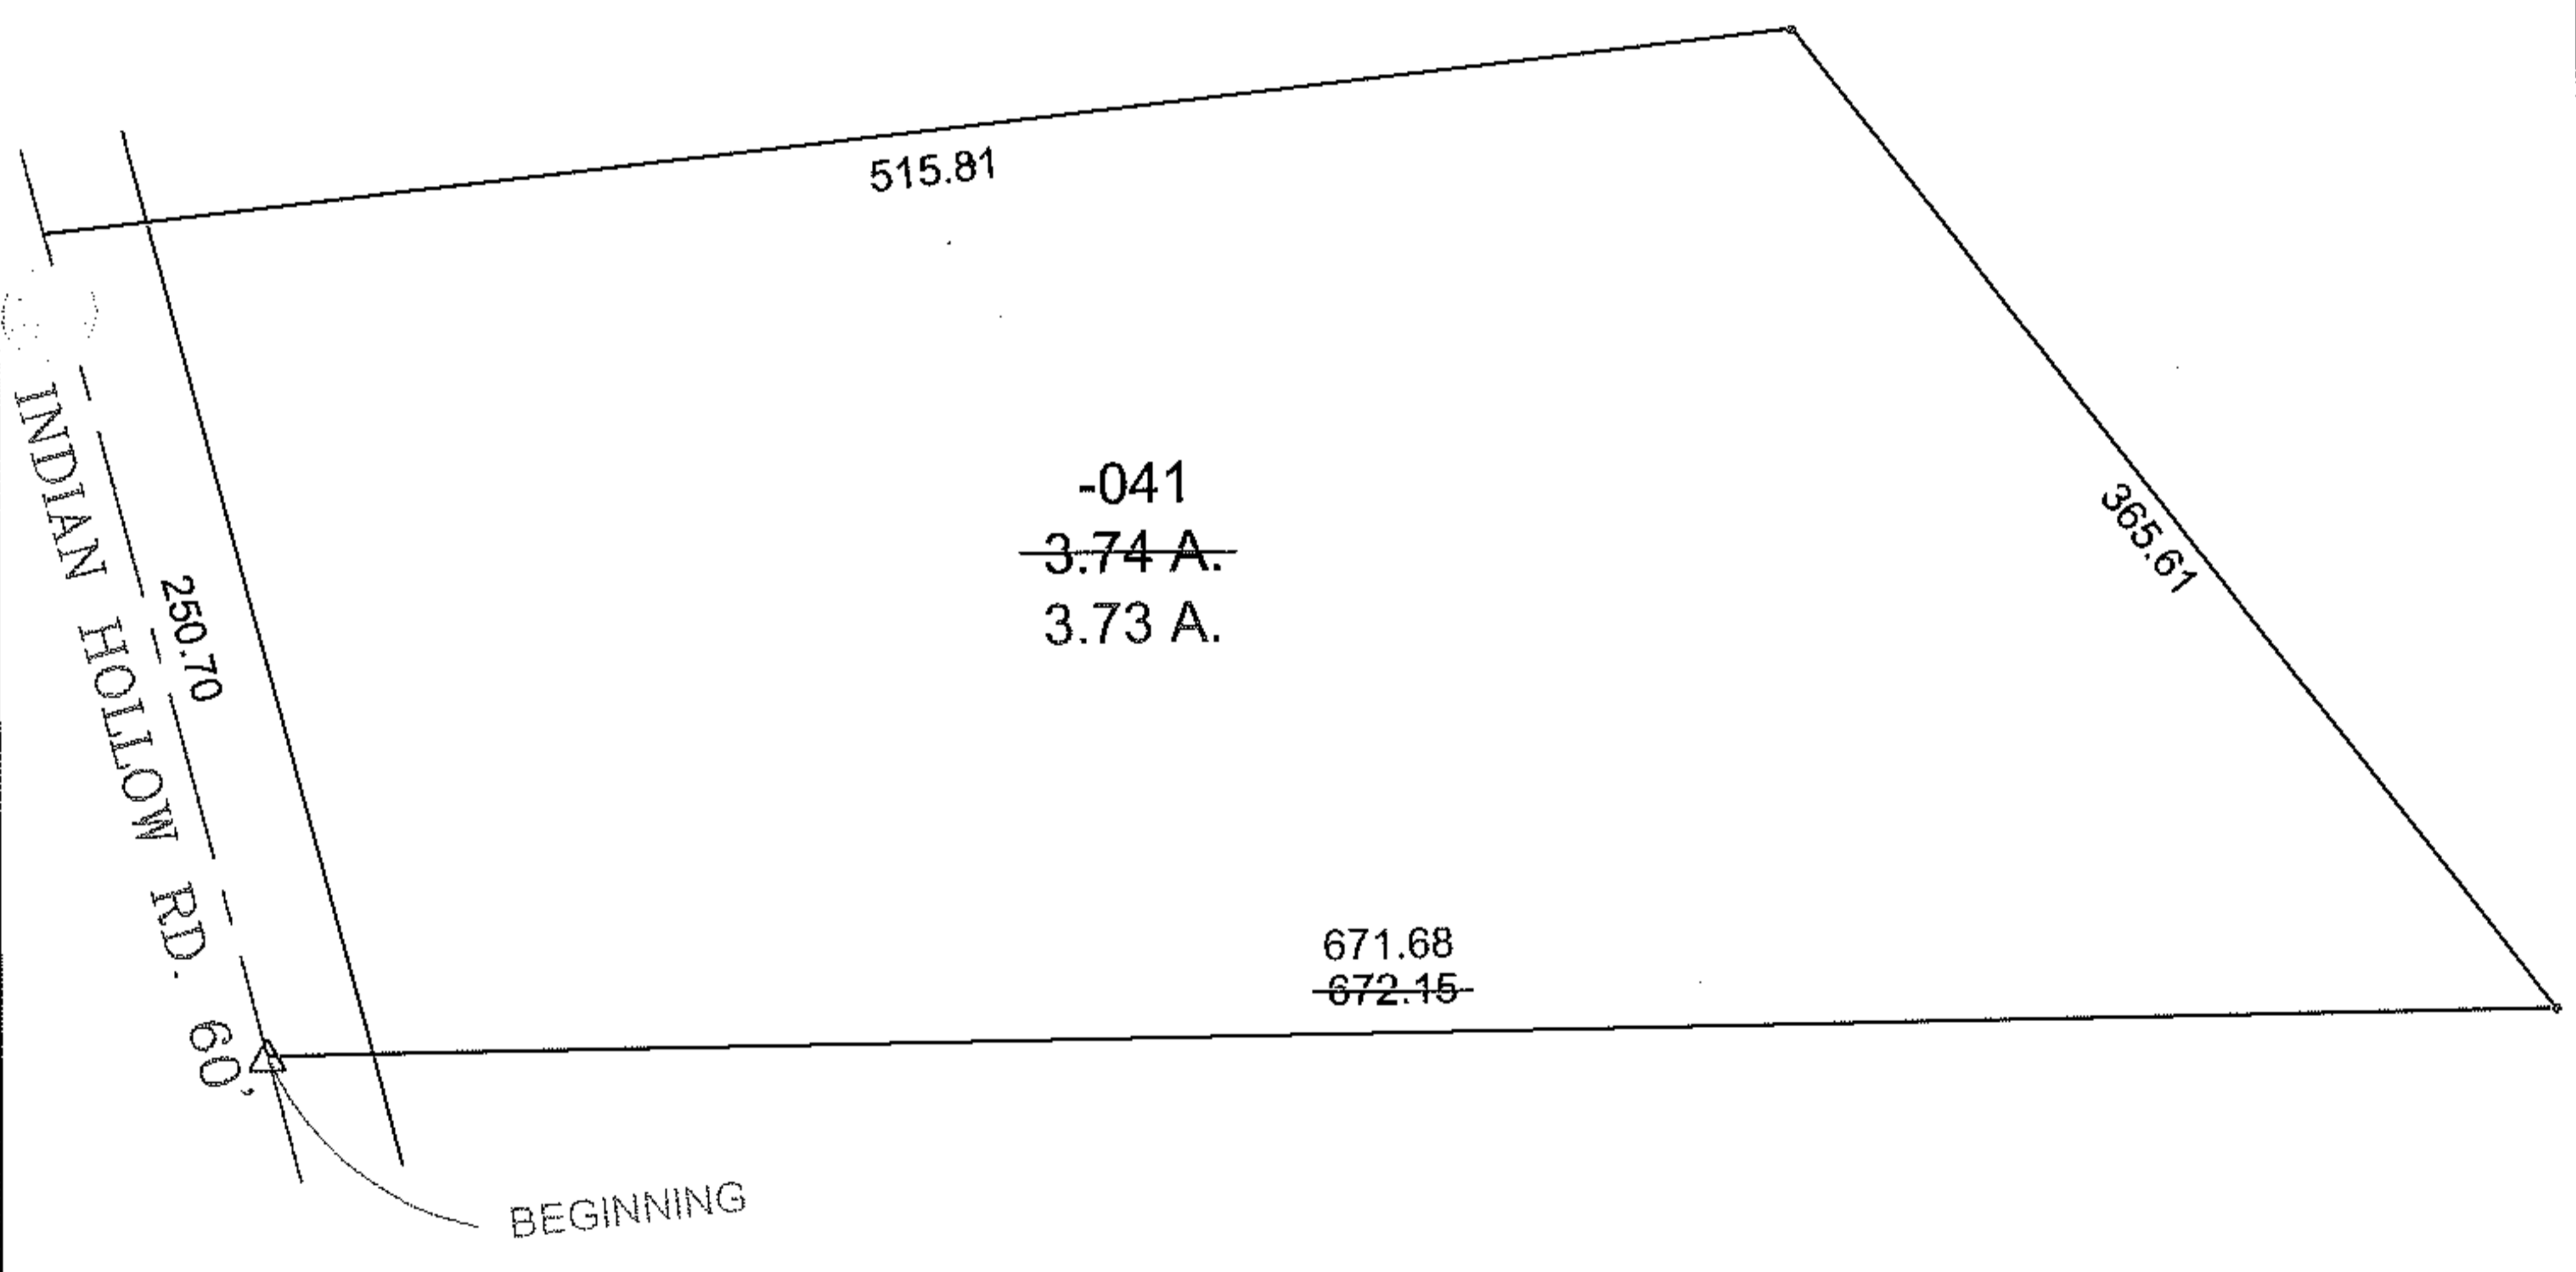

SPLITS/DEEDS PROCESSED
LORAIN COUNTY TAX MAP DEPARTMENT
226 MIDDLE AVE. ELYRIA, OHIO

SURVEYED BY: JOHN L. MENO
CLOSURE: 0.01 : 10,000
MAP PAGE(S): 10-00-025-G
APPROVED BY: TJS DATE: 1/30/12
SCALE: 1" = 100 PRIOR INST.: DV 723/572