
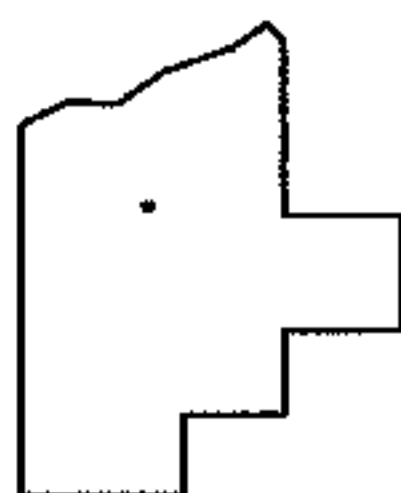
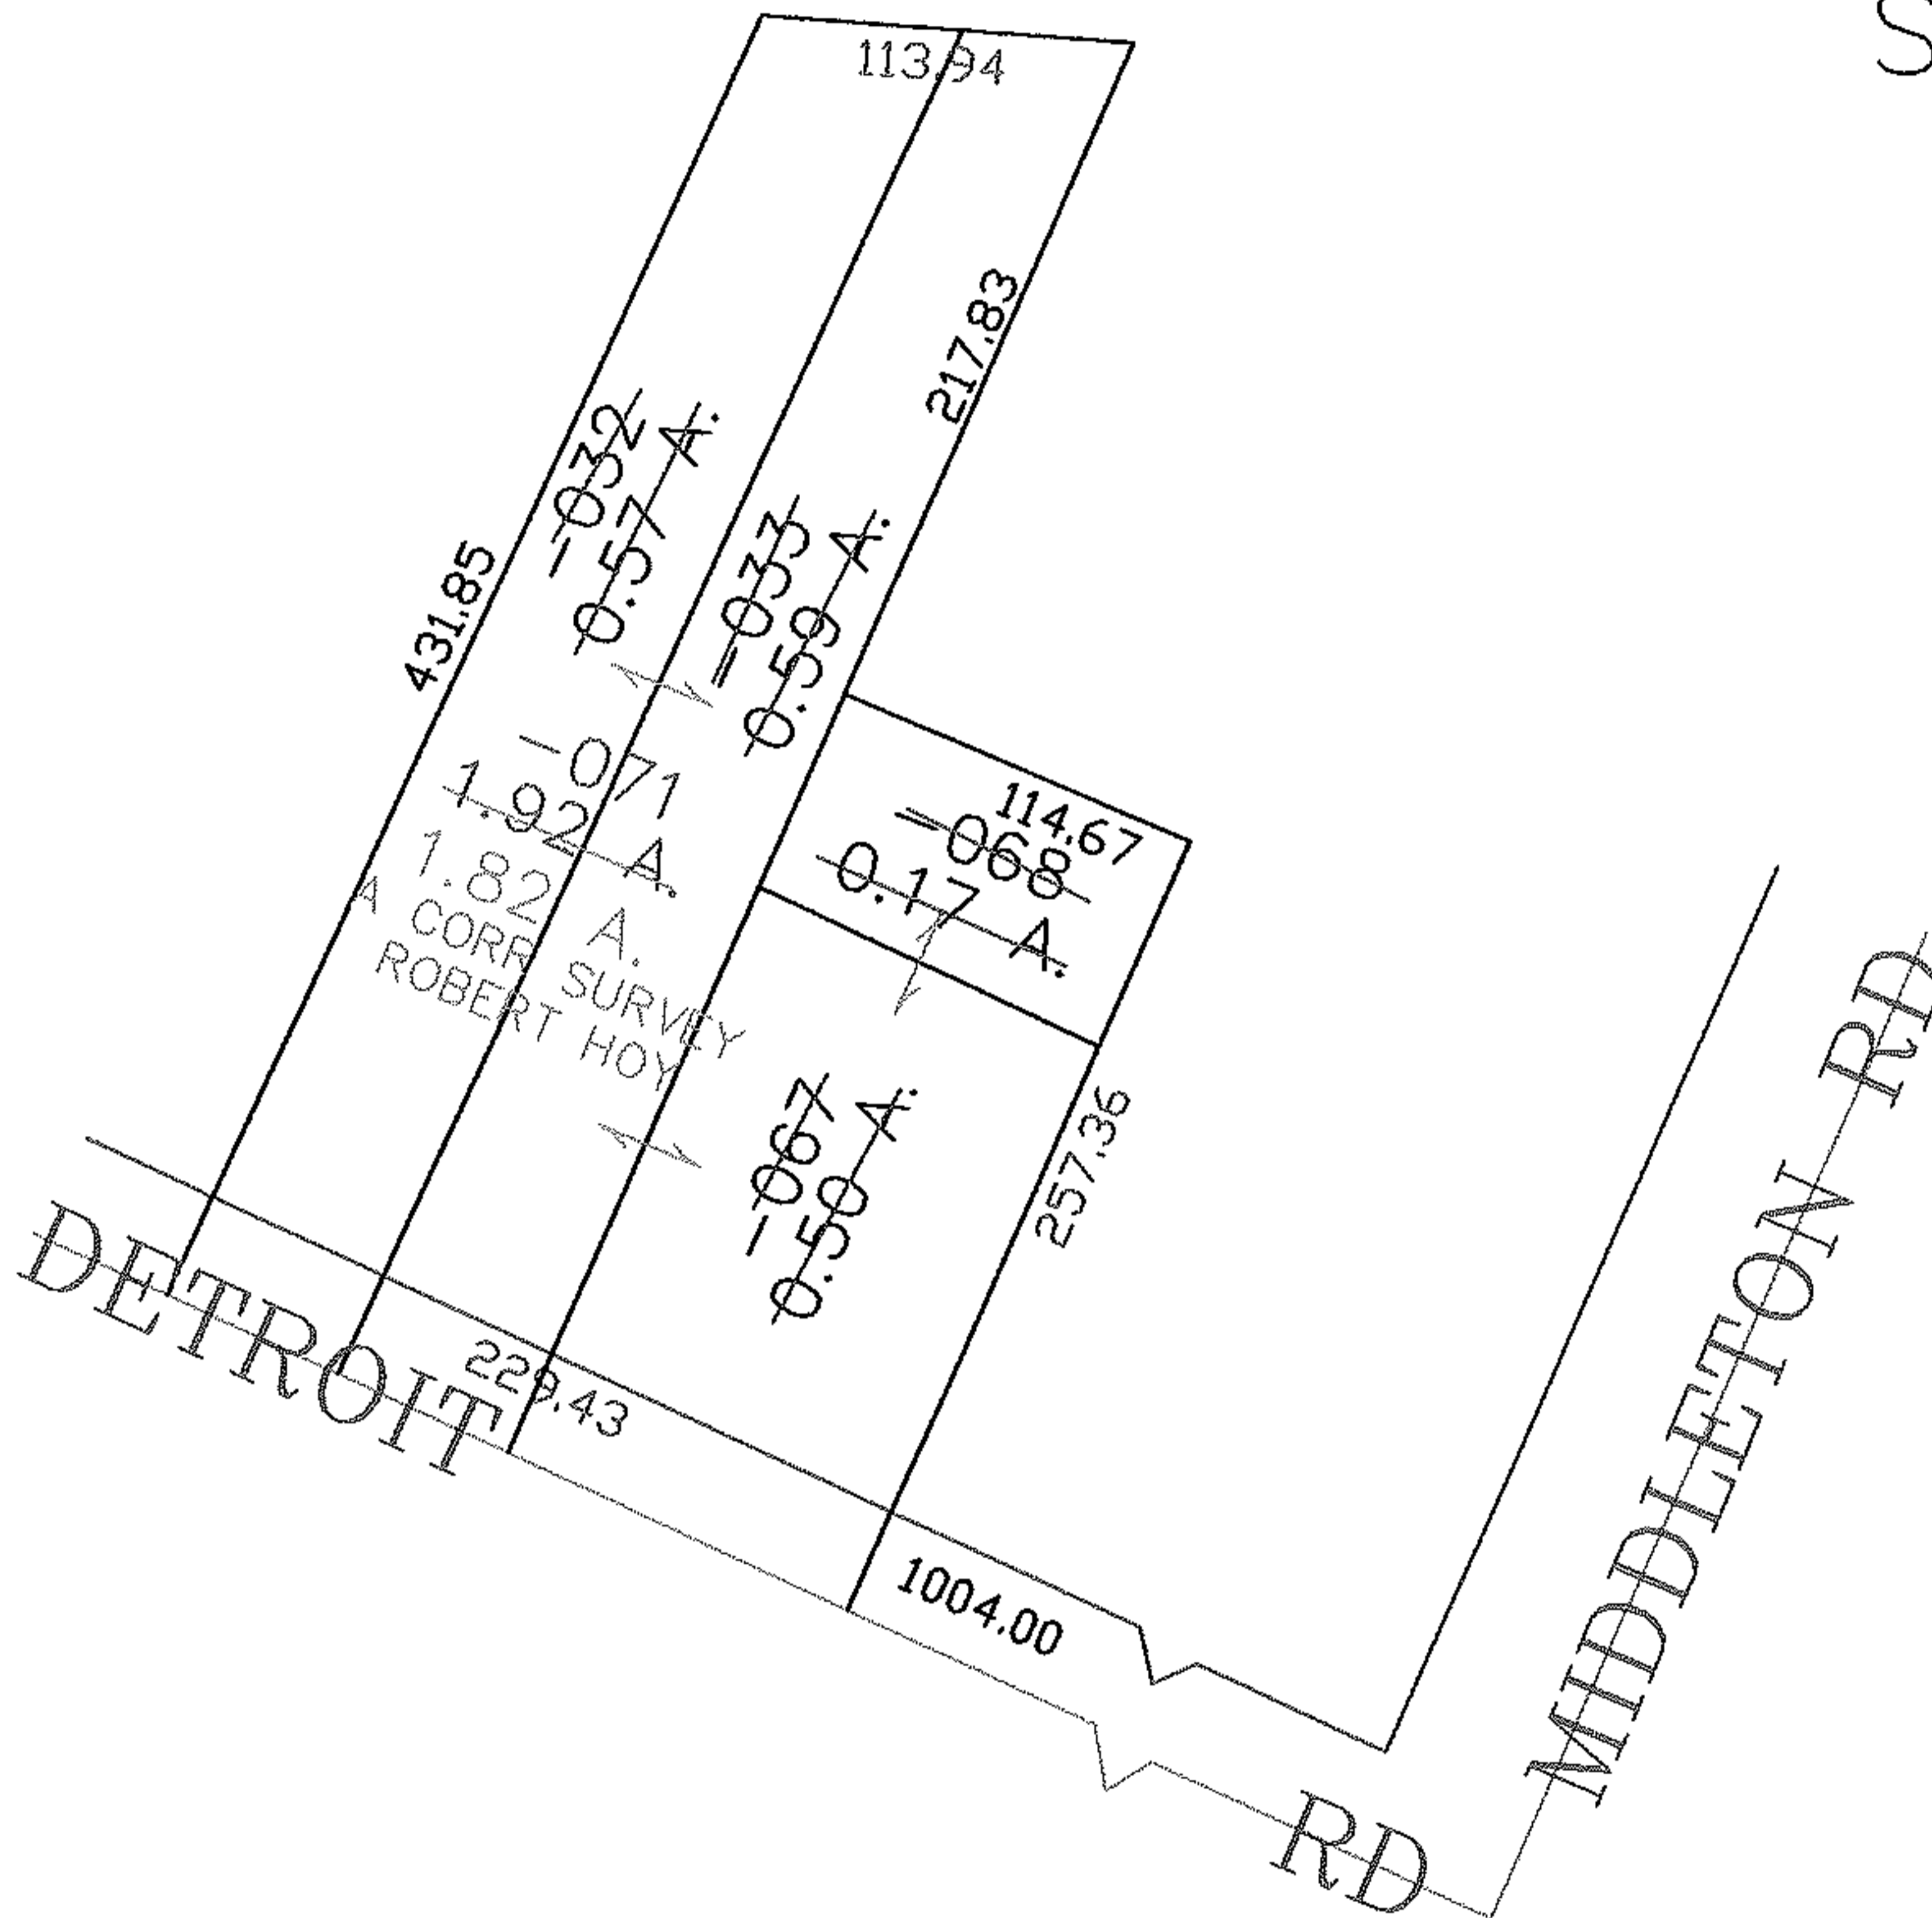


PARENT PARCEL: 04-00-015-103-032, -033, -067, -068

CHILD PARCEL: 04-00-015-103-071

STARTING POINT: CENTERLINE OF DETROIT RD & MIDDLETON RD

07-02437

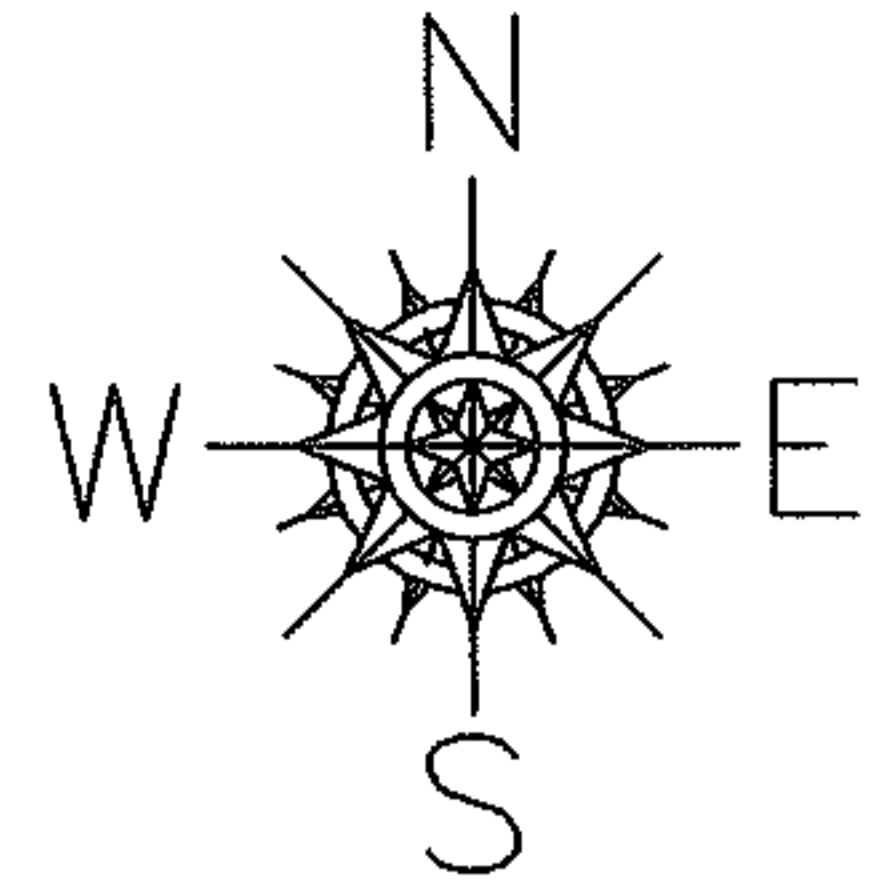

SPLITS/DEEDS PROCESSED

LORAIN COUNTY TAX MAP DEPARTMENT
226 MIDDLE AVE. ELYRIA, OHIO

SURVEYED BY: ROBERT G. HOY

CLOSURE: 0.00 : 10,000

MAP PAGE(S): 04-00-015-D

APPROVED BY: JAH DATE: 8-9-07

SCALE: 1" = 100 PRIOR INSTRUMENT: 20070213583