



RASTER

PARENT PARCEL: 06-25-064-000-001 -002

CHILD PARCEL: 06-25-064-000-007

12-02439-C

STARTING POINT: SIDELINE OF RIDGE ST & O.L. 64

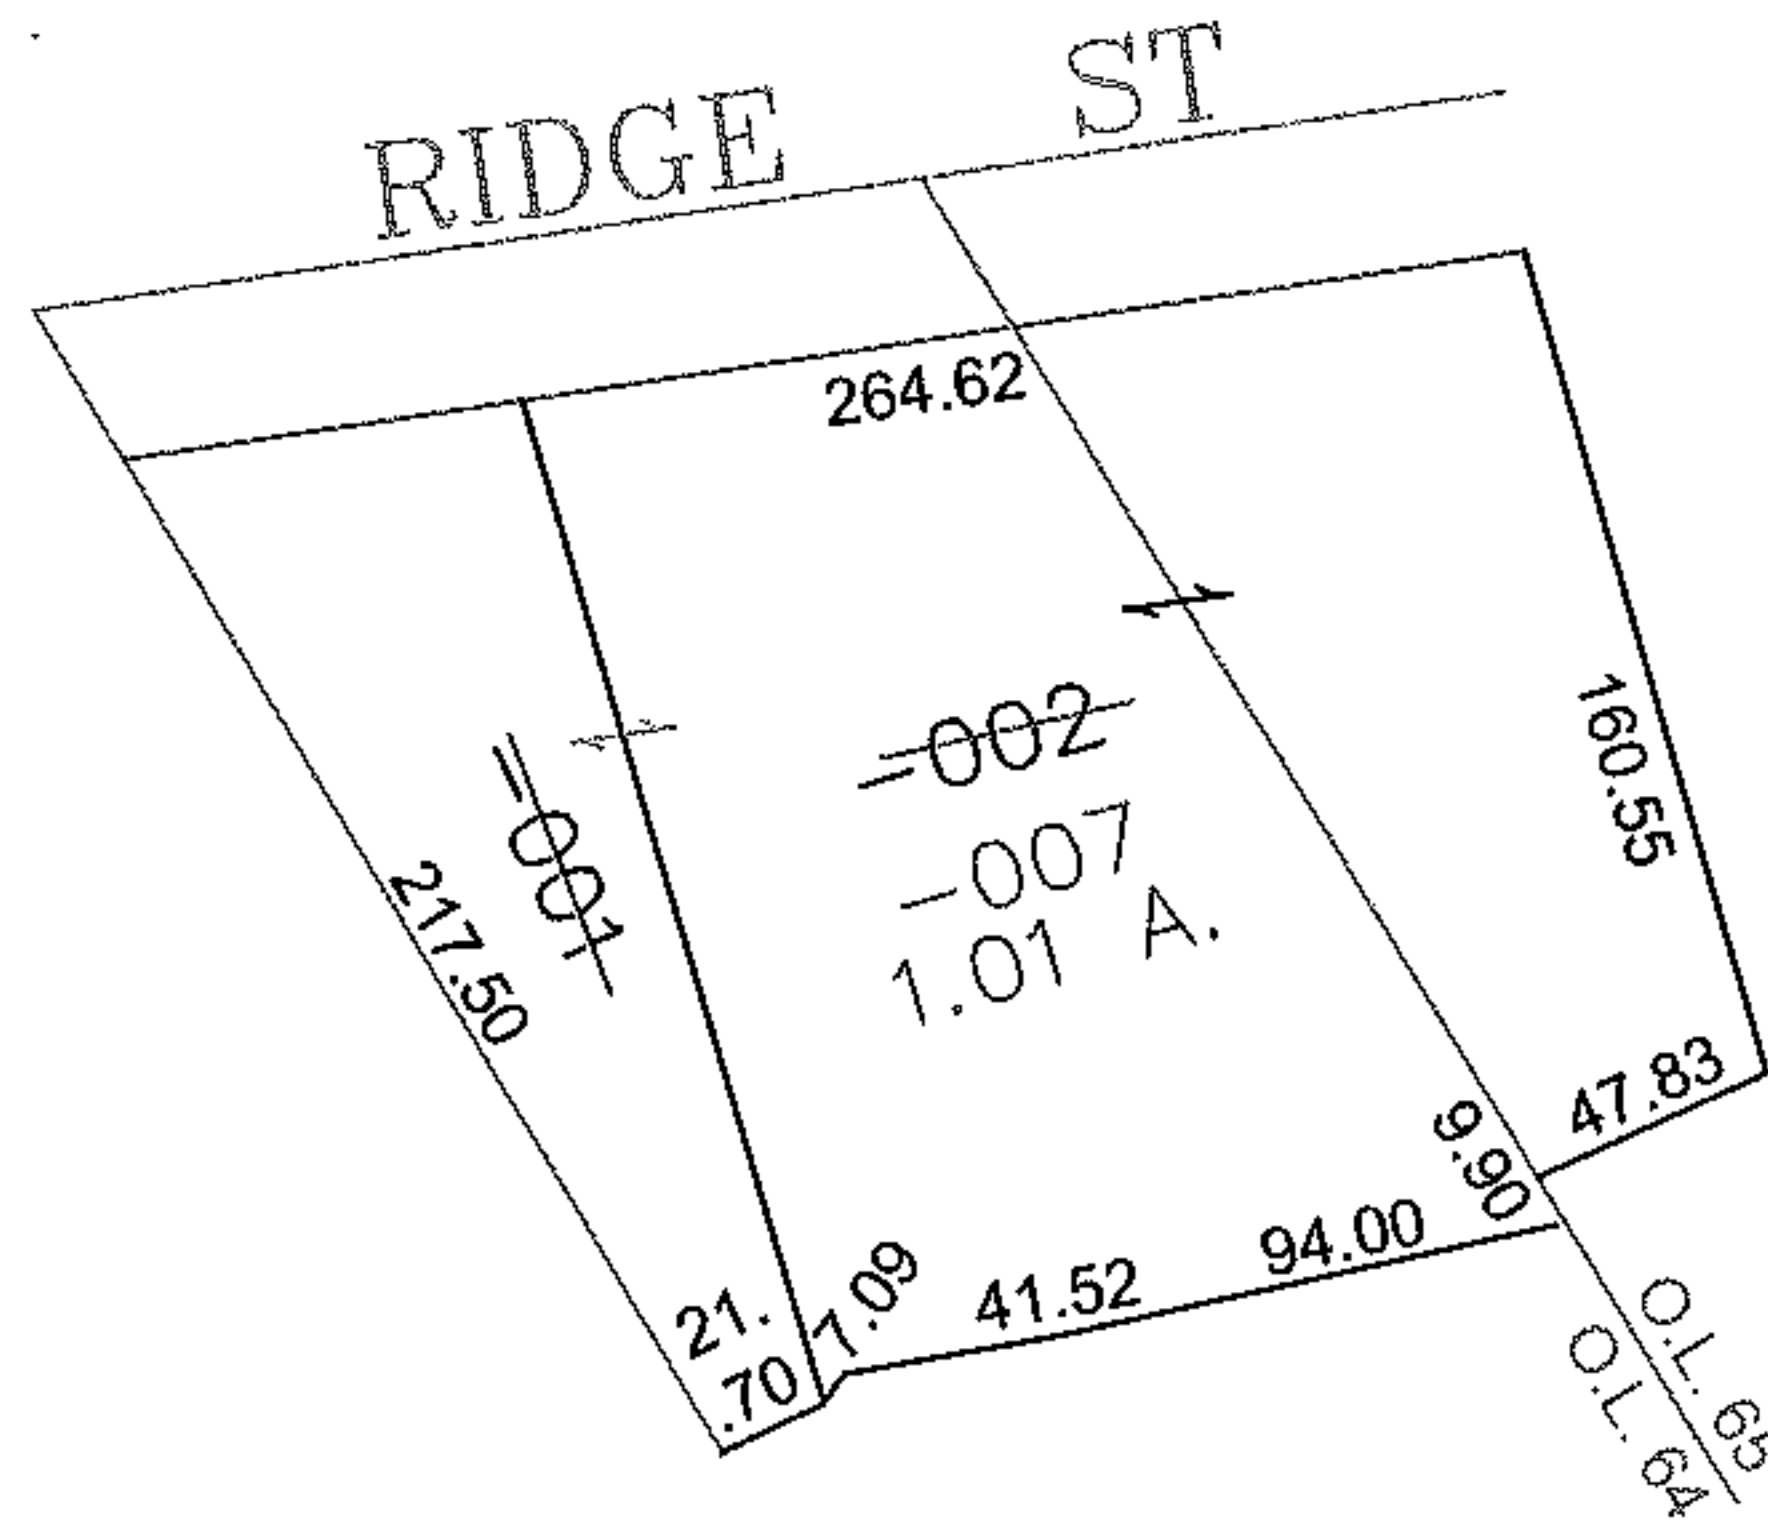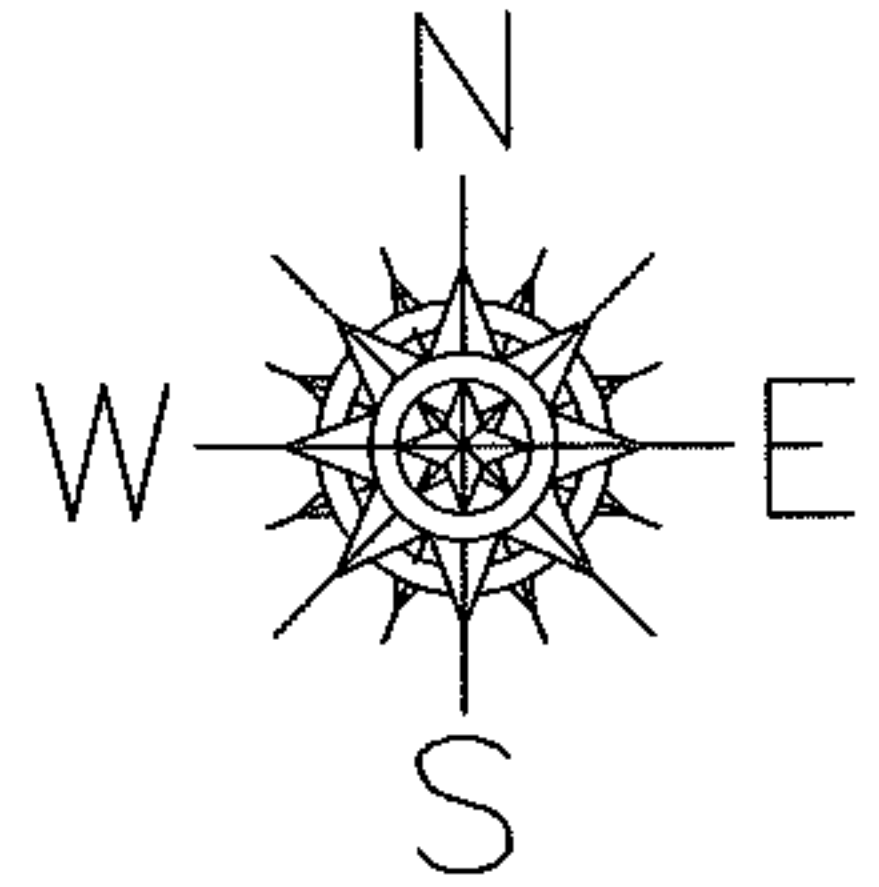

SPLITS/DEEDS PROCESSED

LORAIN COUNTY TAX MAP DEPARTMENT  
226 MIDDLE AVE. ELYRIA, OHIO

SURVEYED BY: KSA

CLOSURE: 0.00 : 10,000

MAP PAGE(S): 6-103

APPROVED BY: JAH DATE: 2/13/2012

SCALE: 1" = 100 PRIOR INSTRUMENT: 20100356440