



RASTER

07-02442

PARENT PARCEL: 04-00-011-107-097

CHILD PARCEL: 04-00-011-107-175, -176

STARTING POINT: CENTERLINE OF STONEY RIDGE RD & MARRIMAN TRAIL

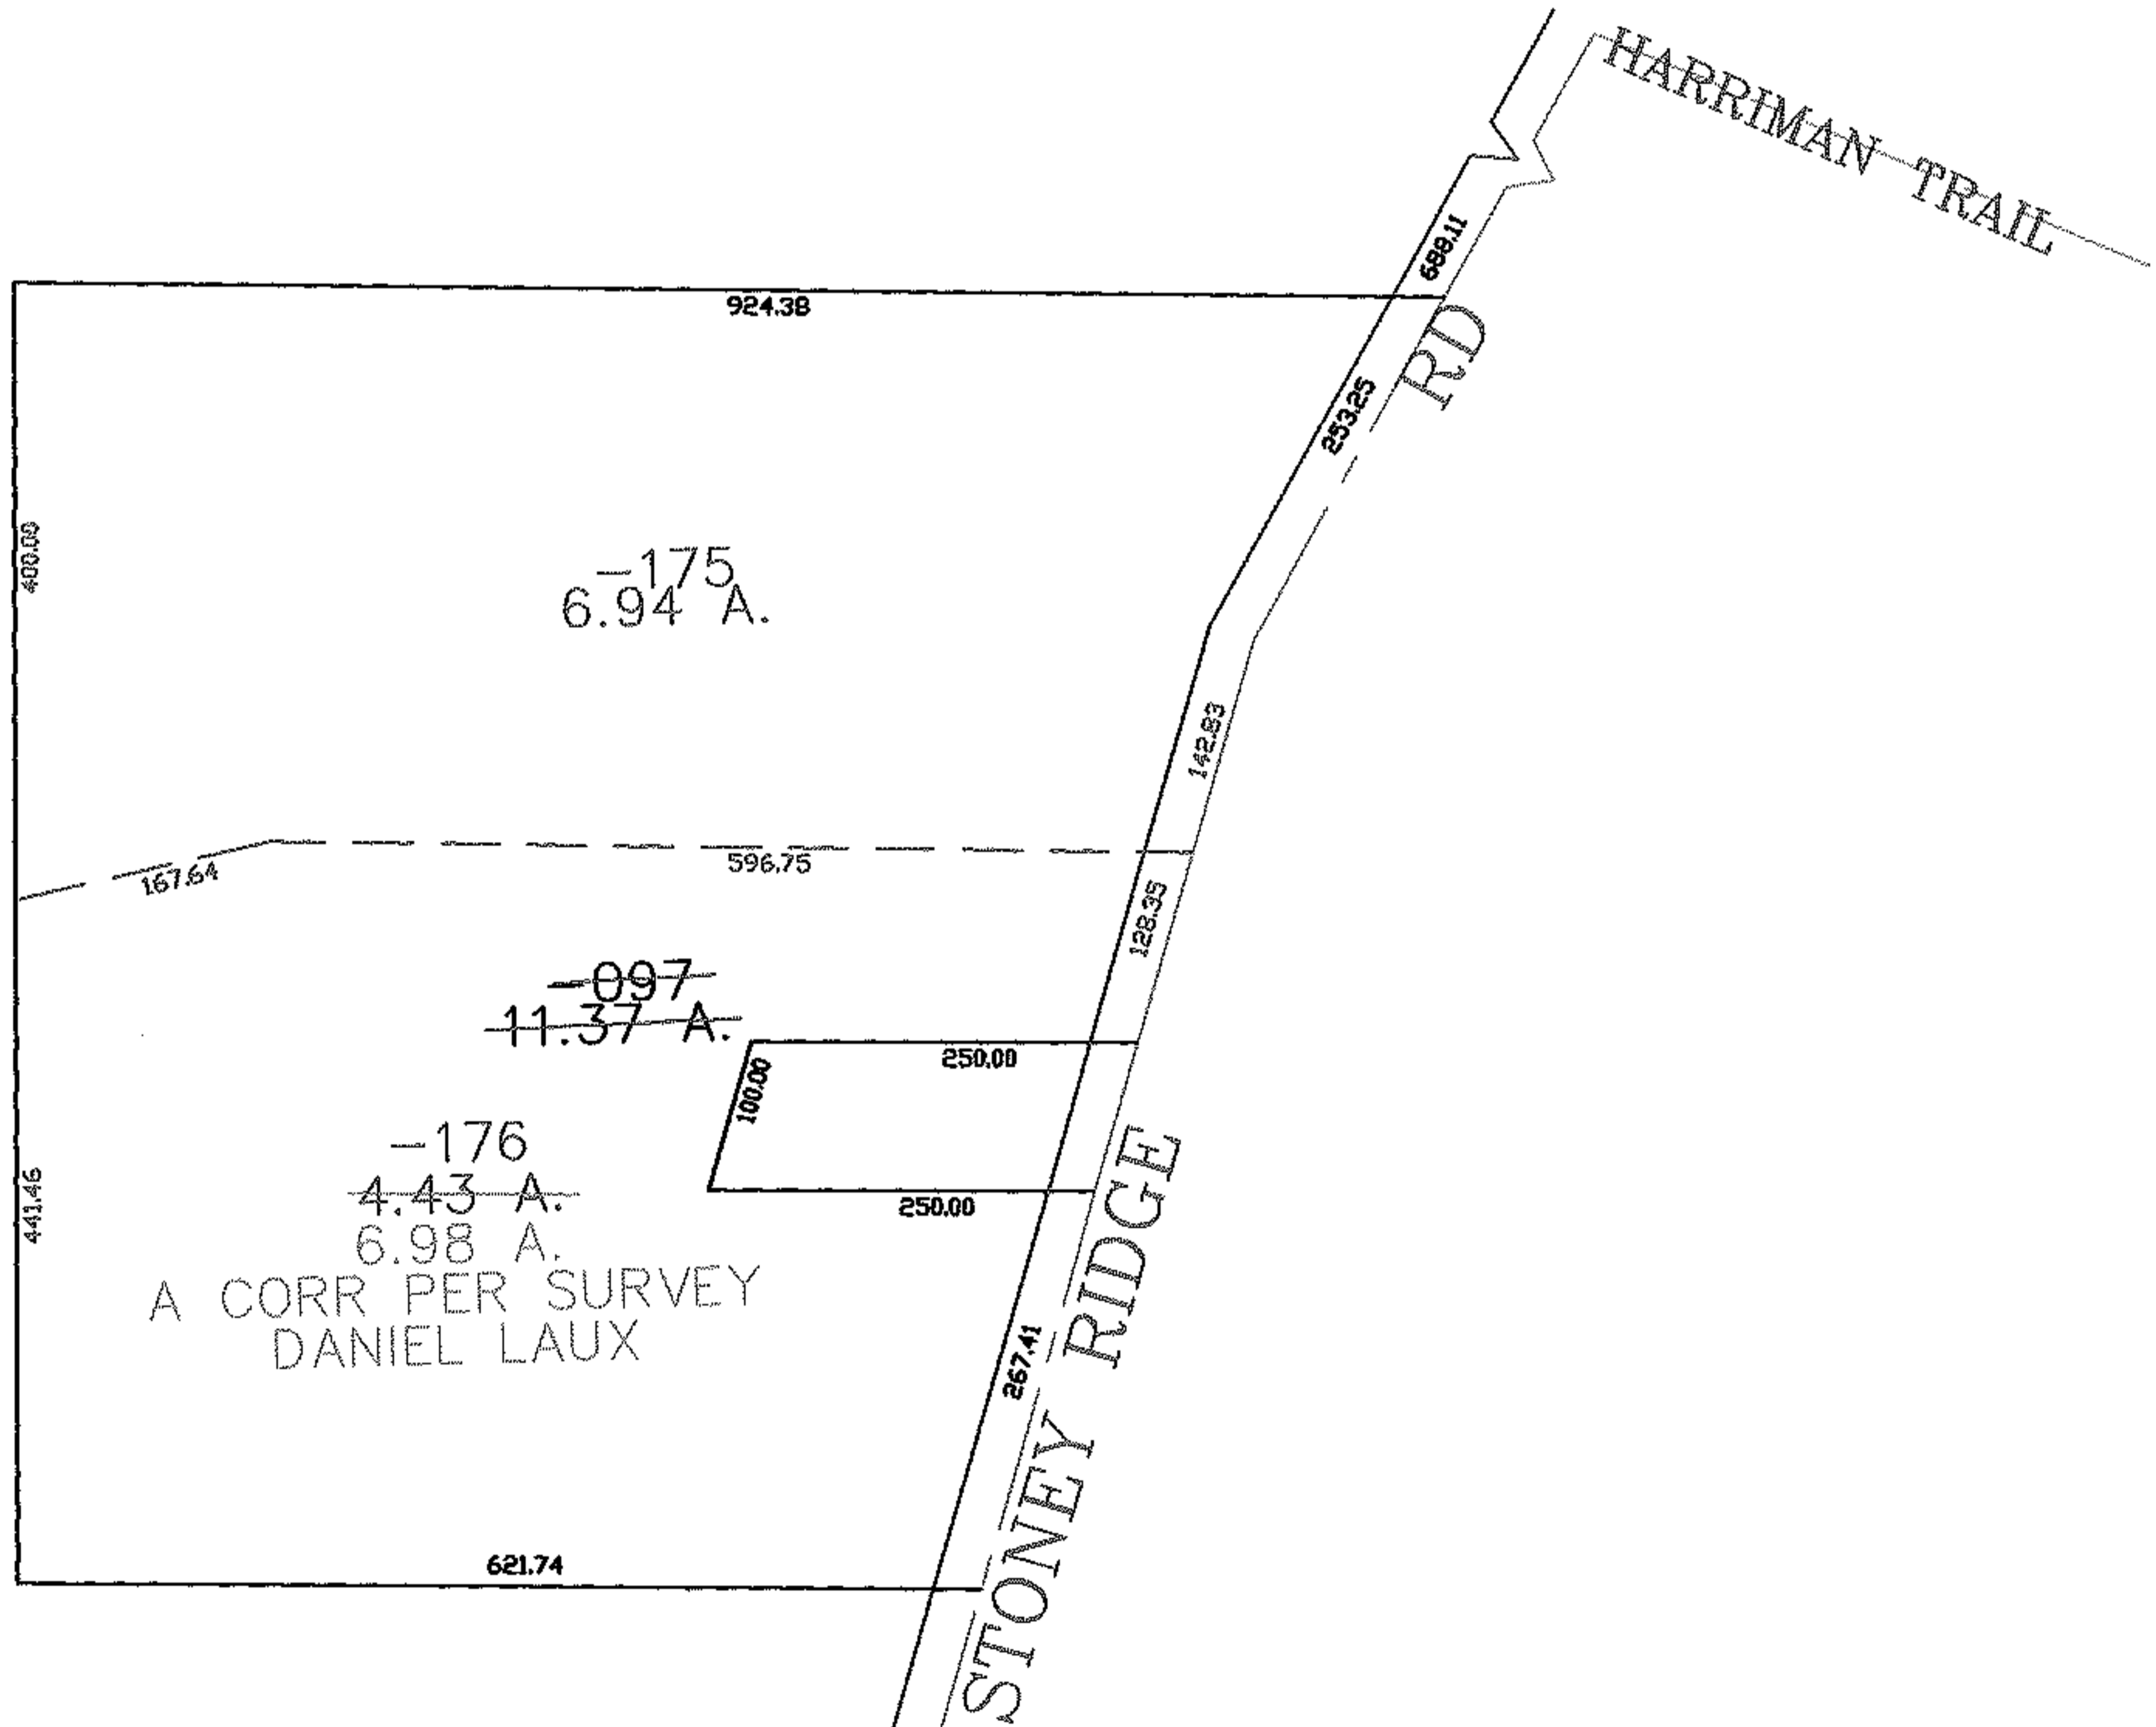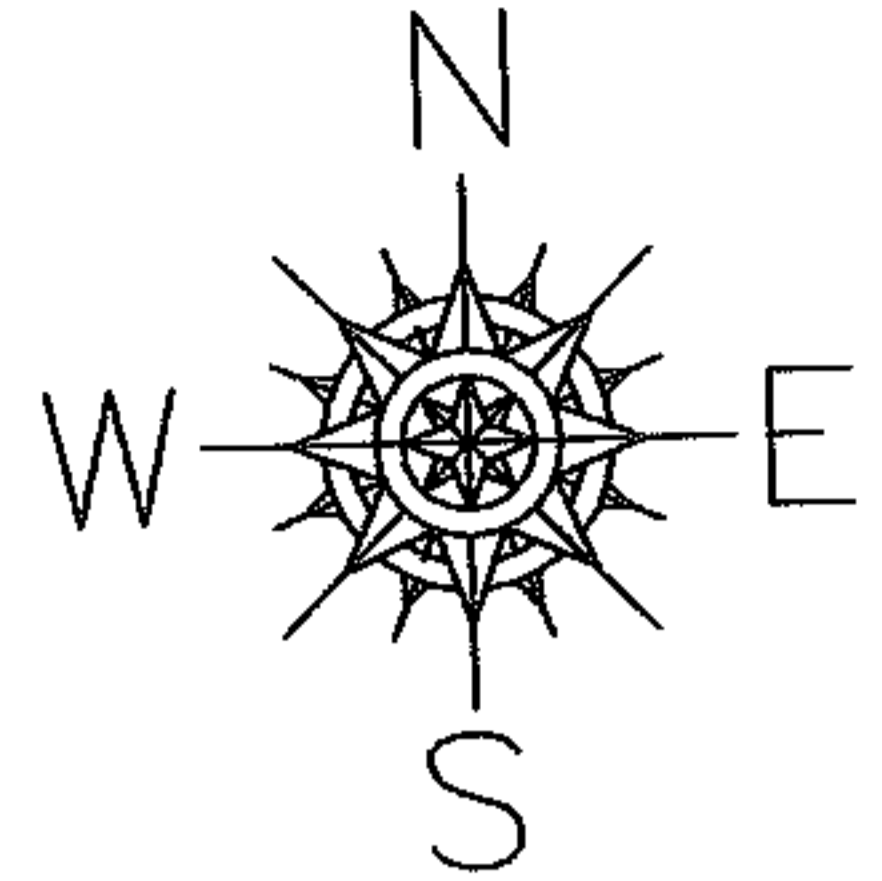

**SPLITS/DEEDS PROCESSED**

LORAIN COUNTY TAX MAP DEPARTMENT  
226 MIDDLE AVE. ELYRIA, OHIO

SURVEYED BY: DANIEL LAUX

CLOSURE: 0.00 : 10.000

MAP PAGE(S): 04-00-011-G

APPROVED BY: JAH DATE: 8-13-07

SCALE: 1" = 200 PRIOR INSTRUMENT: 19980580829