
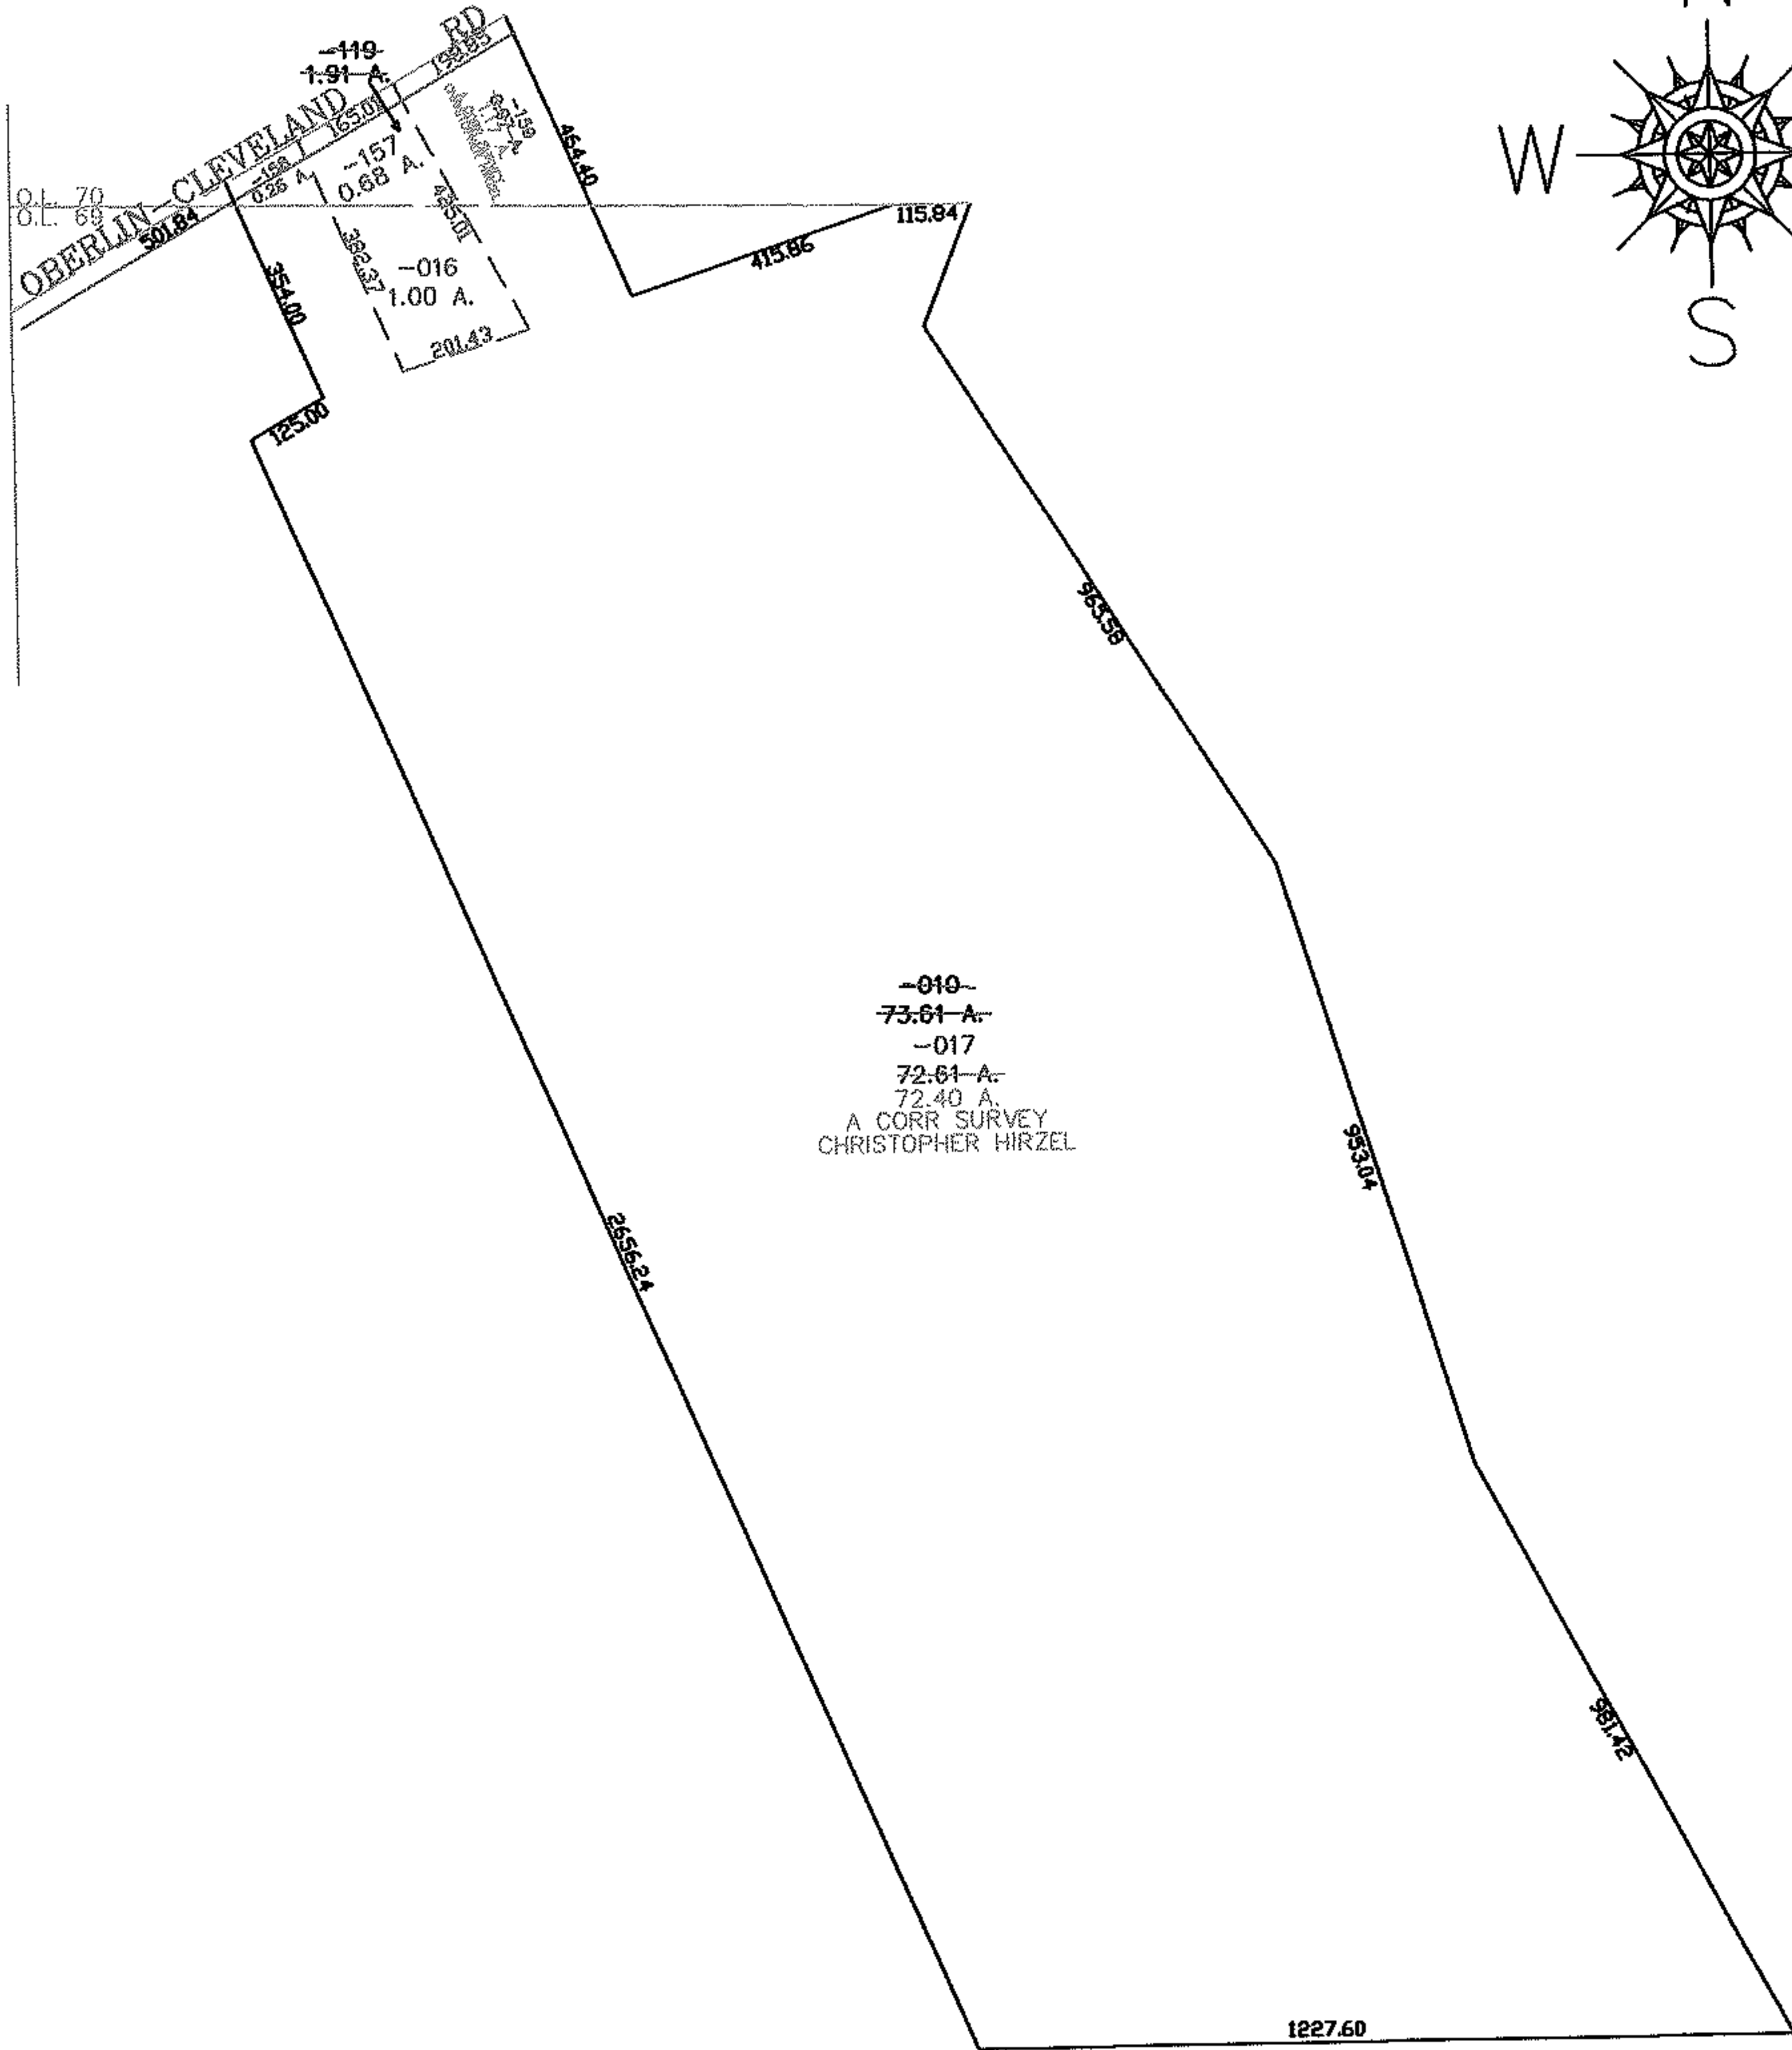



RASTER

PARENT PARCEL: 11-00-069-000-010, 11-00-070-000-119
CHILD PARCEL: 11-00-069-000-016, -017 11-00-070-000-157 THRU -159
STARTING POINT: CENTERLINE OF OBERLIN-CLEVELAND RD & O.L. 69

07-02443

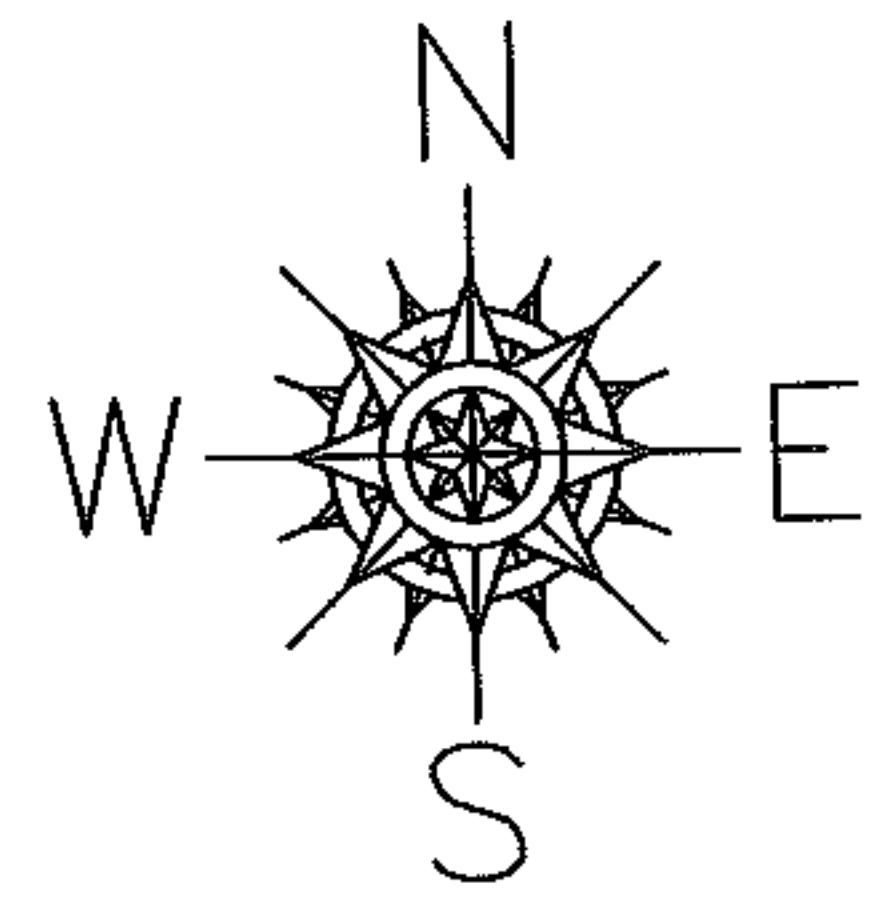

-010-
73.61 A.
-017
72.61 A.
72.40 A.
A CORR SURVEY
CHRISTOPHER HIRZEL

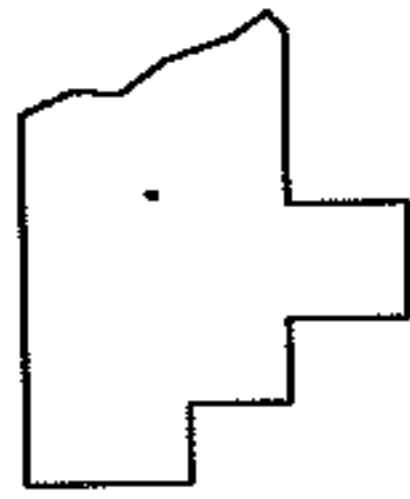

SPLITS/DEEDS PROCESSED

LORAIN COUNTY TAX MAP DEPARTMENT
226 MIDDLE AVE. ELYRIA, OHIO

SURVEYED BY: CHRISTOPHER HIRZEL
CLOSURE: 0.00 : 10.000
MAP PAGE(S): 11-00-069-B
APPROVED BY: JAH DATE: 8-14-07
SCALE: 1" = 400 PRIOR INSTRUMENT: 20030952096