


PARENT PARCEL: 01-00-005-104-012

CHILD PARCEL: _____

STARTING POINT: SOUTHWEST CORNER OF S/L 8 IN SHADY LAKE ACRES (VOL. 22 PG.6)

12-02444-D

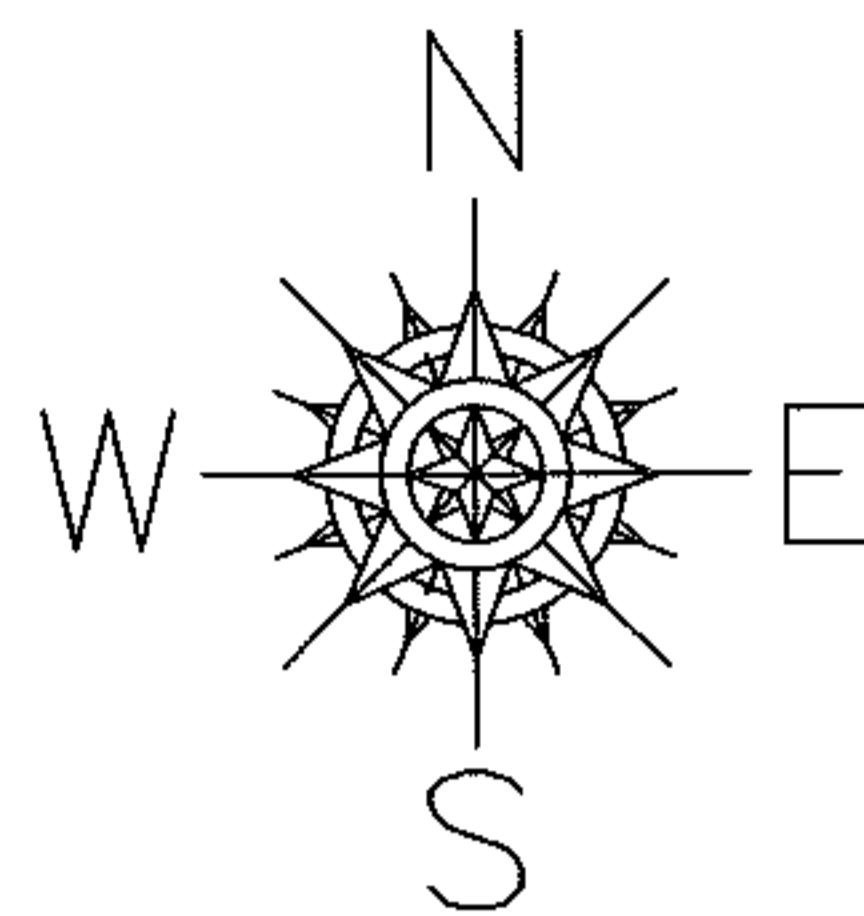

MAP CORRECTION ONLY

SUNNYSIDE RD.

116.64

168.89

15.00

~~66.72~~
66.62


8 -005

84.09

244.62

55.55
~~55.54~~

SHADY LAKE

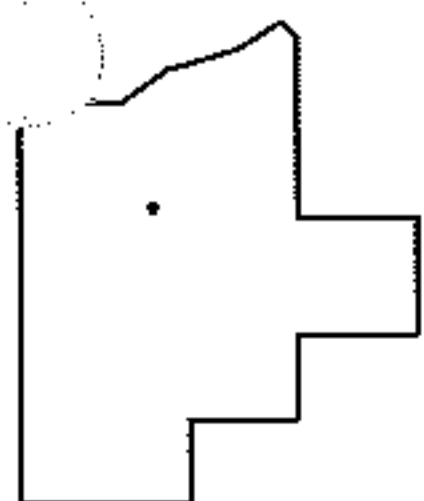

SPLITS/DEEDS PROCESSED

LORAIN COUNTY TAX MAP DEPARTMENT
226 MIDDLE AVE. ELYRIA, OHIO

SURVEYED BY: JAMES P. YURKSCHATT

CLOSURE: .01:10.000

MAP PAGE(S): 1-00-005-C

APPROVED BY: RRM DATE: 2-15-12

SCALE: 1"= 50' PRIOR INST.: 19990627022