


PARENT PARCEL: 05-00-012-101-026

CHILD PARCEL: _____

STARTING POINT: NORTHWEST CORNER OF S/L 16 IN B. GREBE'S SUB. (VOL.8 PG.17)

12-02445-A

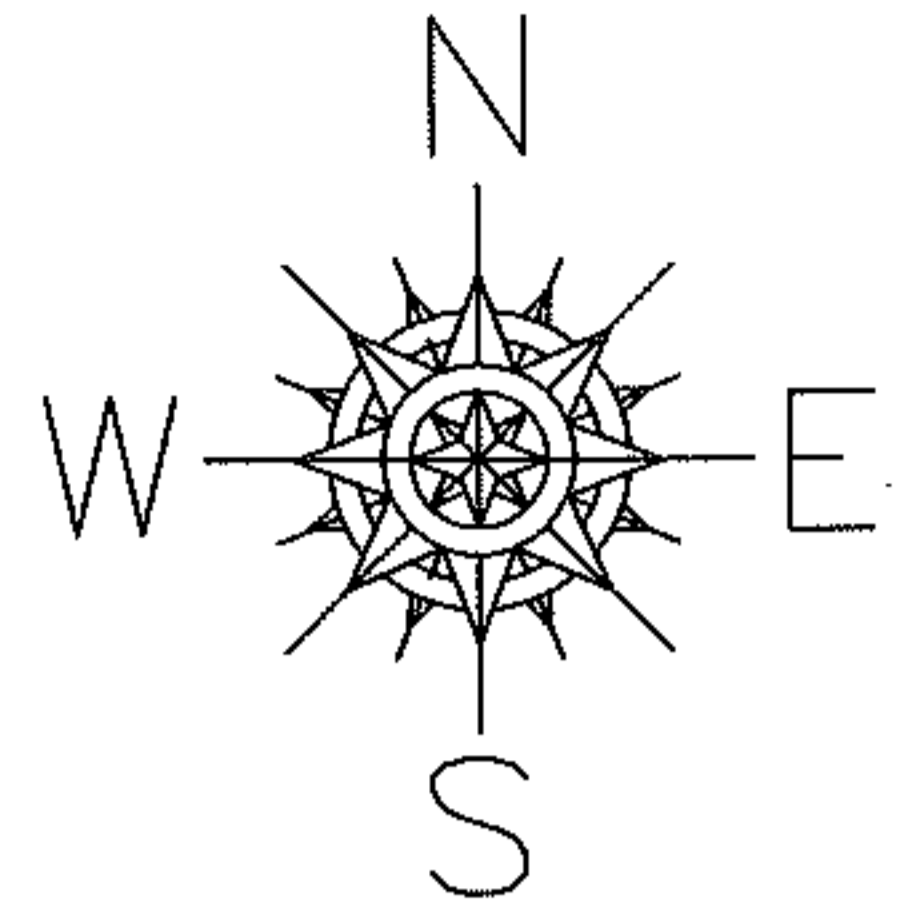

GREBE ST.

98.12

330.00

-026
~~0.75 A.~~
0.74 A.


AC.CORR.PER PRIOR DEEDS

95.96

330.00

S/L 16

B. GREBE'S SUB.
VOL.8 PG.17

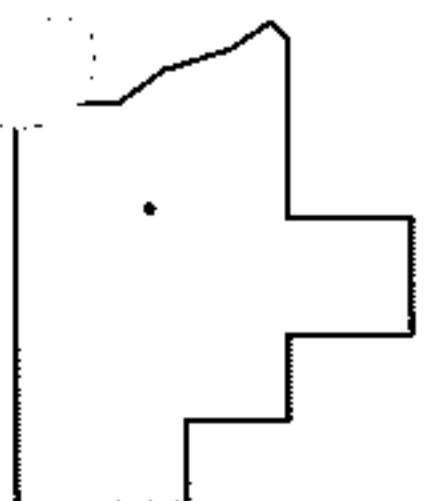

SPLITS/DEEDS PROCESSED

LORAIN COUNTY TAX MAP DEPARTMENT
226 MIDDLE AVE. ELYRIA, OHIO

SURVEYED BY: N/A

CLOSURE: N/A

MAP PAGE(S): 5-00-012-A

APPROVED BY: RRM DATE: 2-22-12

SCALE: 1"= 50' PRIOR INST.: 20040038927