
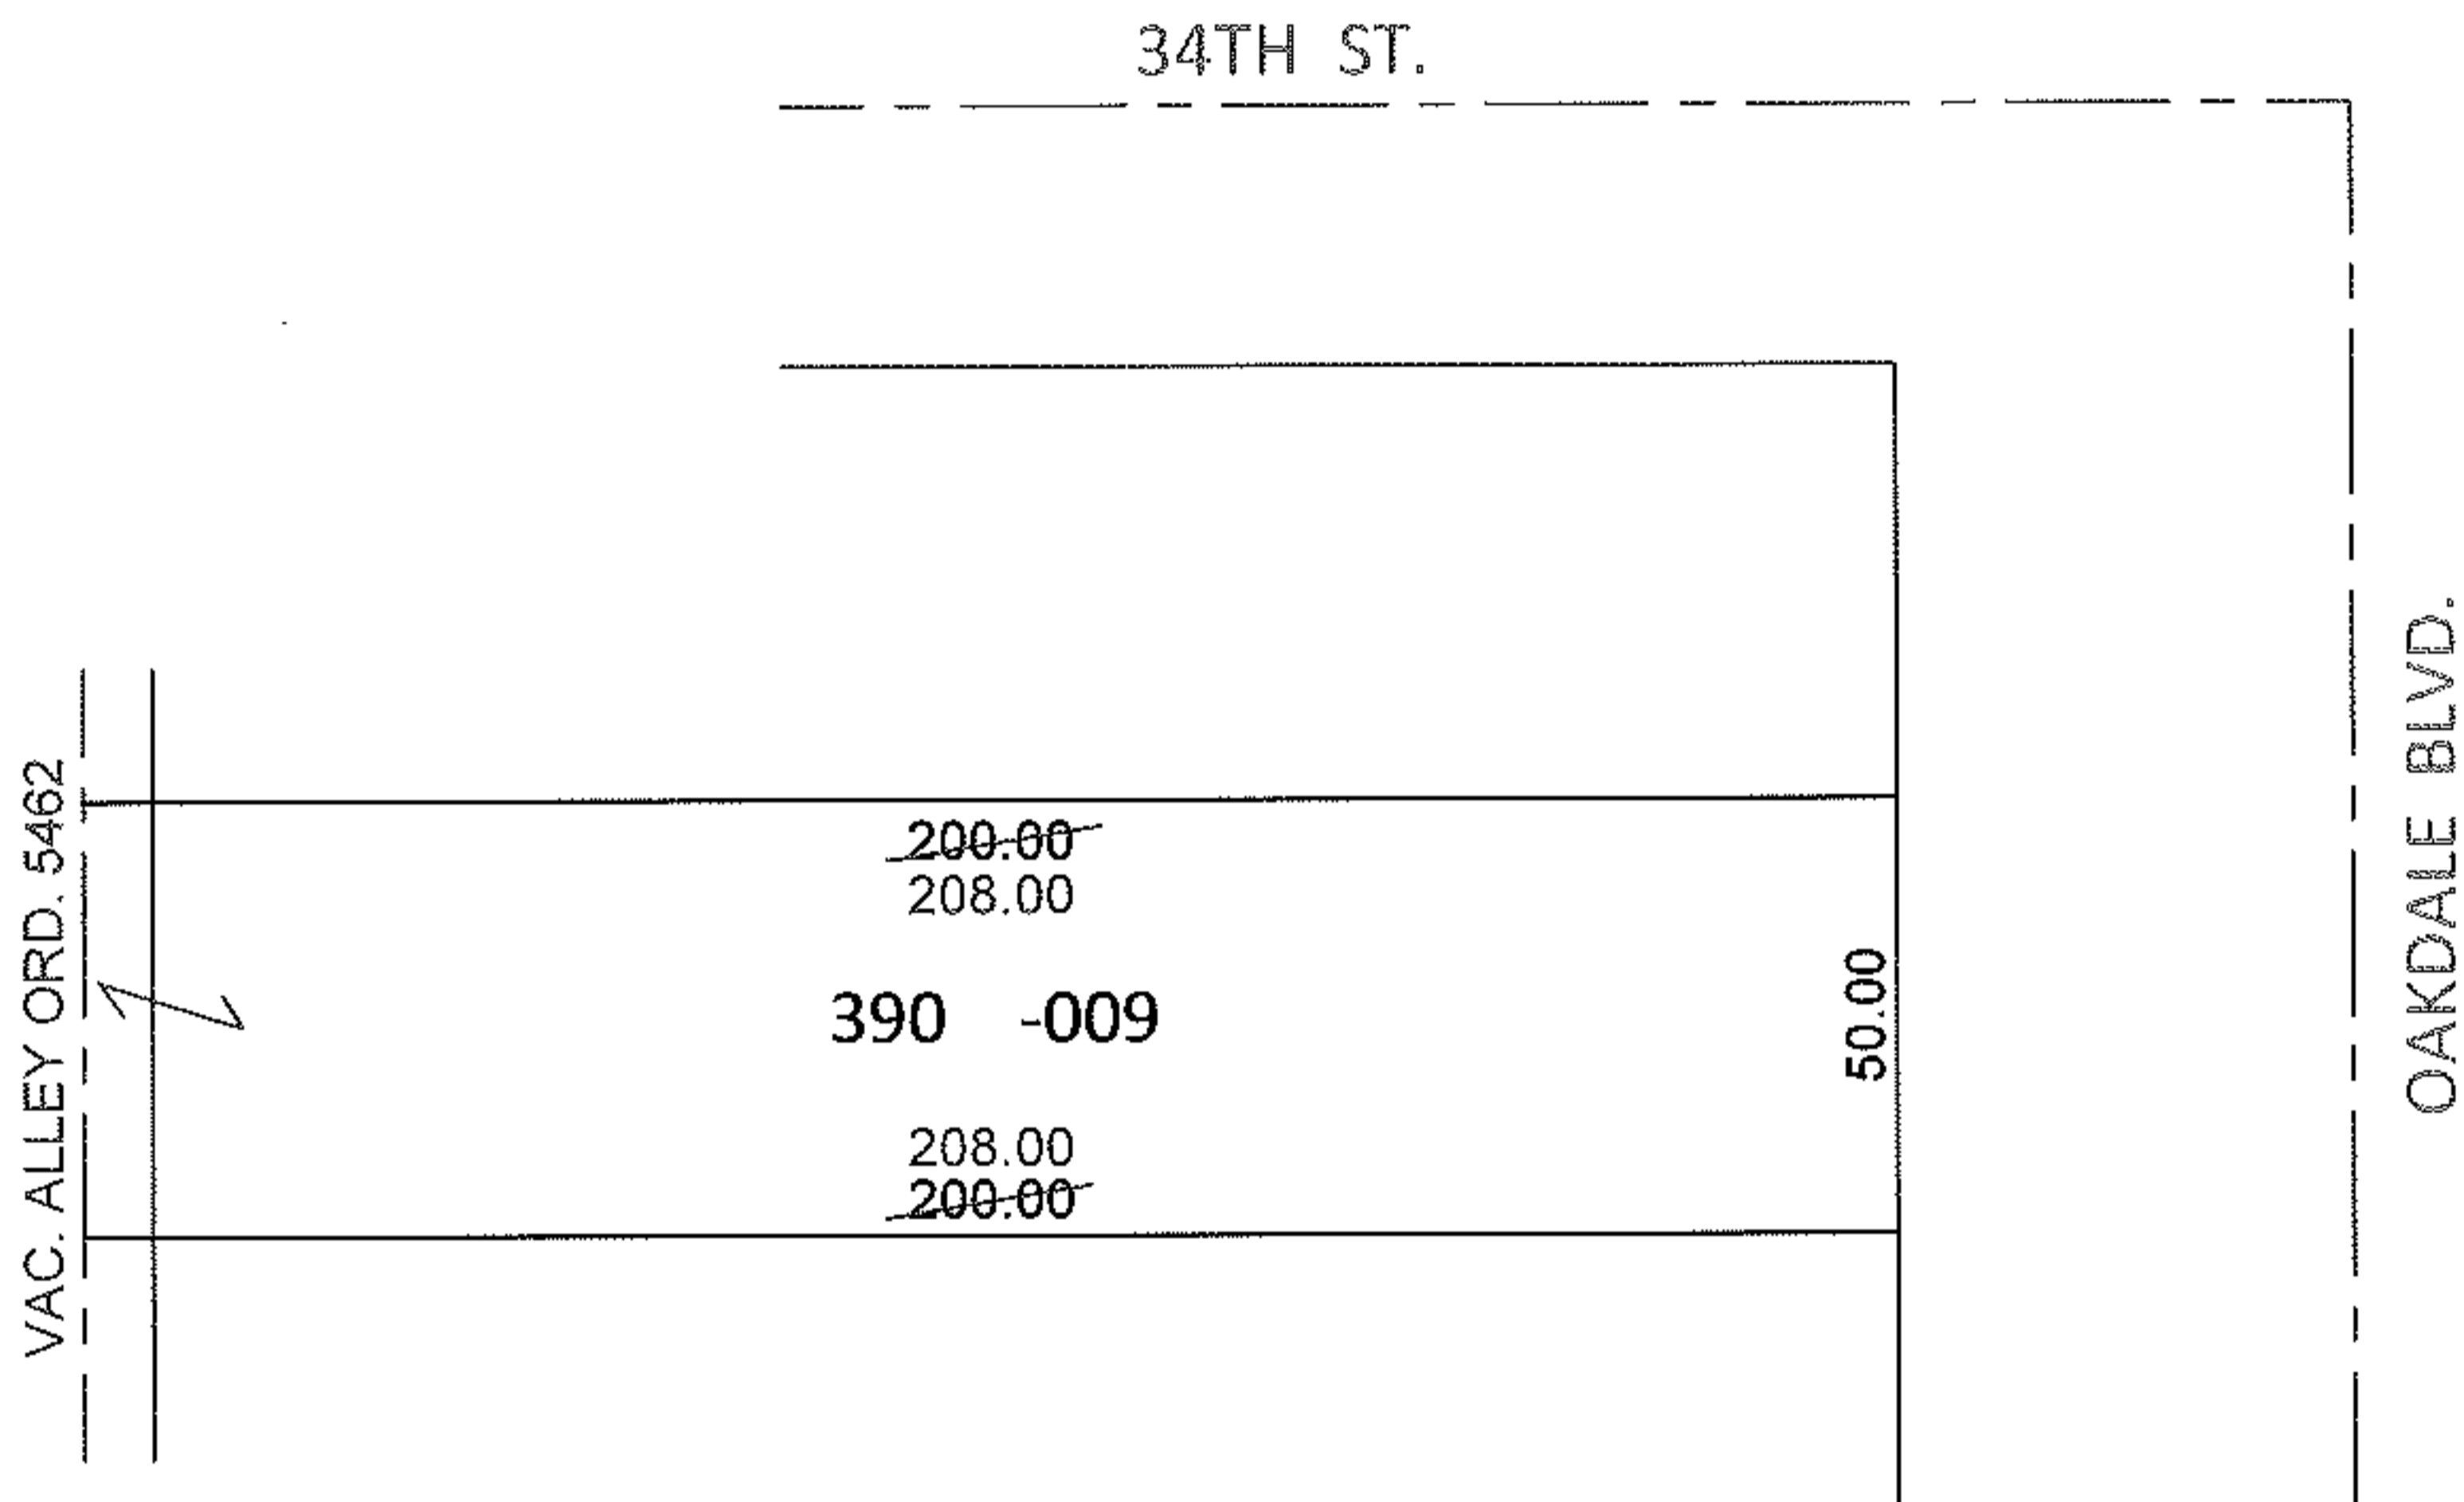


PARENT PARCEL: 02-01-003-230-009

CHILD PARCEL: \_\_\_\_\_

STARTING POINT: S/L 390 IN LORAIN STONE CO.'S 2ND SUB. (VOL.6 PG.38)

12-02446-C

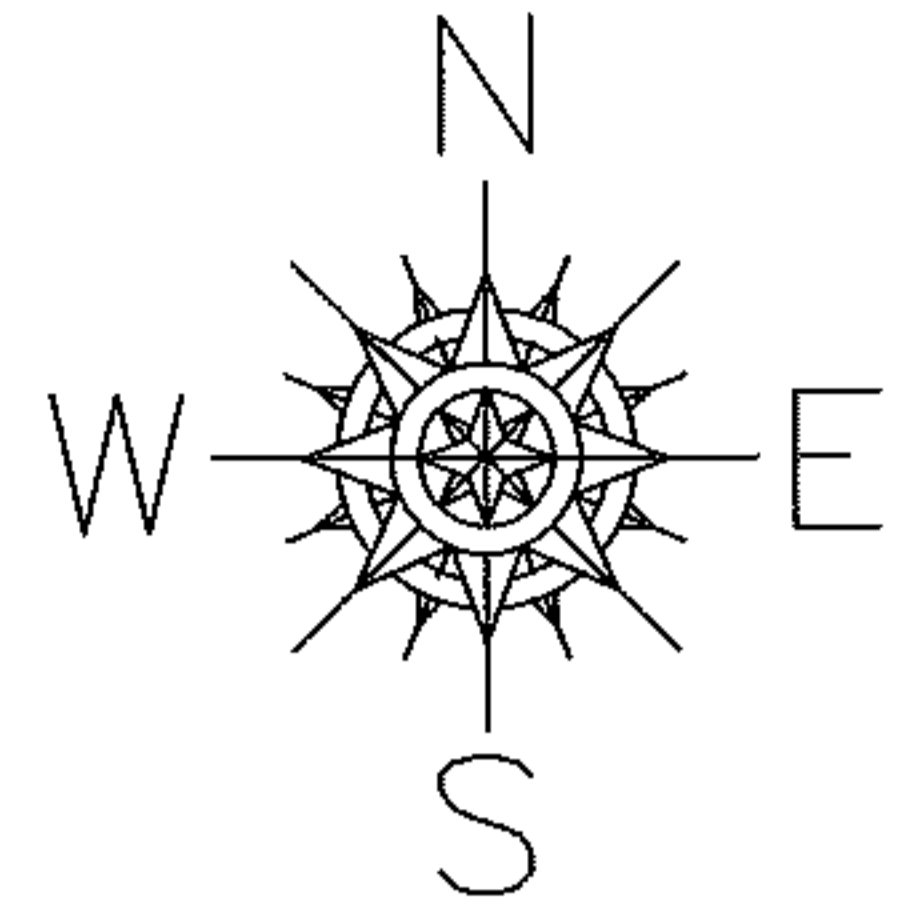

DEPTH CORRECTION

02-01-003-230-009

208

50 X ~~200~~

PER DEED & ORD. NO. 5462

SPLITS/DEEDS PROCESSED

LORAIN COUNTY TAX MAP DEPARTMENT  
226 MIDDLE AVE. ELYRIA, OHIO

SURVEYED BY: N/A

CLOSURE: N/A

MAP PAGE(S): 2-01-003-1

APPROVED BY: RRM DATE: 2-23-12

SCALE: 1" = 50' PRIOR INST.: 20110395001