


MASTER

PARENT PARCEL: 12-00-003-000-046, -054 12-0-004-000-006, -007


CHILD PARCEL: 12-00-003-000-078, 12-00-004-000-046

STARTING POINT: CENTERLINE OF SNELL RD & MARKS RD

07-02447

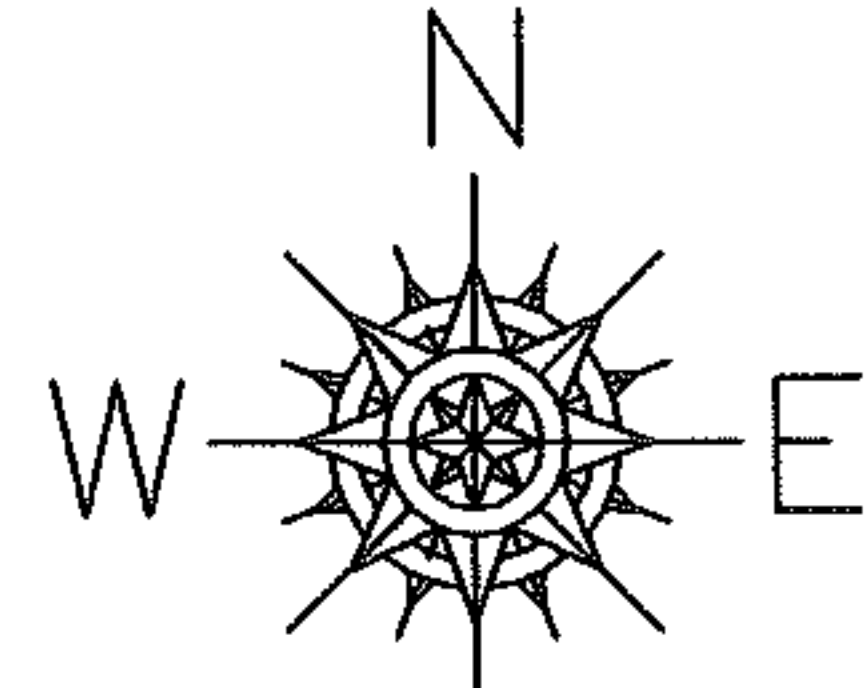

MARKS RD

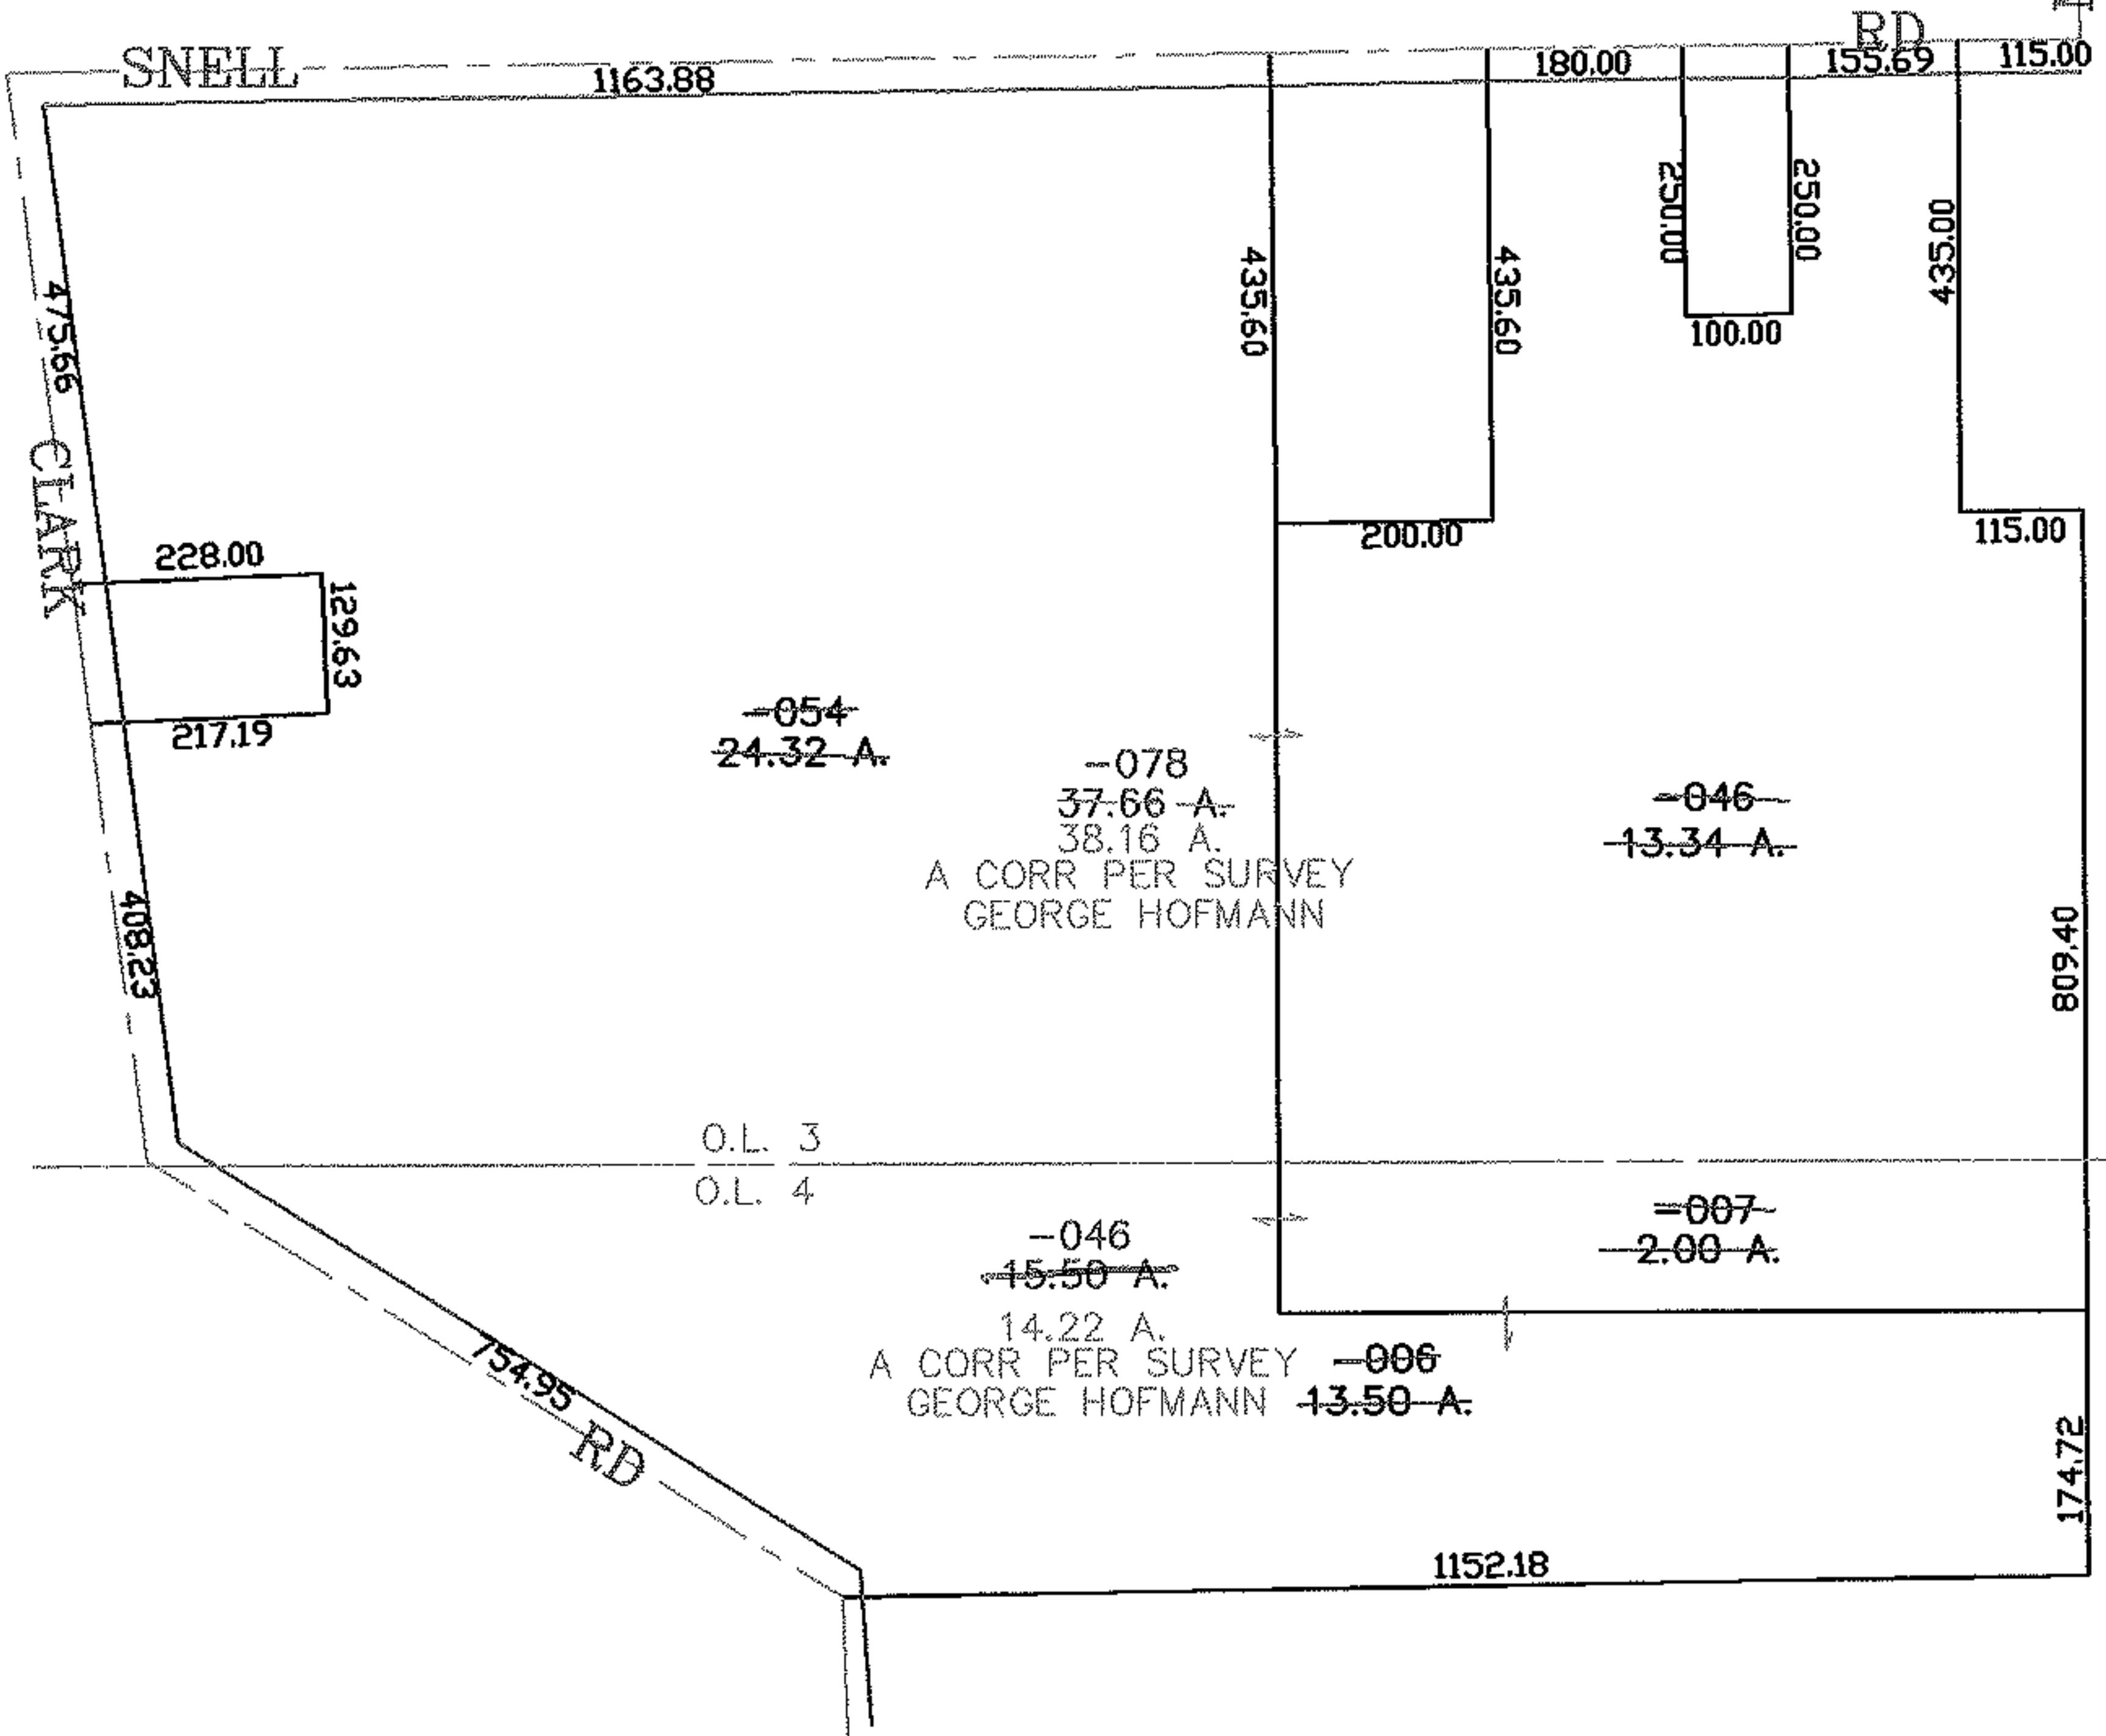

**SPLITS/DEEDS PROCESSED**  
 LORAIN COUNTY TAX MAP DEPARTMENT  
 226 MIDDLE AVE. ELYRIA, OHIO

SURVEYED BY: GEORGE HOFMANN  
 CLOSURE: 0.00 : 10.000  
 MAP PAGE(S): 12-00-003-A  
 APPROVED BY: JAH DATE: 8-20-07  
 SCALE: 1" = 300 PRIOR INSTRUMENT: 20070216264