
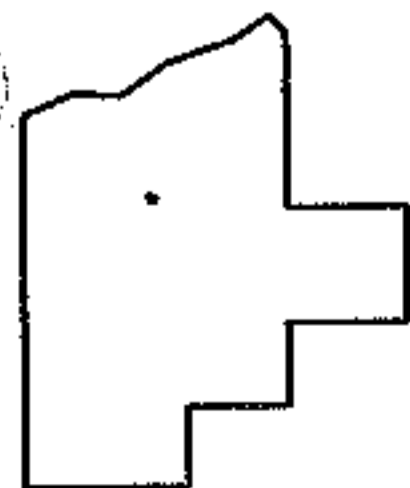
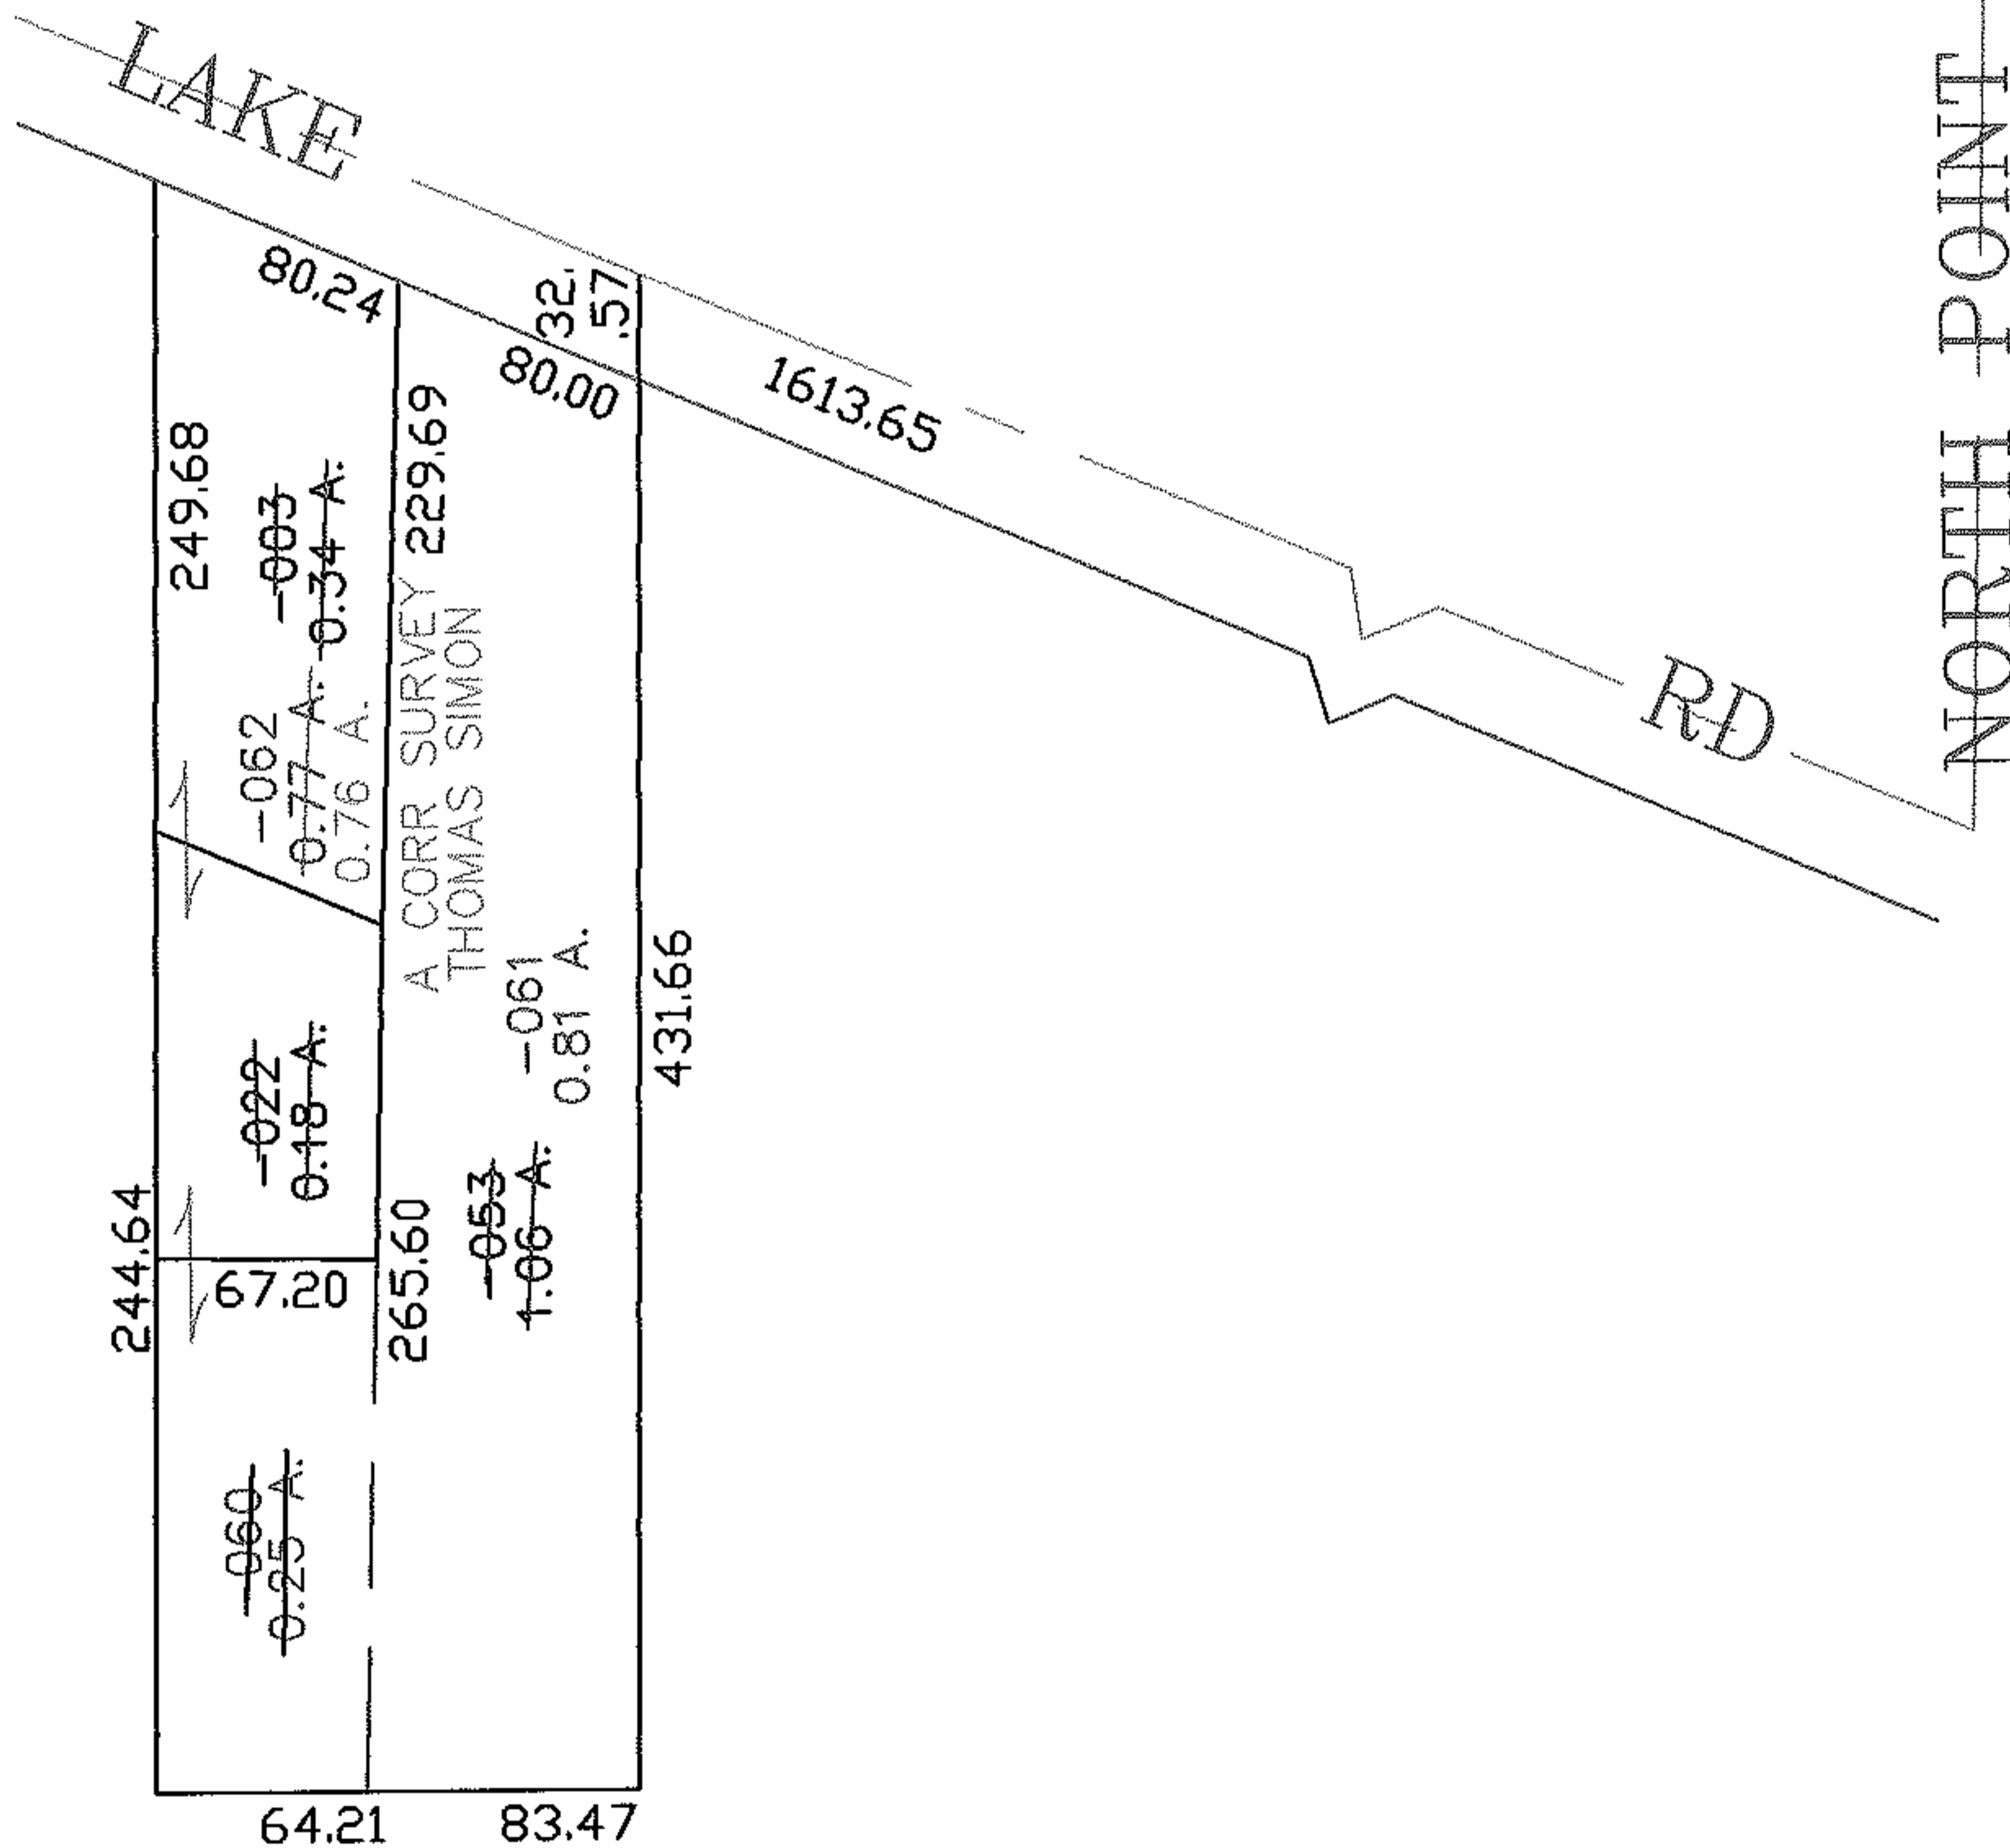


PARENT PARCEL: 04-00-019-114-053, -003, -022

07-02450

CHILD PARCEL: 04-00-019-114-060 THRU -062

STARTING POINT: CENTERLINE OF NORTH POINT DR & LAKE RD

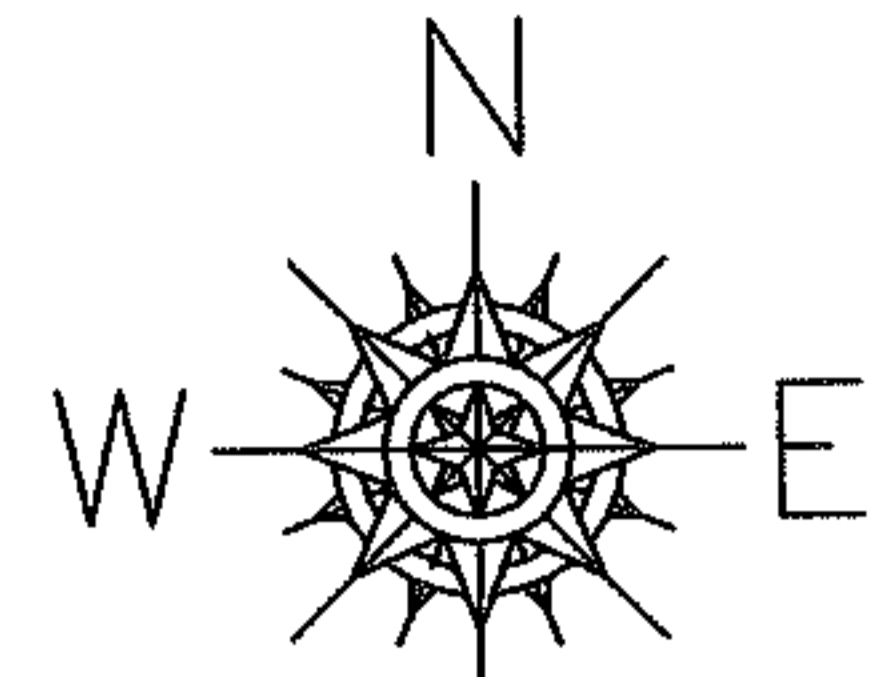

SPLITS/DEEDS PROCESSED

LORAIN COUNTY TAX MAP DEPARTMENT
226 MIDDLE AVE. ELYRIA, OHIO

SURVEYED BY: THOMAS SIMON

CLOSURE: 0.00 : 10.000

MAP PAGE(S): 04-00-019-C

APPROVED BY: JAH DATE: 9-4-07

SCALE: 1" = 100 PRIOR INSTRUMENT: OR 1145/688