
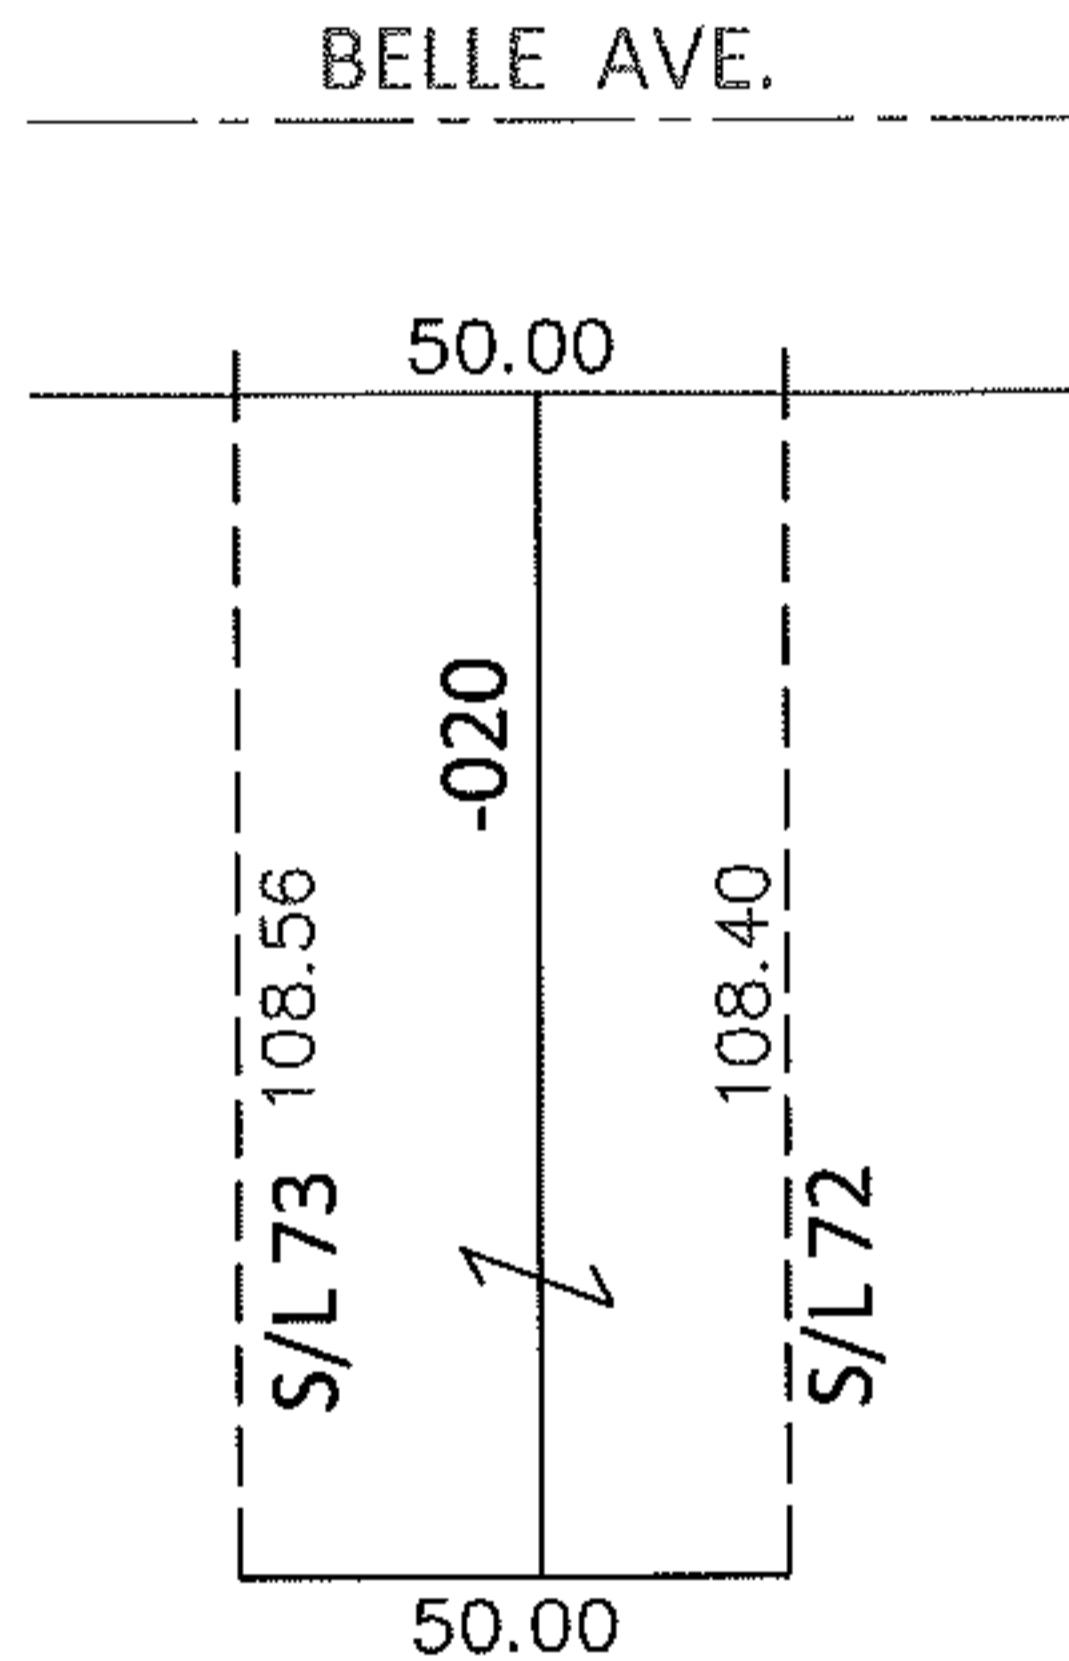


PARENT PARCEL: 03-00-029-104-020

CHILD PARCEL: _____

12-02452-C

STARTING POINT: WESTERLY 27.38 FT OF S/L 72 AND EASTERLY 22.62 FT OF S/L 73 IN KNICKERBOCKER SUB. NO.2(VOL.12 PG.16)

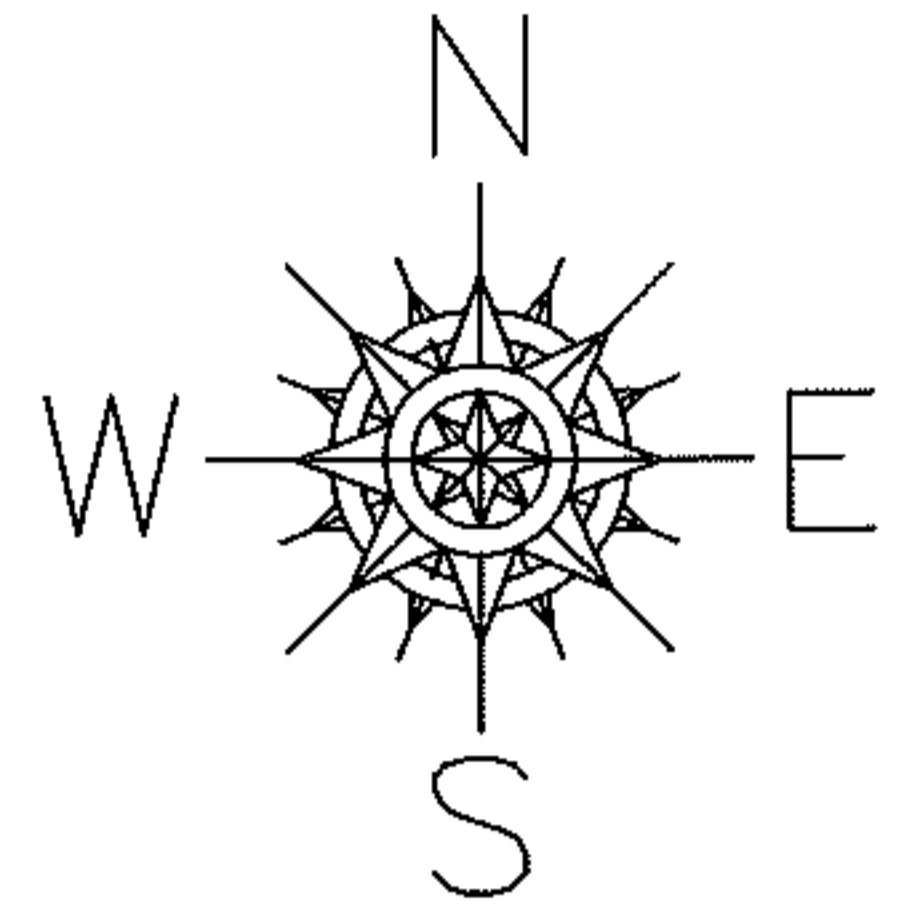


DEPTH CORRECTION

03-00-029-104-020

108.56

50 X ~~108~~

PER PRIOR DEEDS

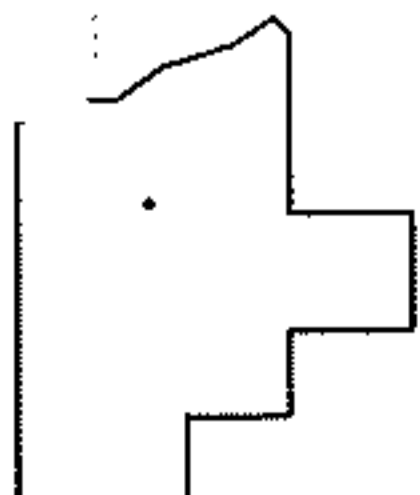

SPLITS/DEEDS PROCESSED

LORAIN COUNTY TAX MAP DEPARTMENT
226 MIDDLE AVE. ELYRIA, OHIO

SURVEYED BY: N/A

CLOSURE: N/A

MAP PAGE(S): 3-00-029-B

APPROVED BY: RRM DATE: 11-19-12

SCALE: 1" = 50' PRIOR INST.: 20100324938