

PARENT PARCEL: 18-00-044-000-064

07-02453

CHILD PARCEL: 18-00-044-000-066, -067

STARTING POINT: CENTERLINE OF PECK-WADSWORTH RD & PITTS RD

PECK-WADSWORTH


RD

312.49

200.00

3140.83

350.00

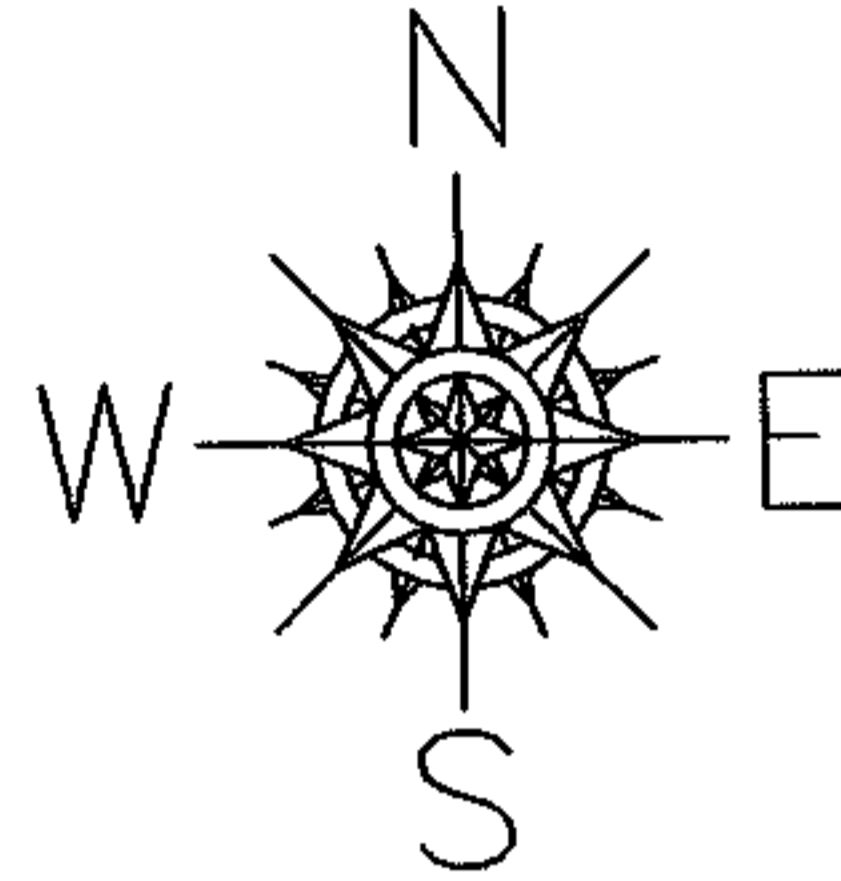

PITTS RD

1383.53

-066
9.72 A.

~~-064~~
~~16.07 A.~~

1383.59

-067
6.35 A.

1383.59

299.70

200.00

SPLITS/DEEDS PROCESSED

LORAIN COUNTY TAX MAP DEPARTMENT
226 MIDDLE AVE. ELYRIA, OHIO

SURVEYED BY: THOAS SNEZEK

CLOSURE: 0.00 : 10.000

MAP PAGE(S): 18-00-044-B

APPROVED BY: JAH DATE: 9-10-07

SCALE: 1" = 200' PRIOR INSTRUMENT: 20020806871