
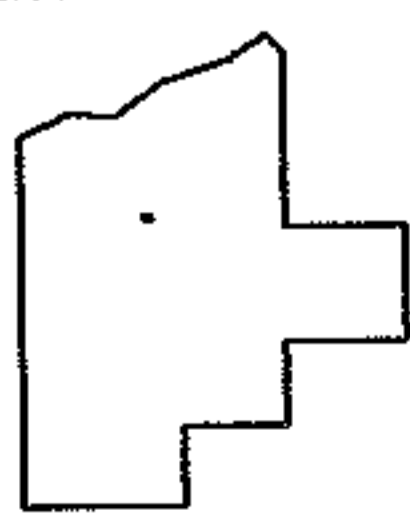
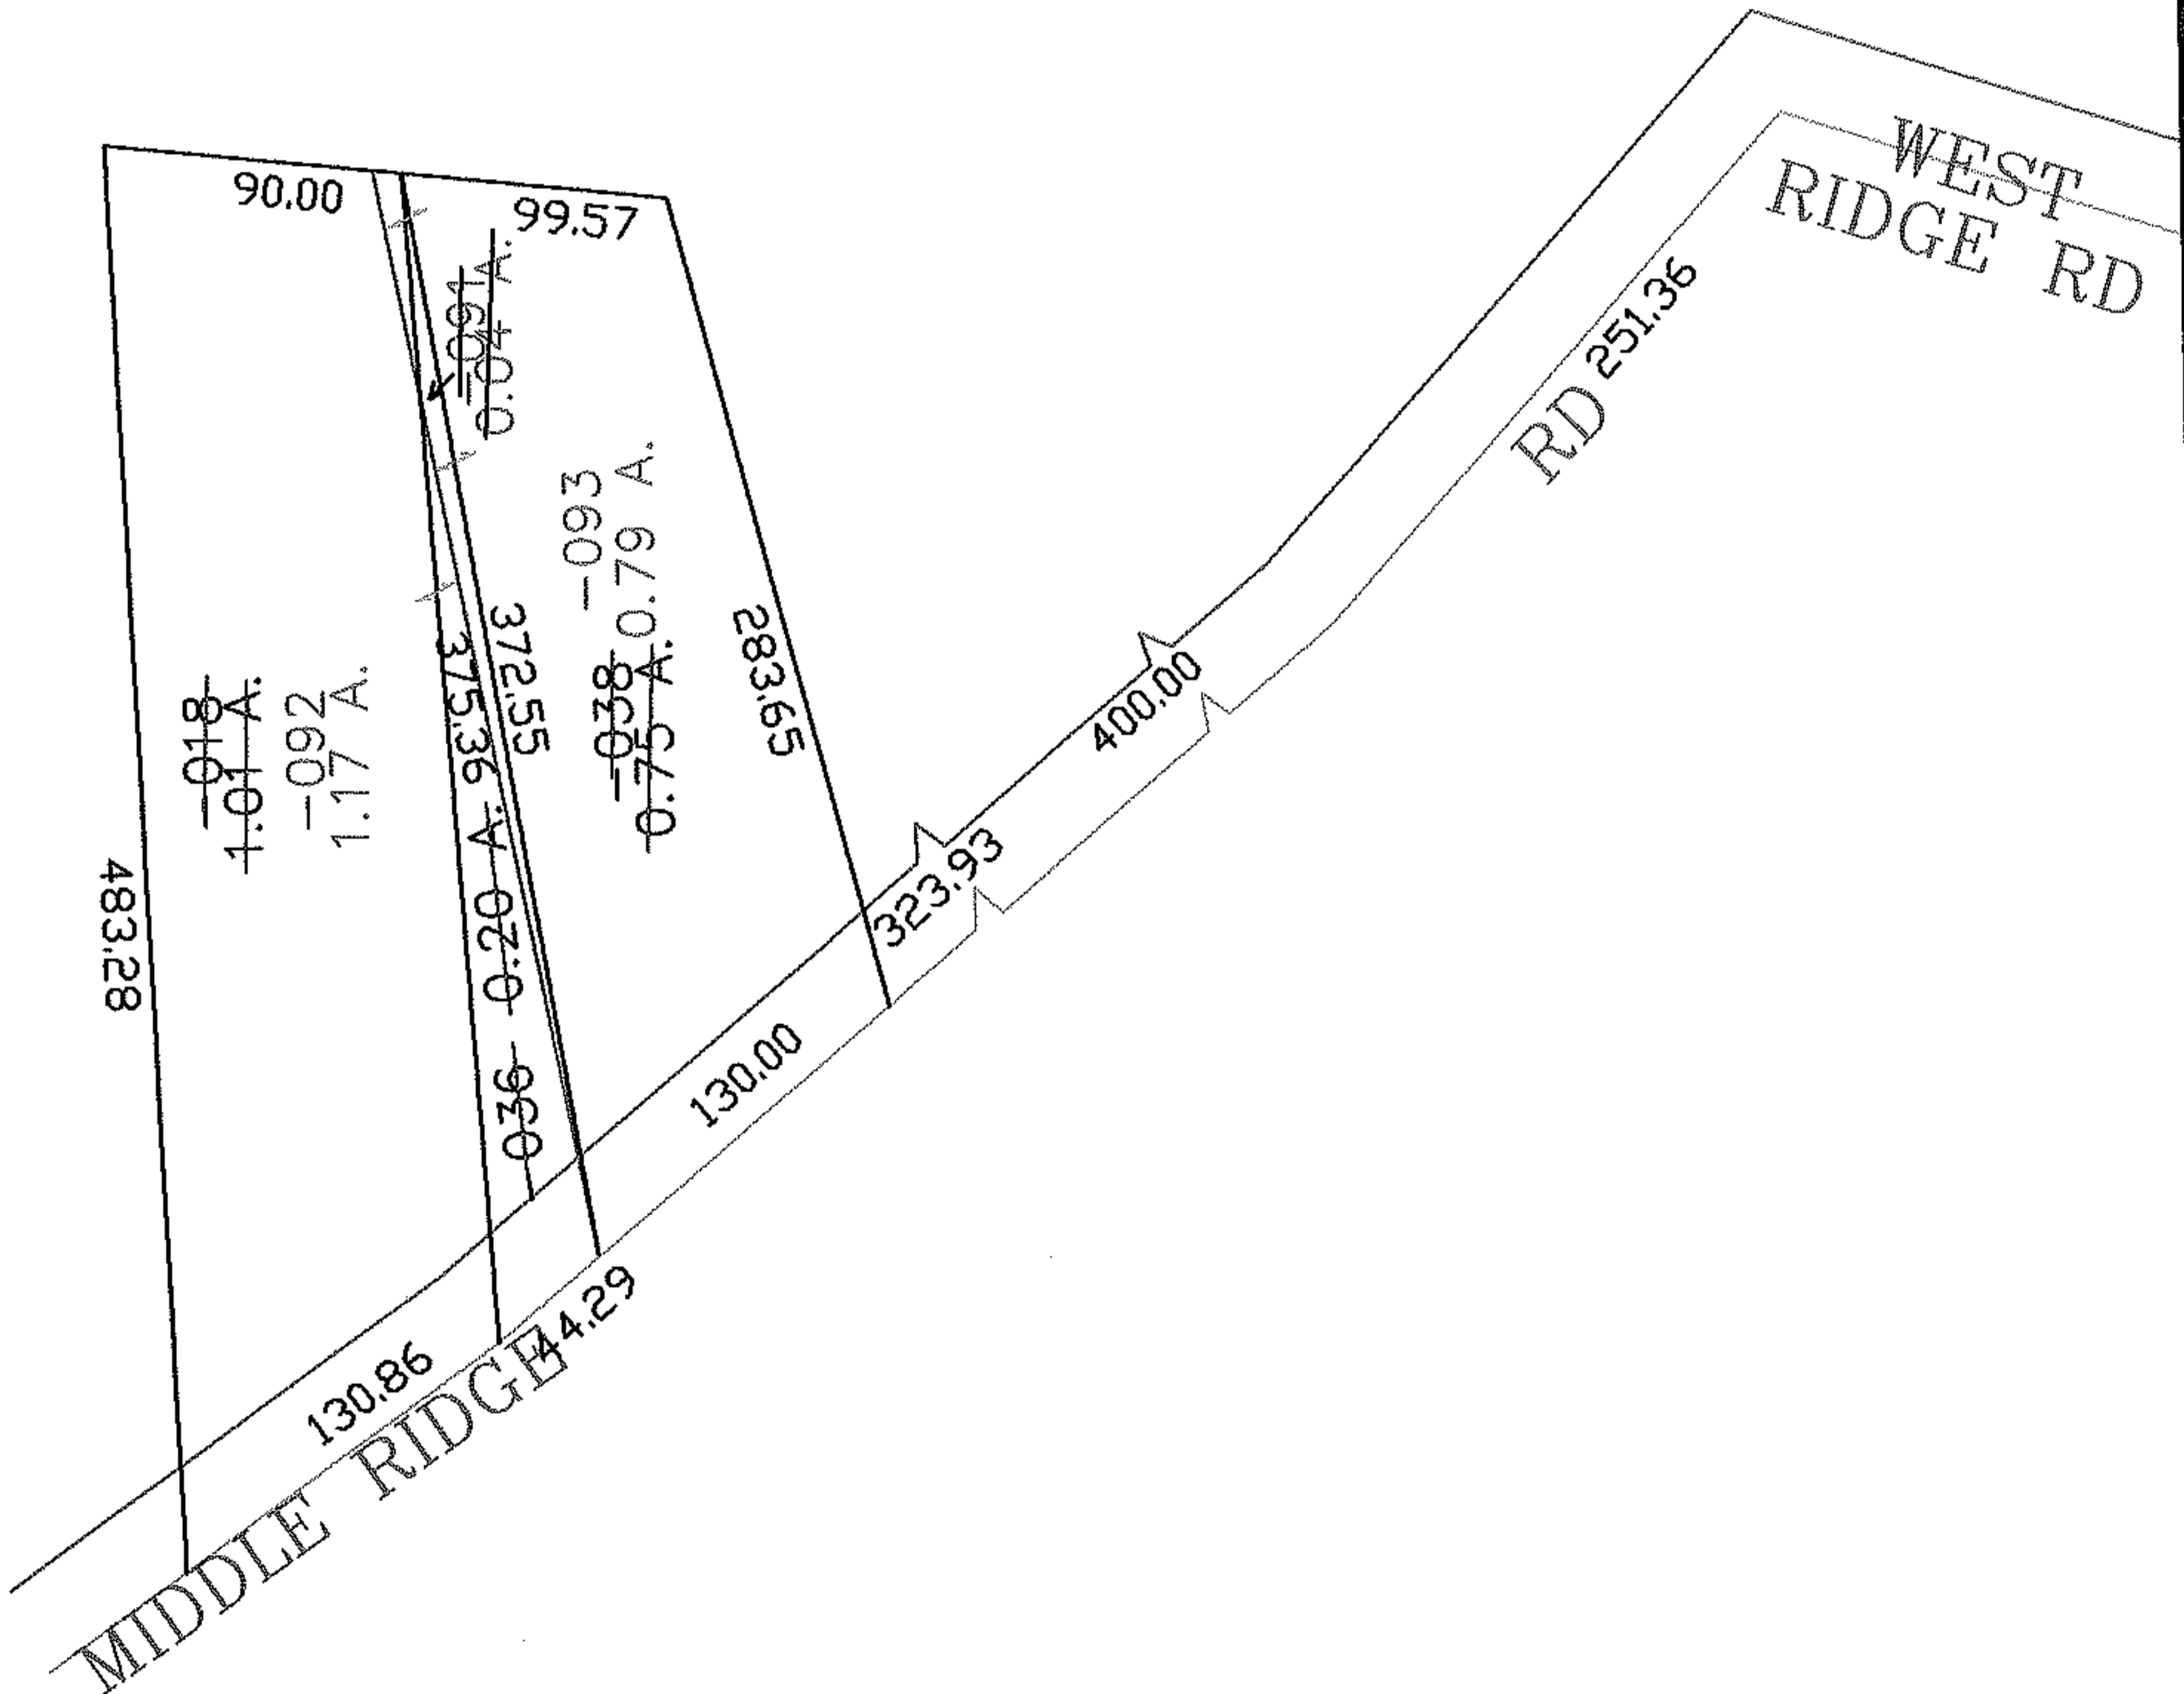


PARENT PARCEL: 05-00-079-000-036, -018, -038

CHILD PARCEL: 05-00-079-000-091 THRU -093

STARTING POINT: CENTERLINE OF MIDDLE RIDGE RD & WEST RIDGE RD

07-02454

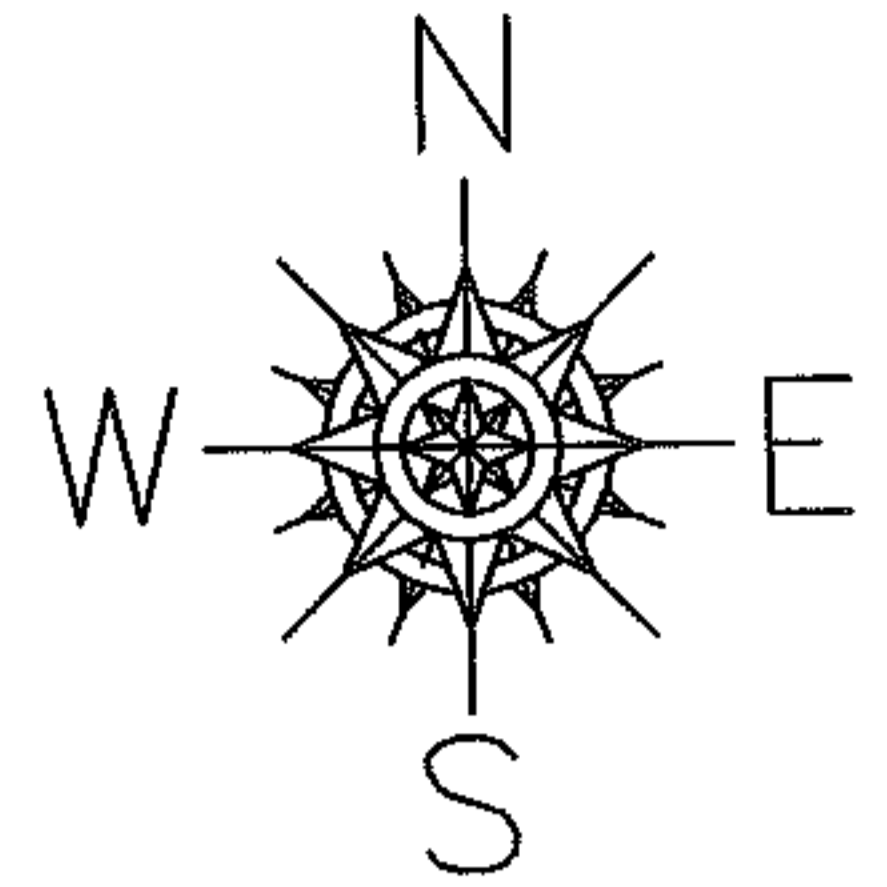

SPLITS/DEEDS PROCESSED

LORAIN COUNTY TAX MAP DEPARTMENT
226 MIDDLE AVE. ELYRIA, OHIO

SURVEYED BY: CHARLES WARYU

CLOSURE: 0.00 : 10.000

MAP PAGE(S): 05-00-079-B

APPROVED BY: JAH DATE: 9-10-07

SCALE: 1" = 100 PRIOR INSTRUMENT: 20000673553