
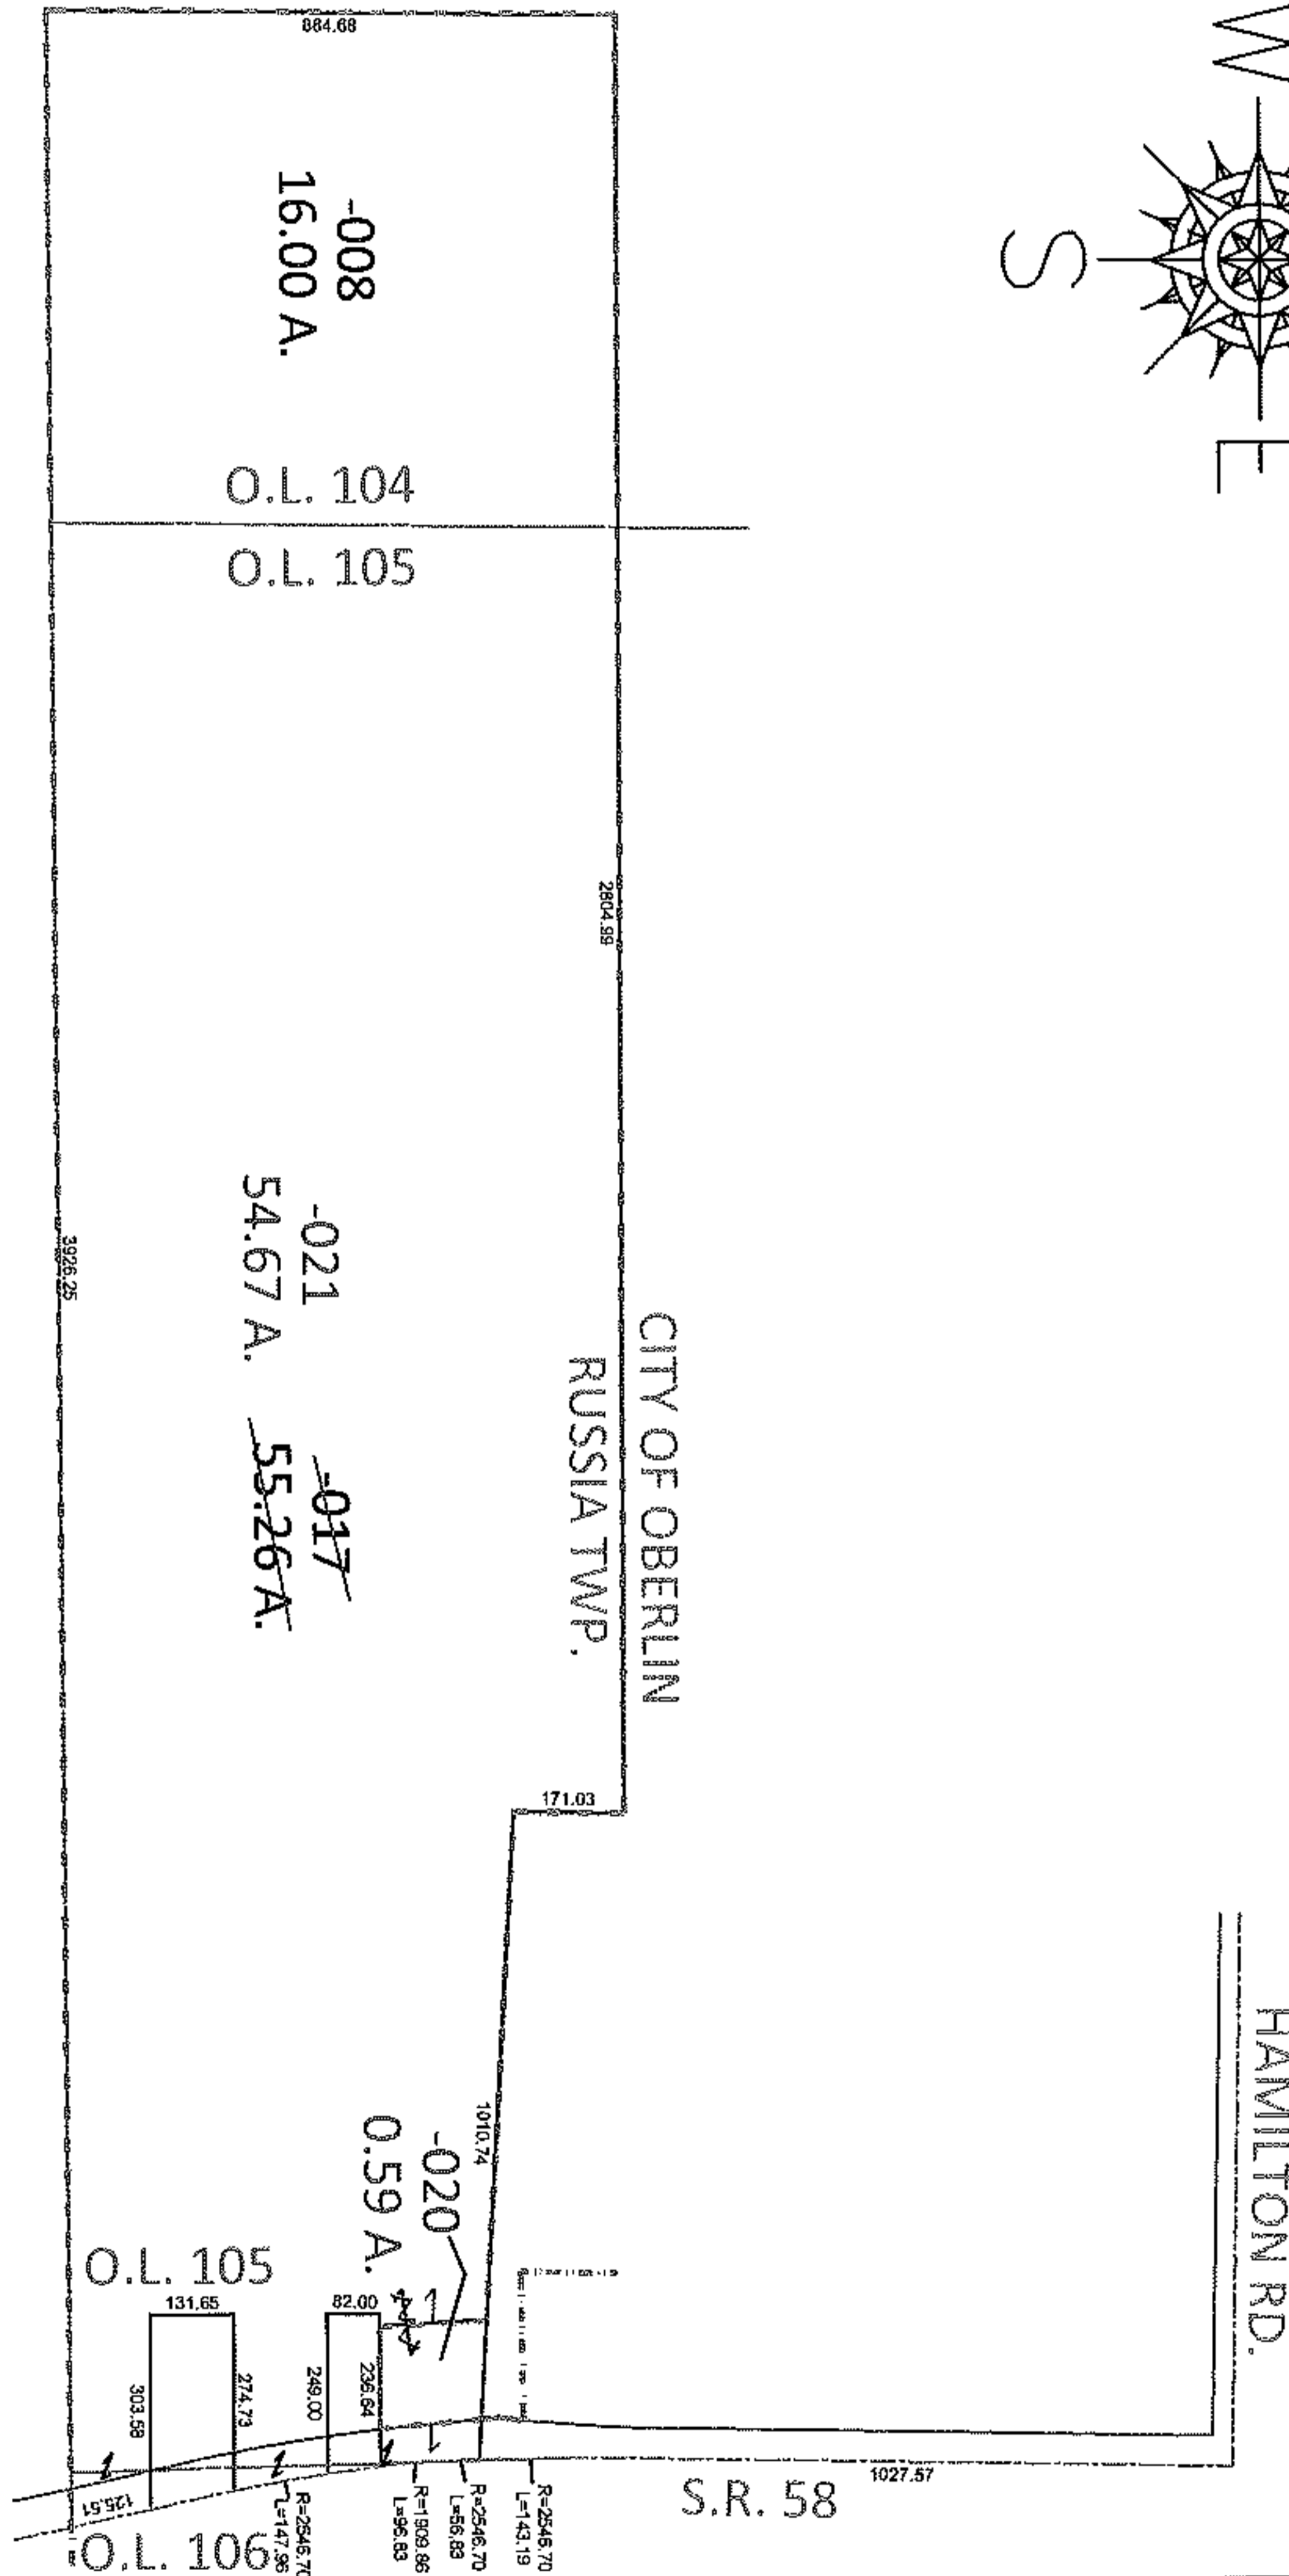


Raster

12-02455-C

PARENT PARCEL: 09-00-105-000-017  
CHILD PARCEL: 09-00-105-000-020, -021  
STARTING POINT: INTERSECTION OF C/L OF S.R. 58 AND C/L OF HAMILTON RD.

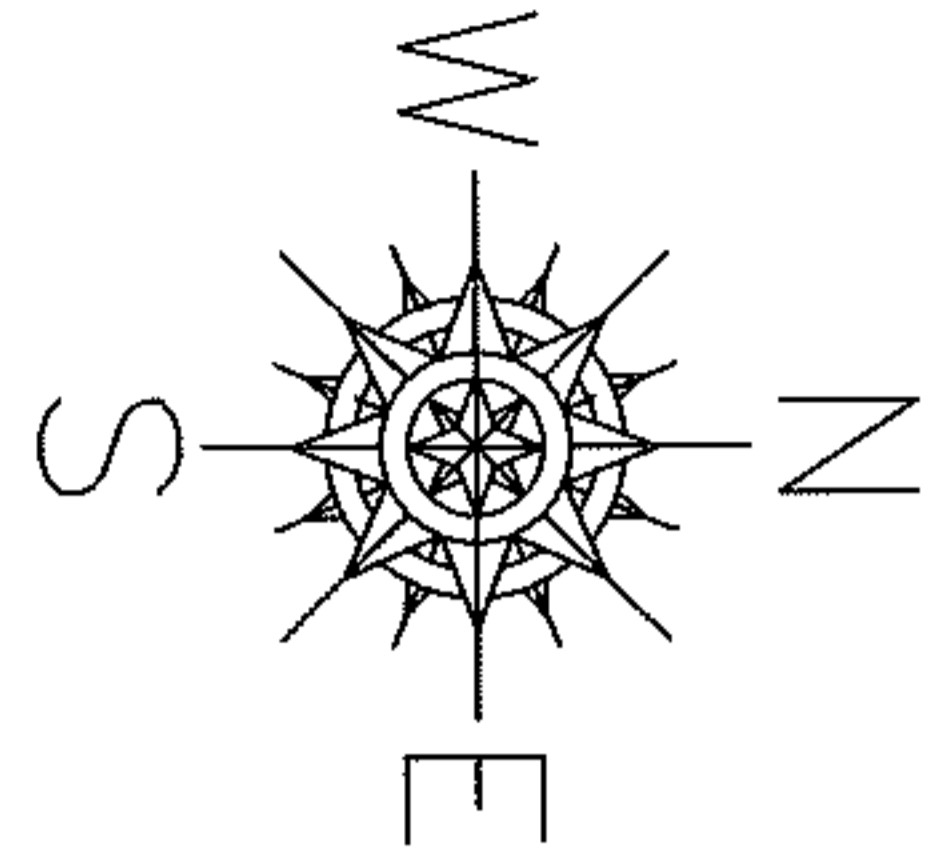

DROP FROM DUP.

09-00-105-000-017  
55.26 A.


09-05-105-000-017  
0.59 A.

ADD TO DUP.

09-00-105-000-020  
0.59 A.

09-00-105-000-021  
54.67 A.

PER ANNEXATION NO. 97-215 SURVEY BY D. ELWELL  
PROPERTY SURVEY BY D. MOSLEY  
ANNEXATION RECORDED IN INSTRUMENT NO. 19970473982  
LAST DEED OF RECORD FOR PROPERTY 20070219135  
DEED IS BEING RECORDED

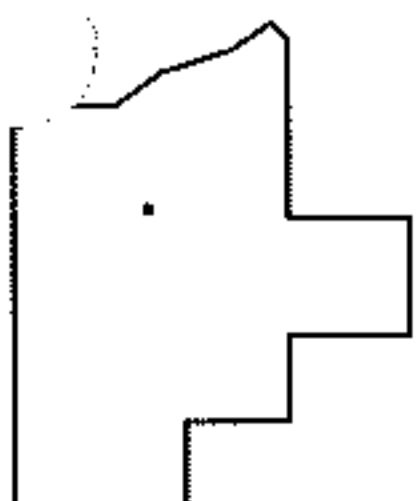

**SPLITS/DEEDS PROCESSED**

LORAIN COUNTY TAX MAP DEPARTMENT  
226 MIDDLE AVE. ELYRIA, OHIO

SURVEYED BY: DAVID L. ELWELL/DOUG MOSLEY  
CLOSURE: .01:10,000  
MAP PAGE(S): 9-00-105-A & B  
APPROVED BY: RRM DATE: 3-6-12  
SCALE: 1" = 500 PRIOR INST.: 20070219135