




MASTER

PARENT PARCEL: 16-00-025-104-029

CHILD PARCEL: 16-00-025-104-034, -035

STARTING POINT: SIDELINE OF DELLWOOD RD & AVON-BELDEN RD

07-02461

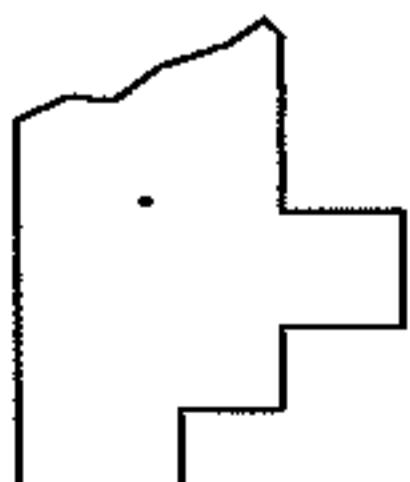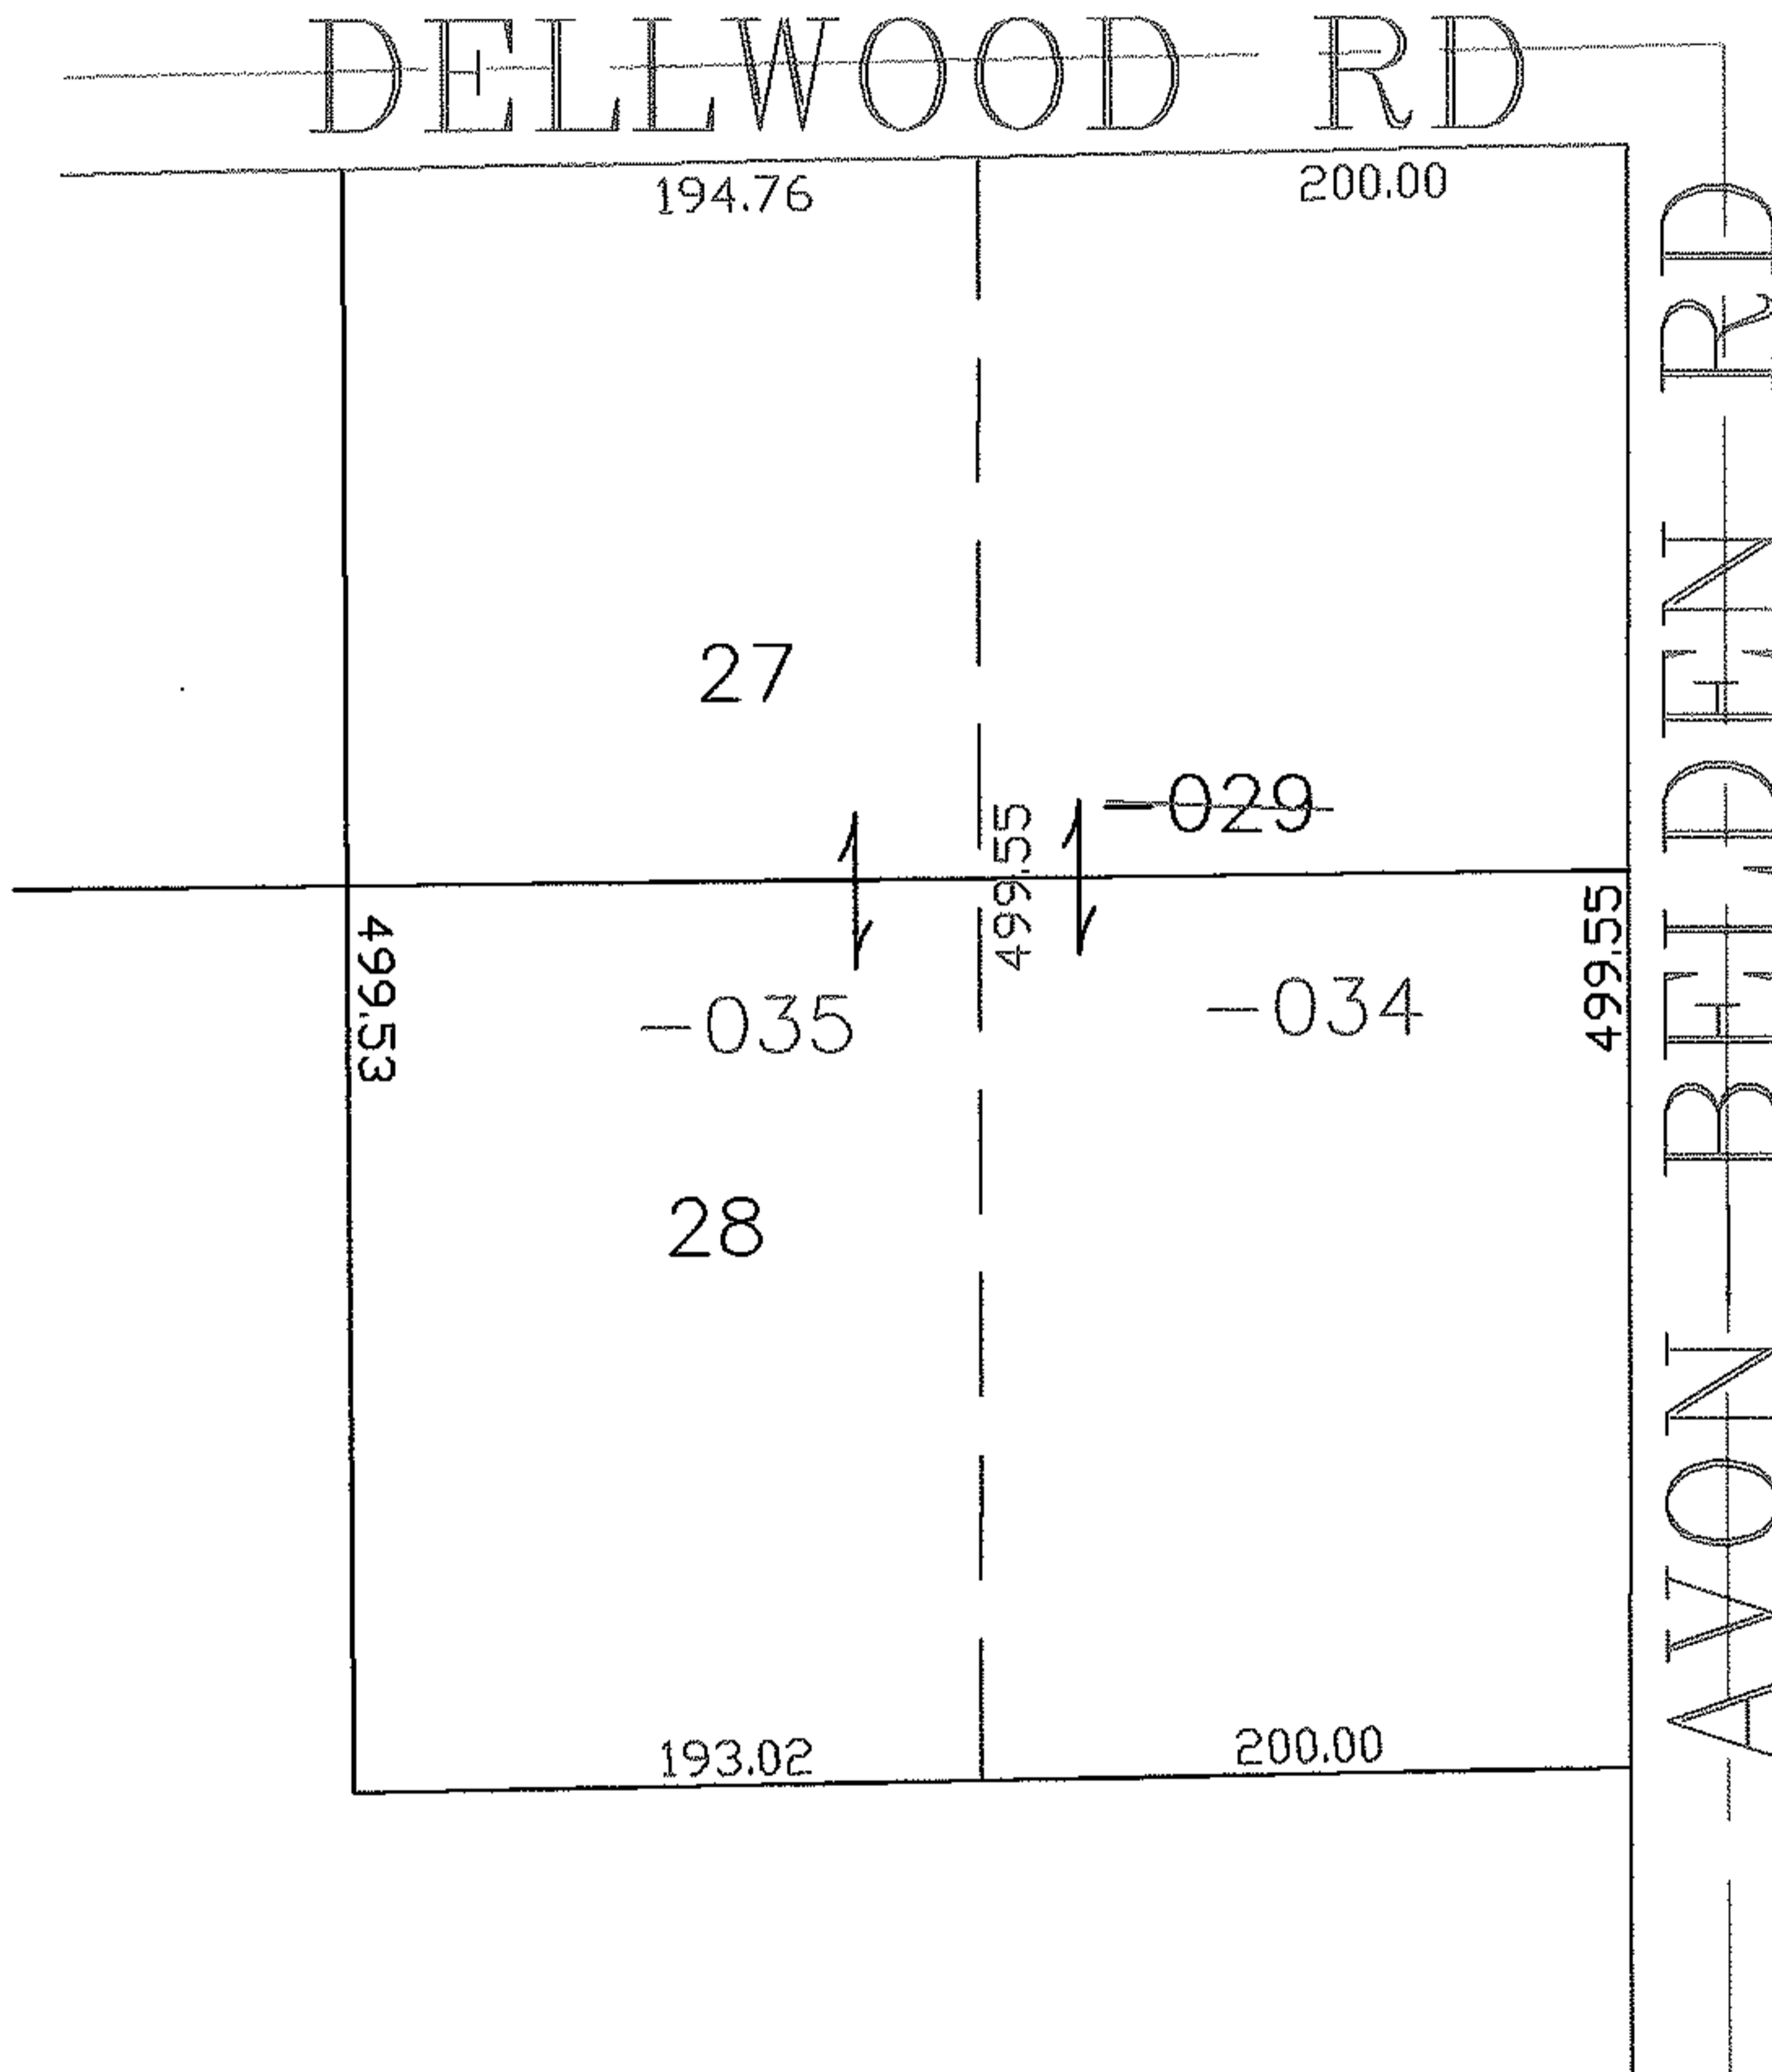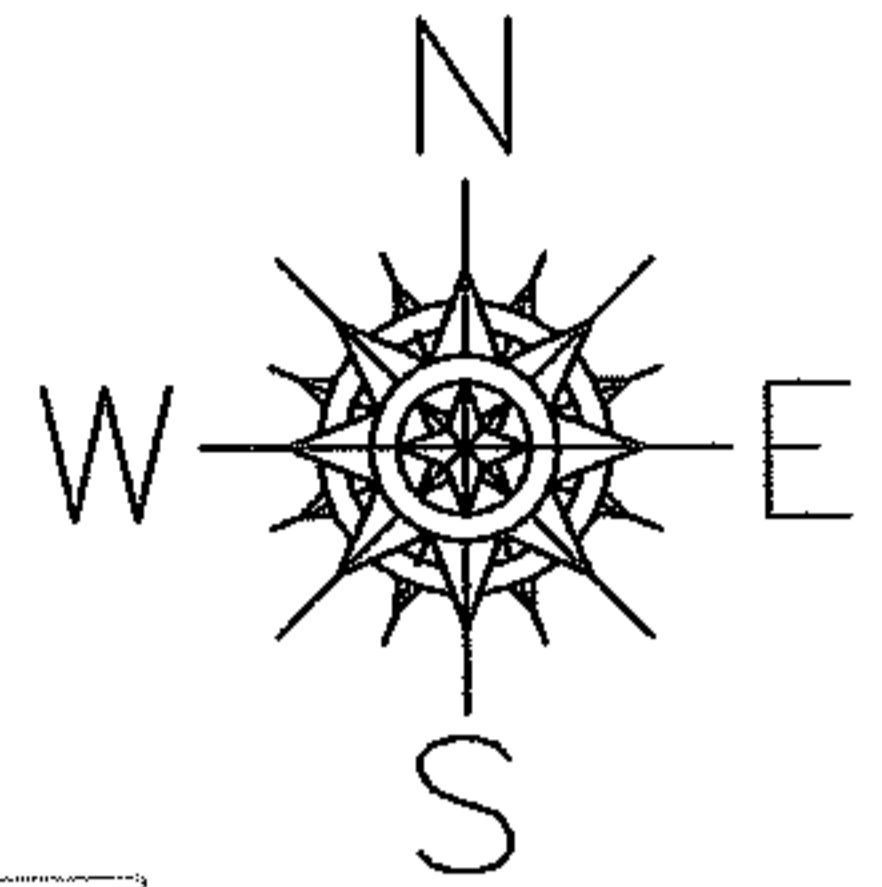

**SPLITS/DEEDS PROCESSED**

LORAIN COUNTY TAX MAP DEPARTMENT  
226 MIDDLE AVE. ELYRIA, OHIO

SURVEYED BY: THOMAS SIMON

CLOSURE: 0.00 : 10.000

MAP PAGE(S): 16-00-025-B

APPROVED BY: JAH DATE: 9-18-07

SCALE: 1" = 100' PRIOR INSTRUMENT: PL VL 12/29