
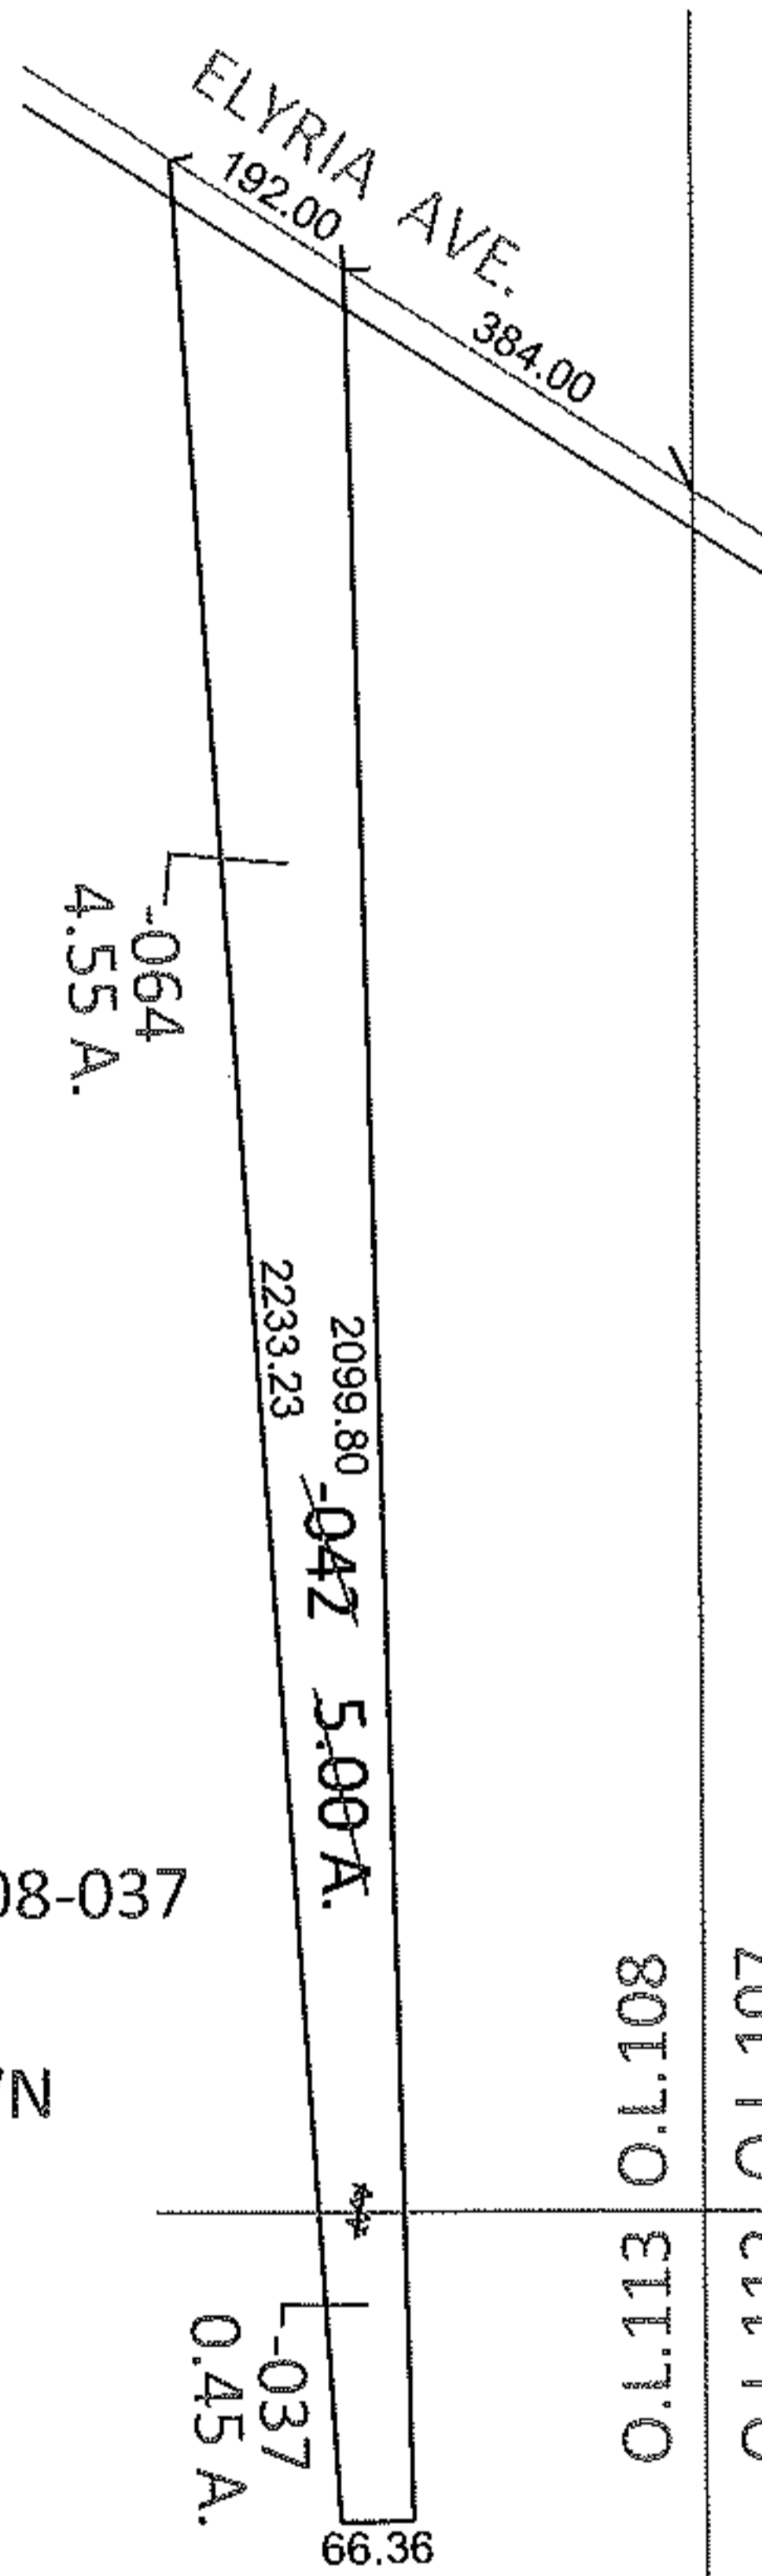


PARENT PARCEL: 03-00-108-112-042

CHILD PARCEL: 03-00-108-112-064, 03-00-113-108-037

12-02462-C

STARTING POINT: INTERSECTION OF C/L OF ELYRIA AVE. AND EAST LINE OF O.L.108

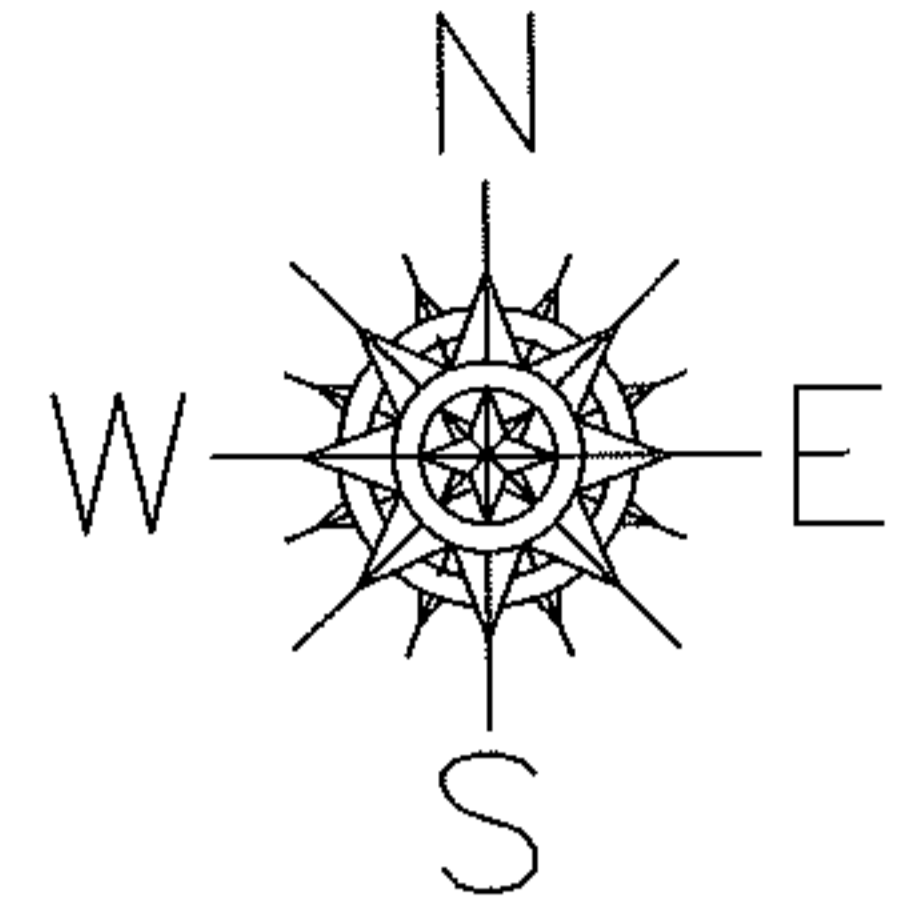


UNCOMBINAION

03-00-108-112-042

5.00 A.

03-00-108-112-064 03-00-113-108-037
4.55 A. 0.45 A.

TO REFLECT AC. BREAKDOWN
ON DEEDS

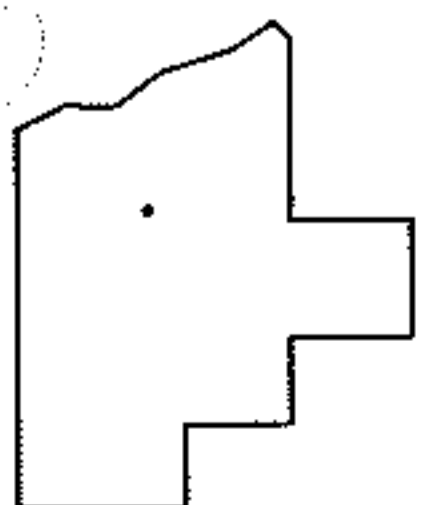

SPLITS/DEEDS PROCESSED

LORAIN COUNTY TAX MAP DEPARTMENT
226 MIDDLE AVE. ELYRIA, OHIO

SURVEYED BY: N/A

CLOSURE: N/A

MAP PAGE(S): 3-00-108-B, 3-00-113-B

APPROVED BY: RRM DATE: 3-21-12

SCALE: 1" = 400 PRIOR INST.: OR 779/72