




RASTER

PARENT PARCEL: 04-00-016-102-048

CHILD PARCEL: 04-00-016-102-056, -057

STARTING POINT: CENTERLINE OF SCHNEIDER CT & CENTER RD

07-02466

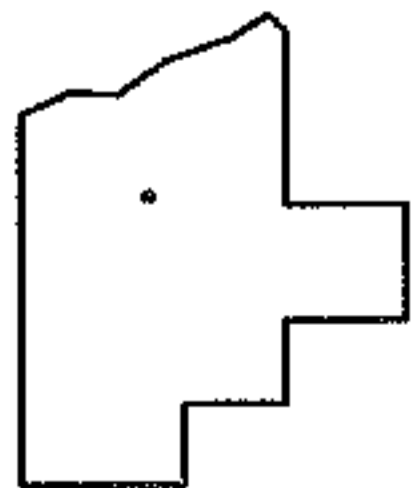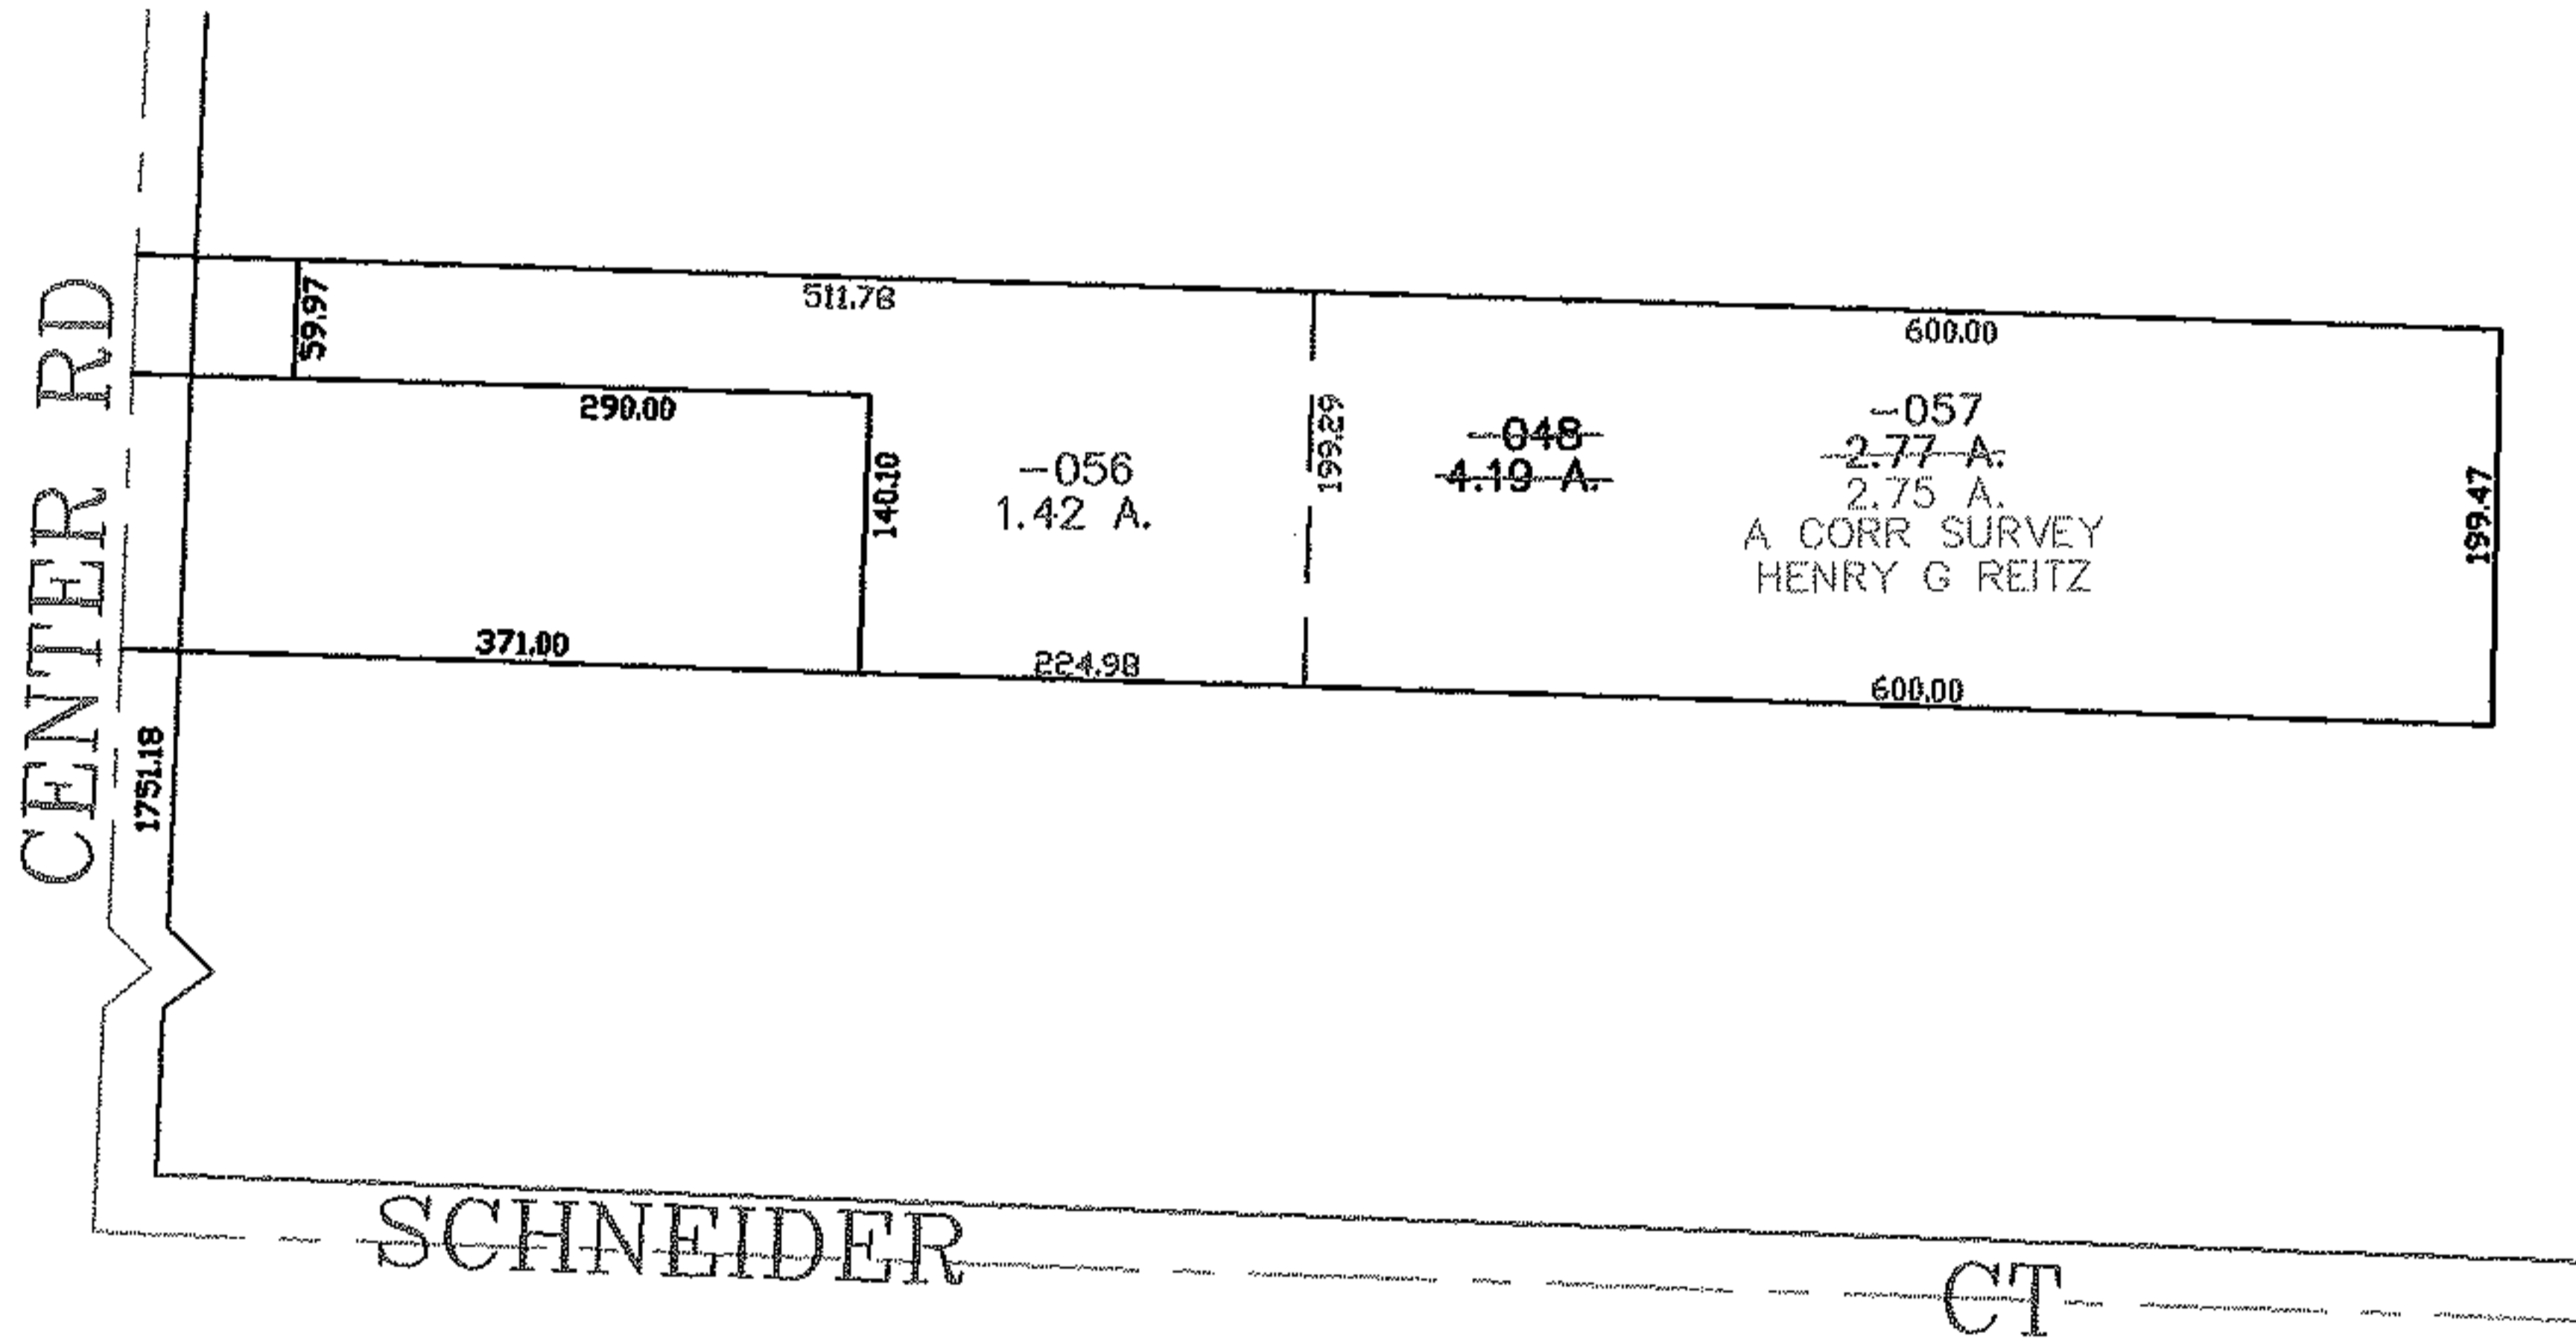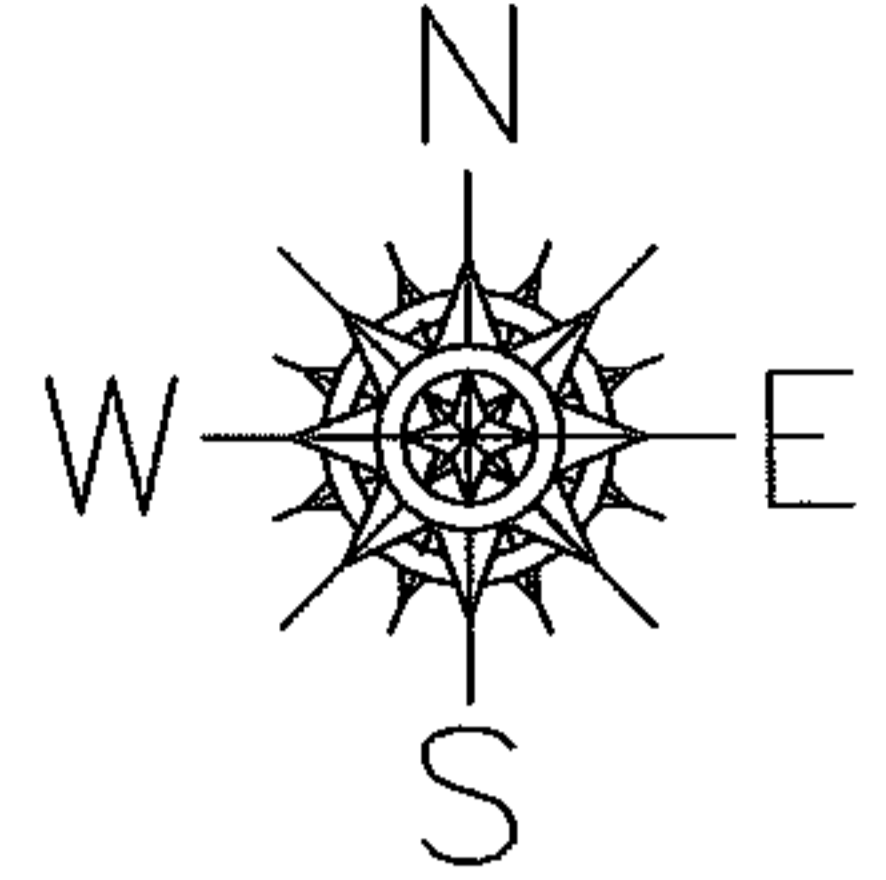

**SPLITS/DEEDS PROCESSED**  
 LORAIN COUNTY TAX MAP DEPARTMENT  
 226 MIDDLE AVE. ELYRIA, OHIO

SURVEYED BY: HENRY G REITZ  
 CLOSURE: 0.00 : 10.000  
 MAP PAGE(S): 04-00-016-C  
 APPROVED BY: JAH DATE: 9-28-07  
 SCALE: 1" = 200' PRIOR INSTRUMENT: 20030912120