



RASTER

PARENT PARCEL: 03-00-058-102-017


CHILD PARCEL: 03-00-058-102-021, -022

STARTING POINT: CENTERLINE OF ROOT RD & COLORADO AVE

07-02467

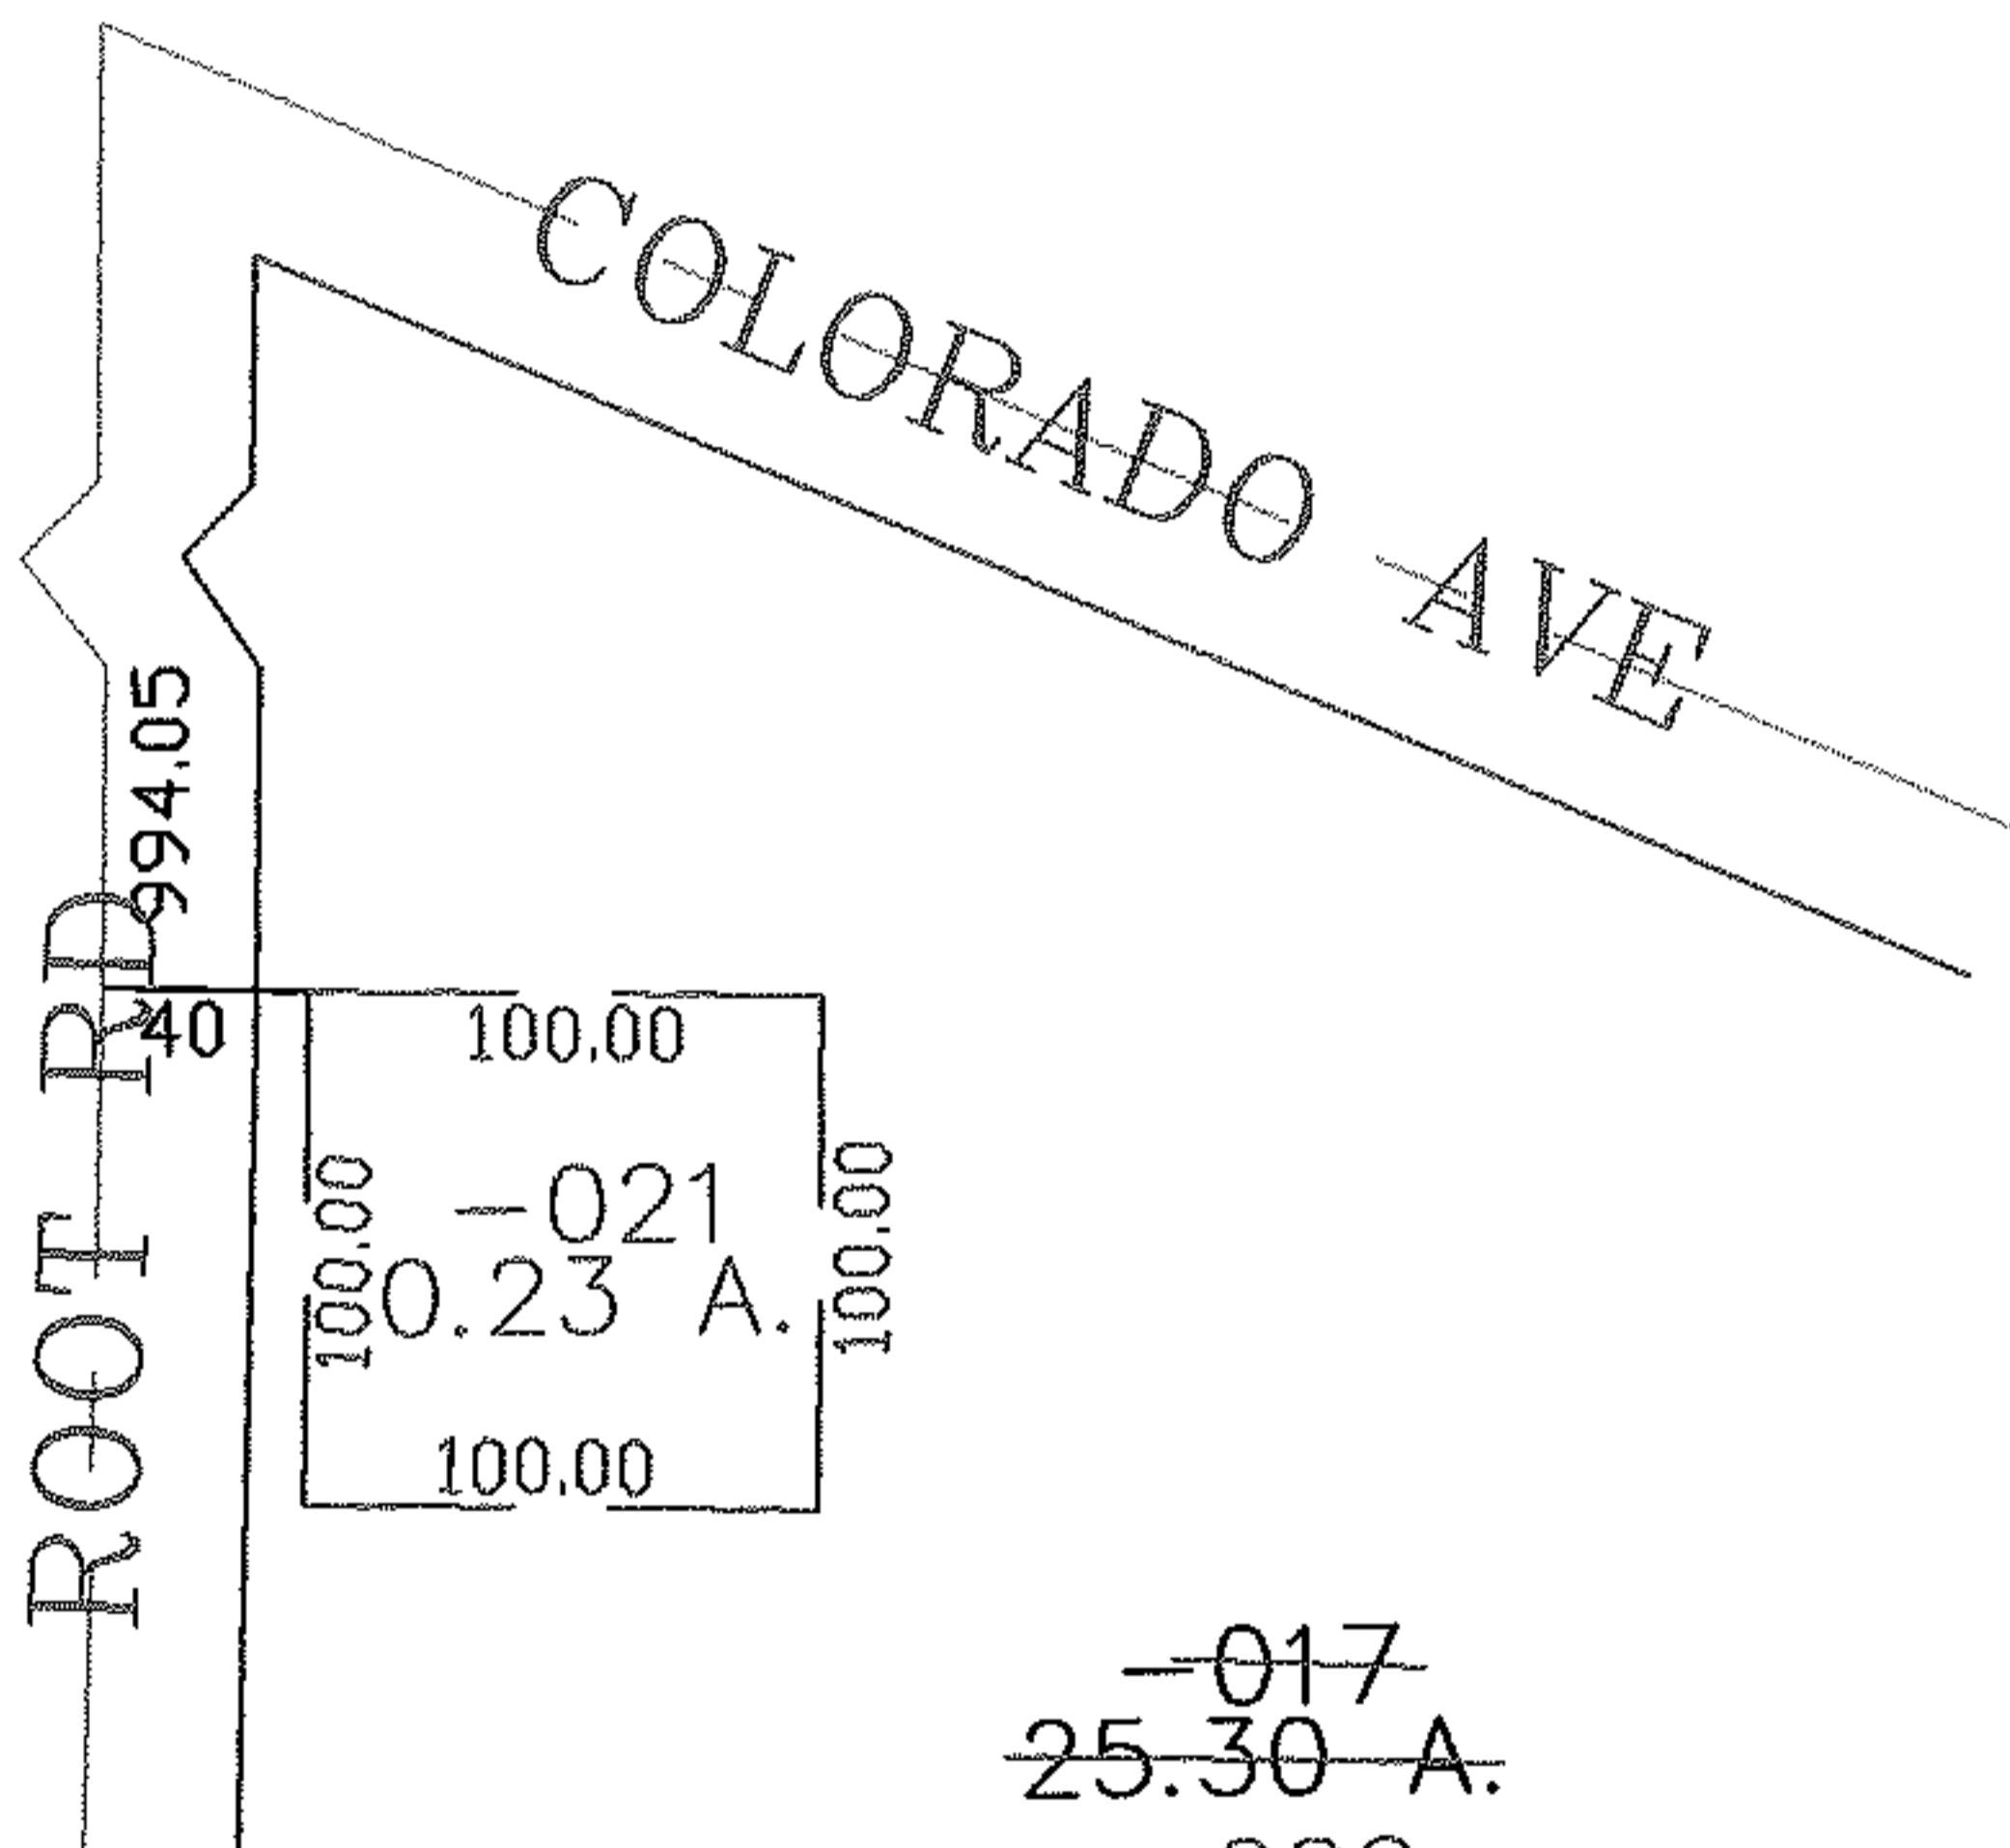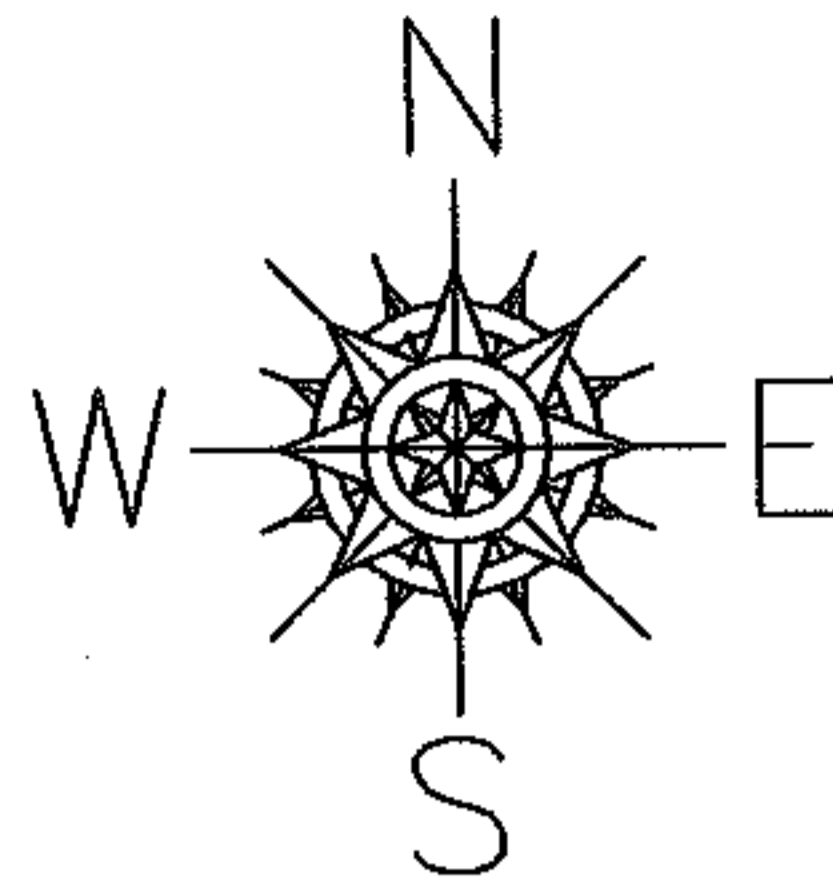

~~-017~~
25.30 A.
~~-022~~
25.07 A.

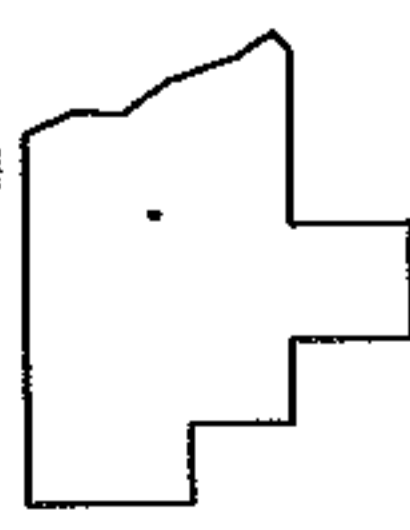

SPLITS/DEEDS PROCESSED
LORAIN COUNTY TAX MAP DEPARTMENT
226 MIDDLE AVE. ELYRIA, OHIO

SURVEYED BY: THOMAS SIMON
CLOSURE: 0.00 : 10.000
MAP PAGE(S): 03-00-058-B
APPROVED BY: JAH DATE: 9-28-07
SCALE: 1" = 100 PRIOR INSTRUMENT: 20040023525