
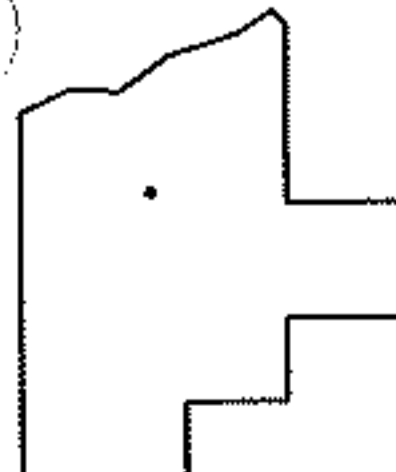
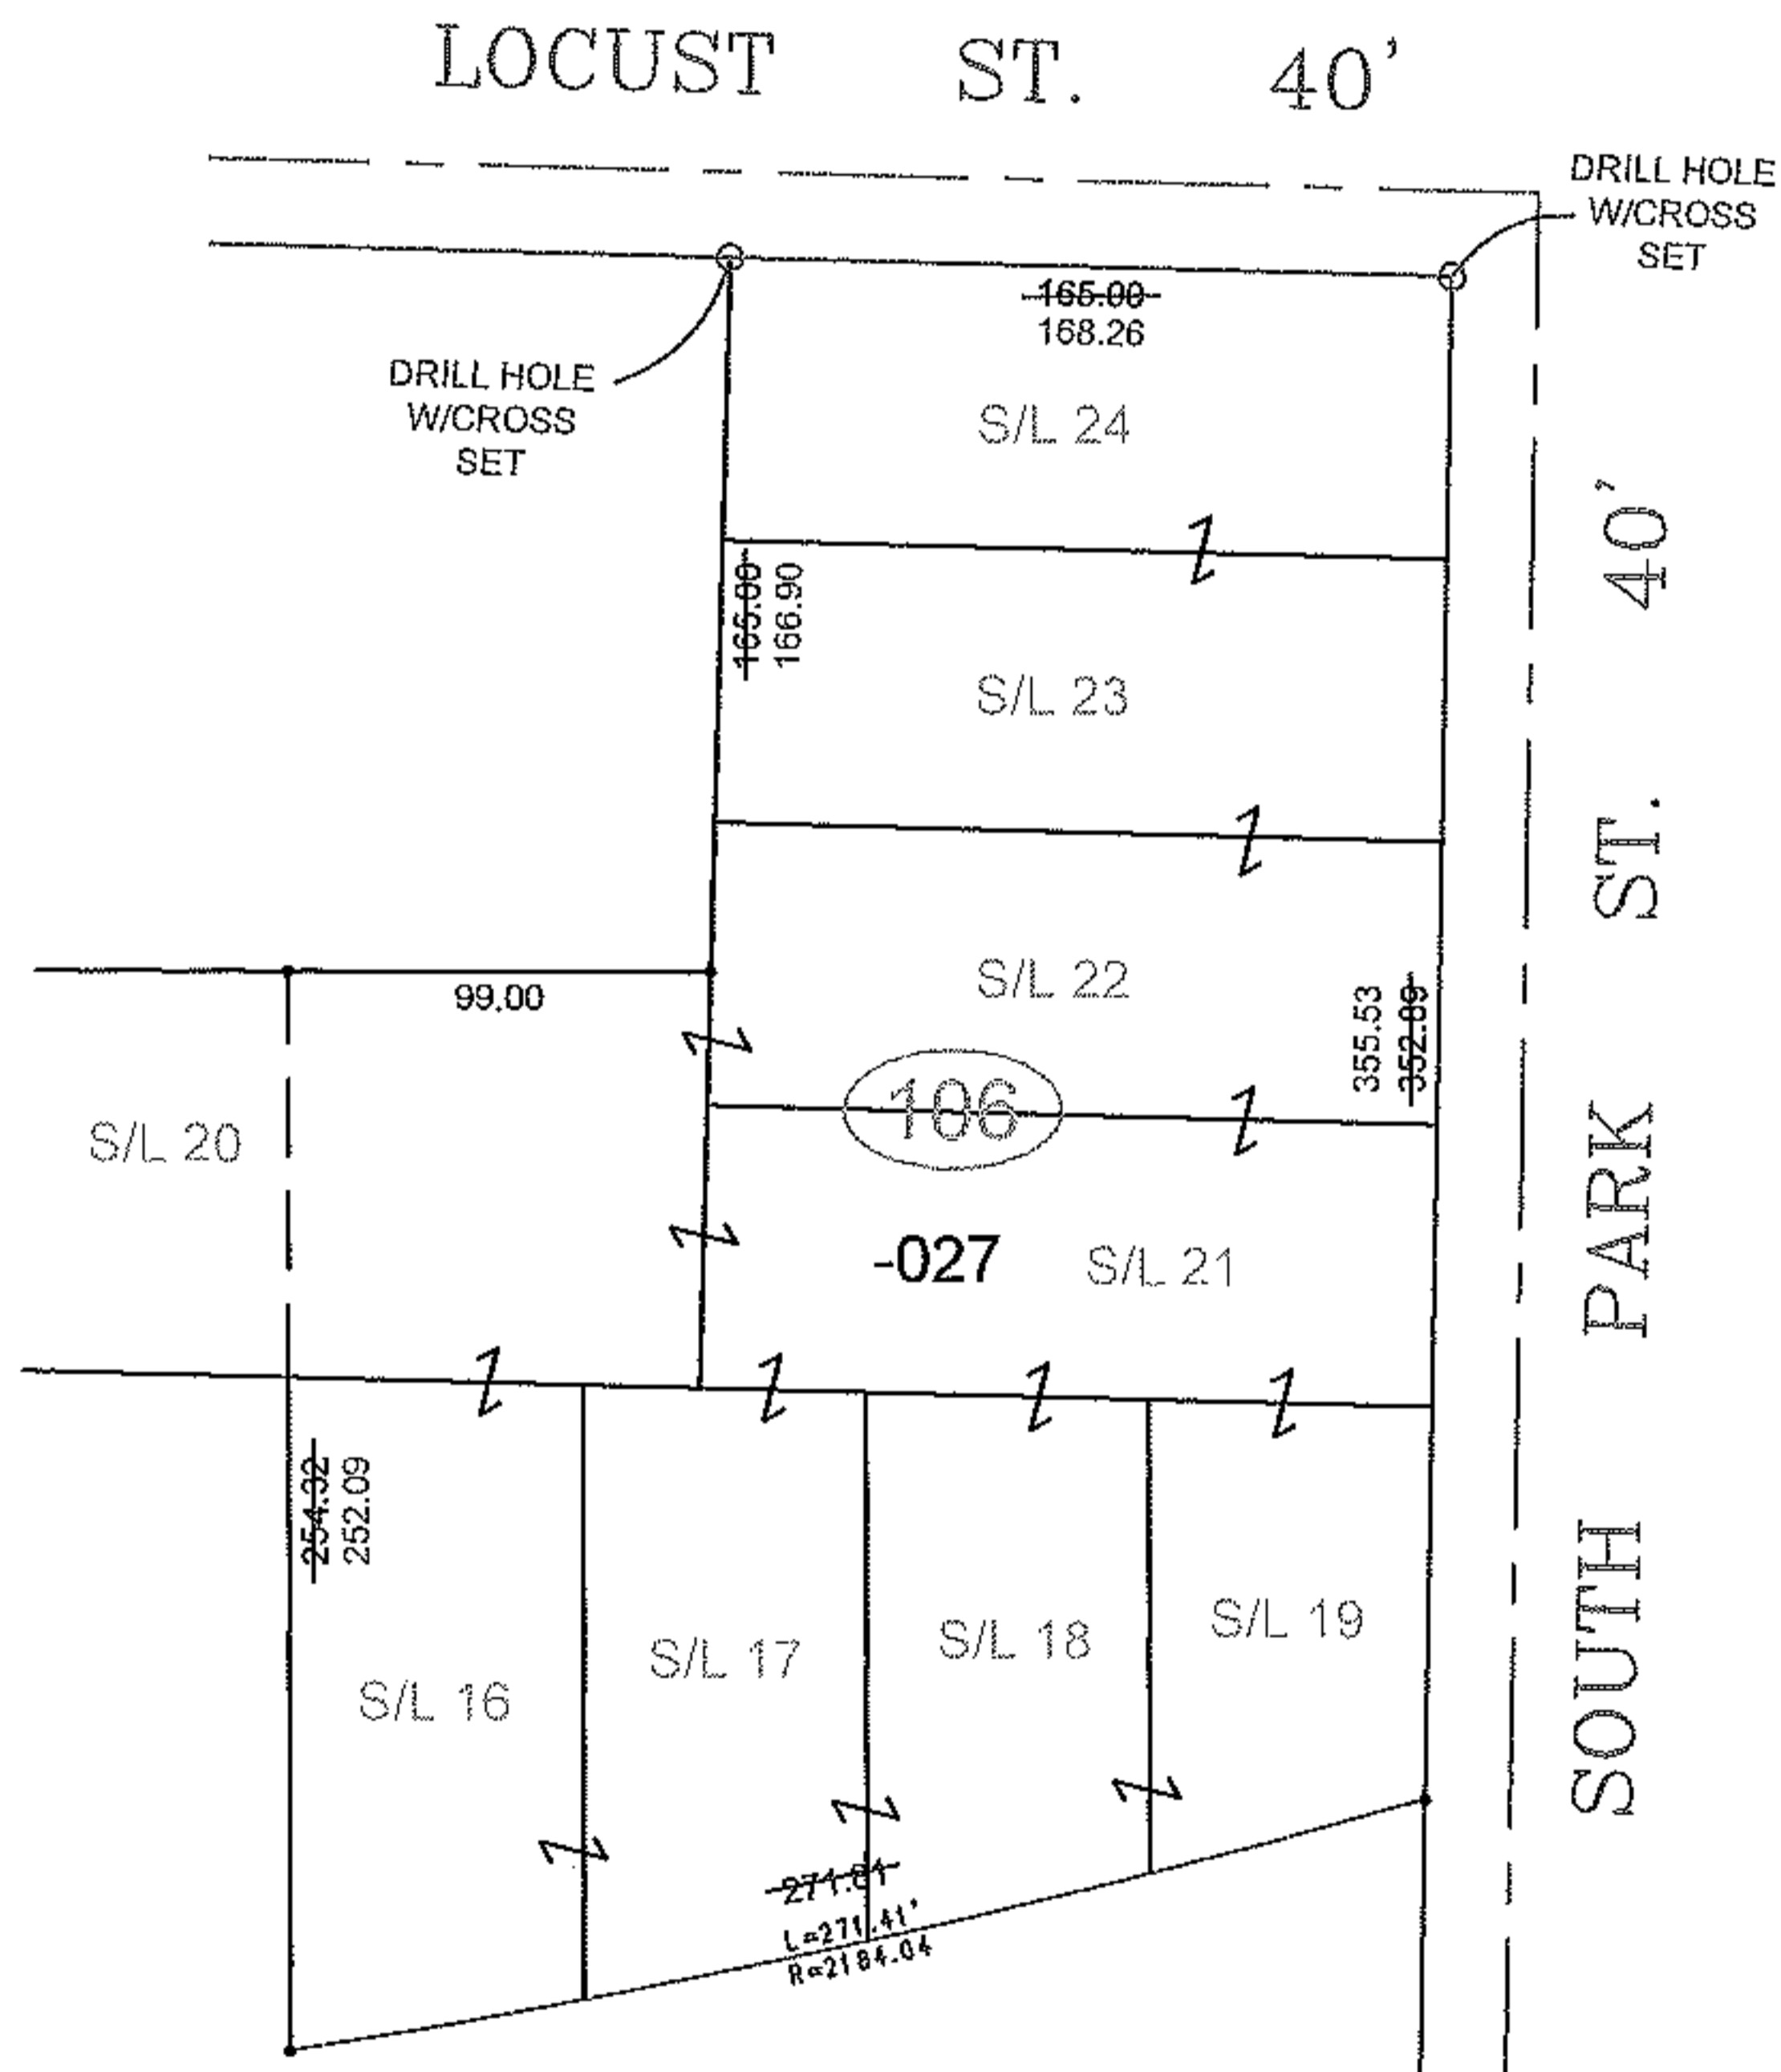


PARENT PARCEL: 09-00-096-106-027  
 CHILD PARCEL: XX-XX-XXX-XXX-XXX  
 STARTING POINT: DRILL HOLE W/CROSS, INT. OF SOUTH R.O.W. OF LOCUST ST. &  
WEST R.O.W. OF SOUTH PARK ST.

12-02468-C

FR. & DEPTH CORR.

09-00-096-106-027  
~~352.89 X 271.81 X 280 IRR.~~  
 168.26 X 355.53  
 CORR. PER SURV.  
 C. DEMPSEY

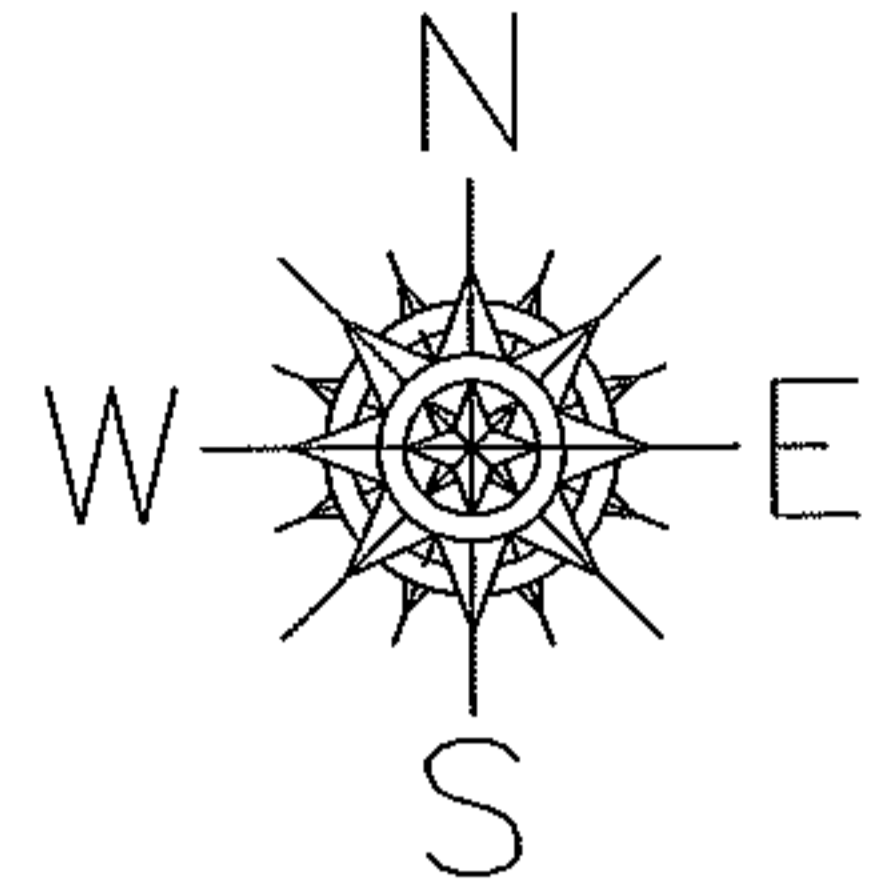

SPLITS/DEEDS PROCESSED

LORAIN COUNTY TAX MAP DEPARTMENT  
 226 MIDDLE AVE. ELYRIA, OHIO

SURVEYED BY: CHRISTOPHER J. DEMPSEY  
 CLOSURE: 0.01 : 10,000  
 MAP PAGE(S): 9-00-096-A  
 APPROVED BY: TJS DATE: 3/26/12  
 SCALE: 1" = 100 PRIOR INST.: DV 864/583