




RASTER

PARENT PARCEL: 05-00-052-000-036

CHILD PARCEL: 05-00-052-000-052, -053

STARTING POINT: CENTERLINE OF OBERLIN RD & O.L. 52

07-02469

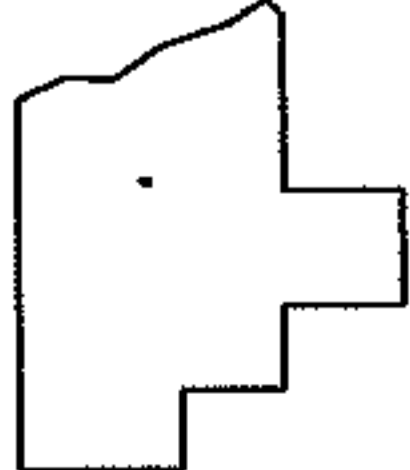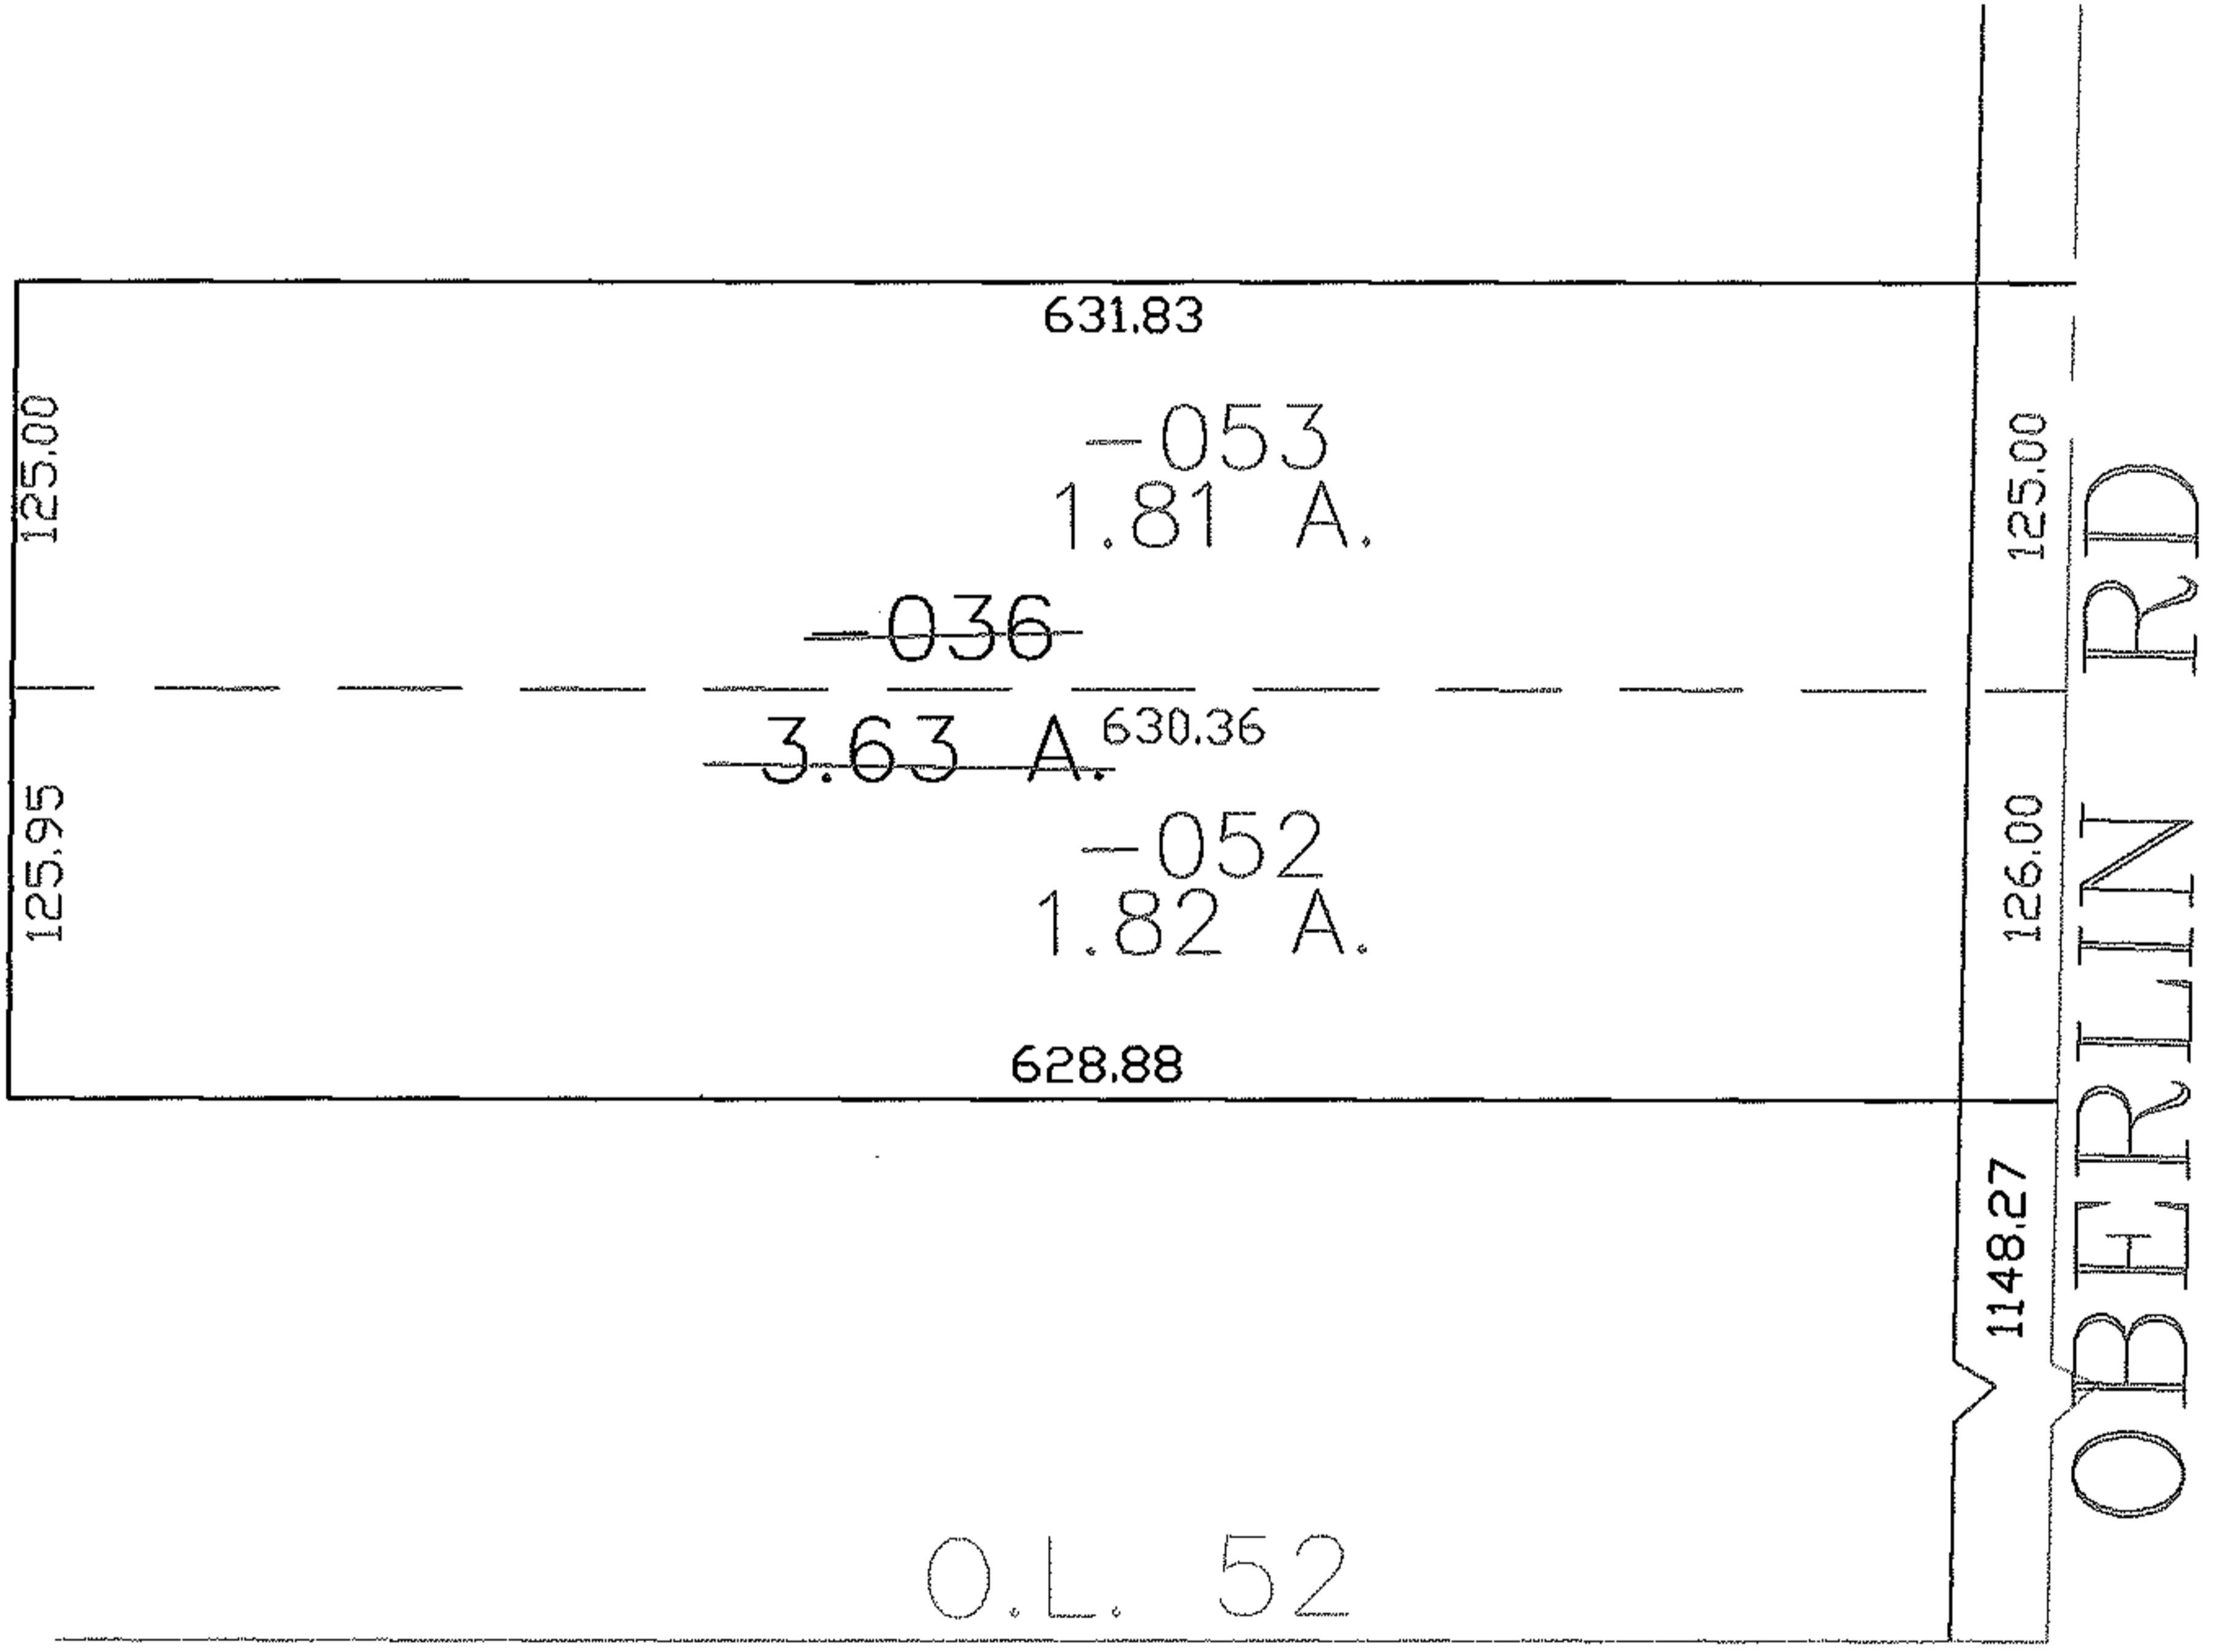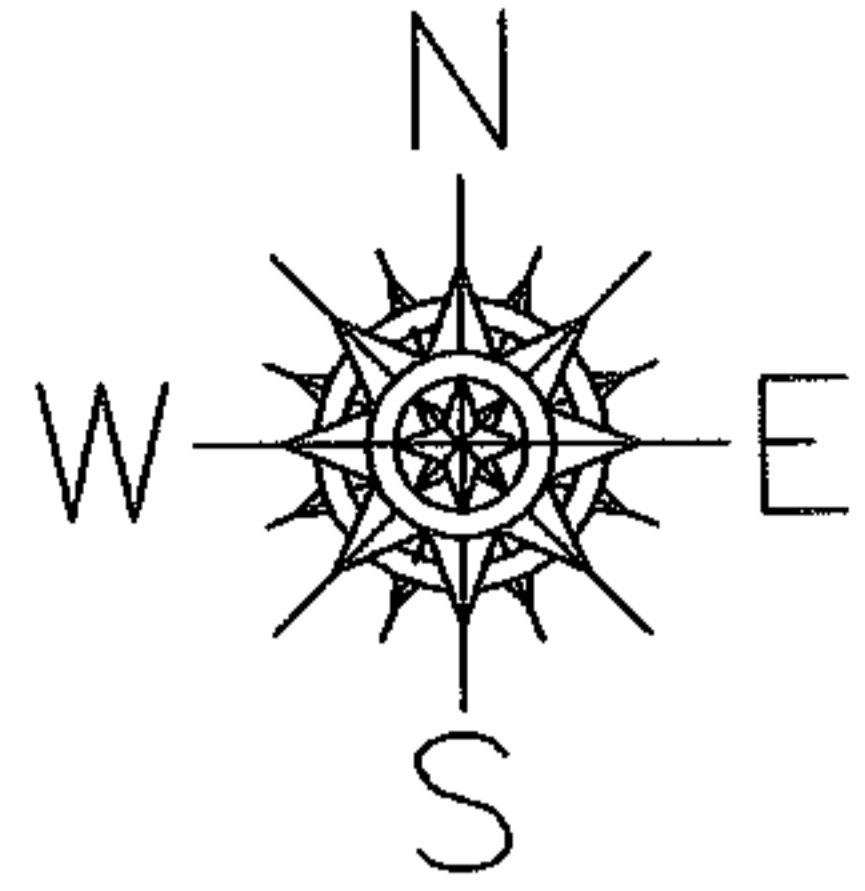

SPLITS/DEEDS PROCESSED

LORAIN COUNTY TAX MAP DEPARTMENT  
226 MIDDLE AVE. ELYRIA, OHIO

SURVEYED BY: CHARLES WARYU  
 CLOSURE: 0.00 : 10.000  
 MAP PAGE(S): 05-00-052-B  
 APPROVED BY: JAH DATE: 10-9-07  
 SCALE: 1" = 100' PRIOR INSTRUMENT: 20070207852