
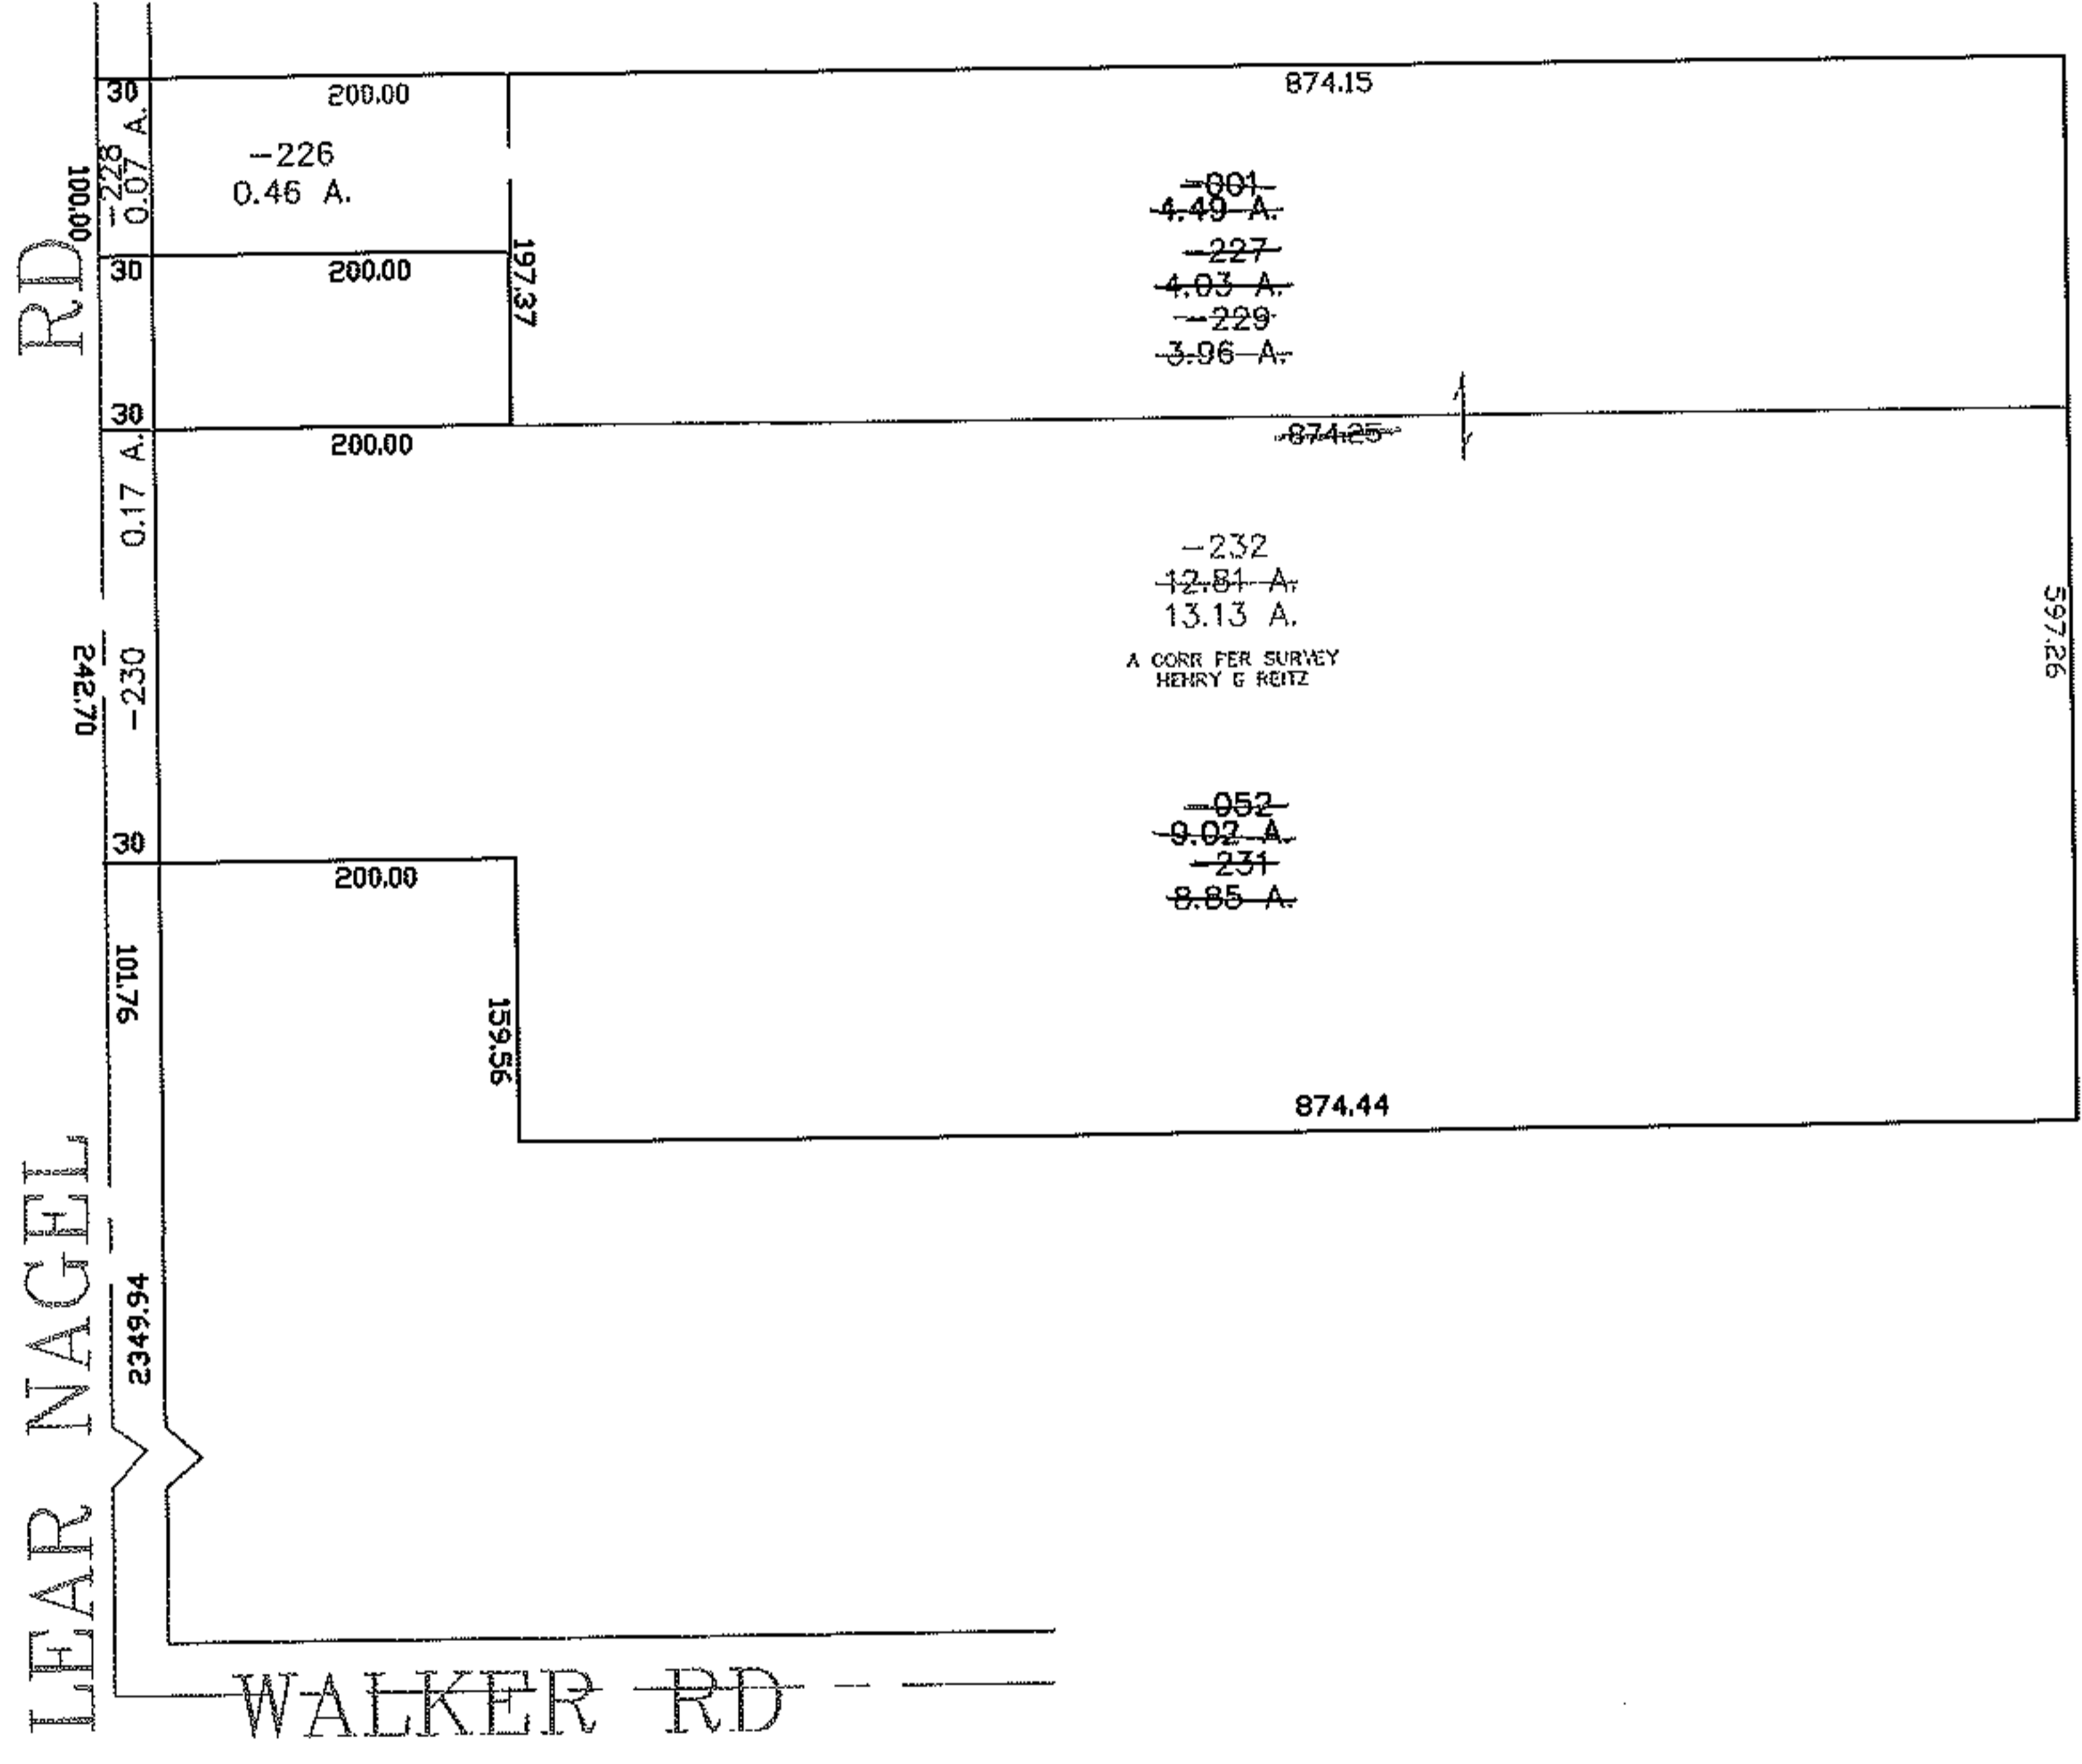


RASTER

PARENT PARCEL: 04-00-030-141-001, -052
CHILD PARCEL: 04-00-030-141-226 THRU -232
STARTING POINT: CENTERLINE OF WALKER RD & LEAR NAGEL RD

07-02471

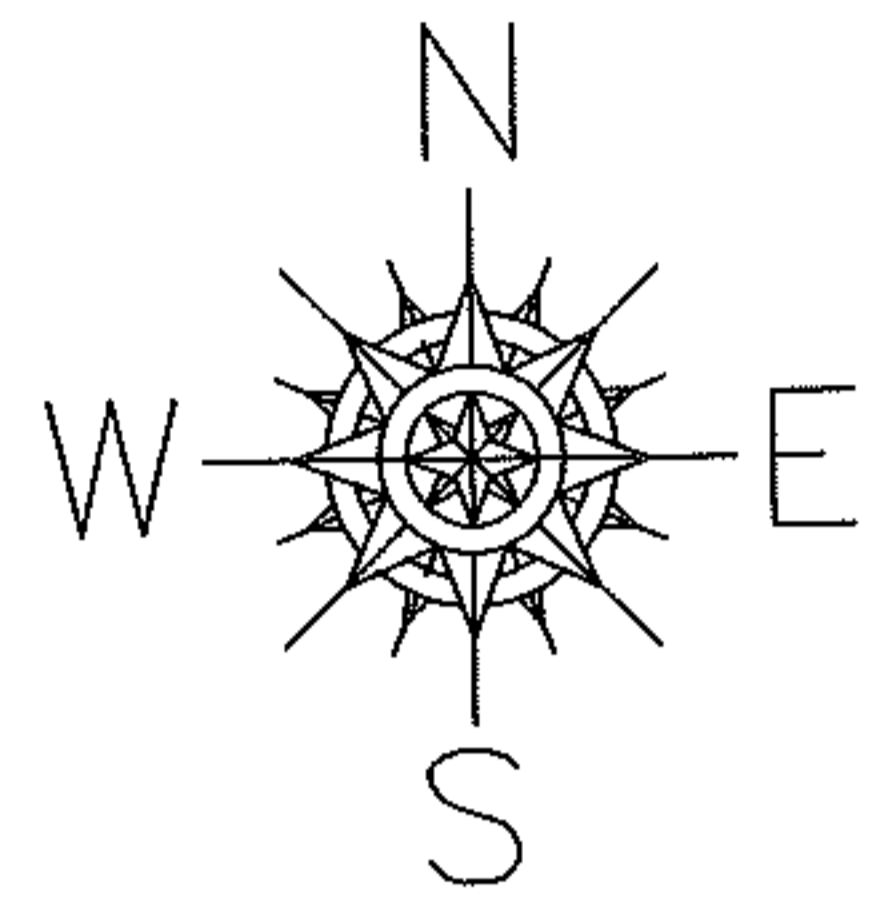

SPLITS/DEEDS PROCESSED

LORAIN COUNTY TAX MAP DEPARTMENT
226 MIDDLE AVE. ELYRIA, OHIO

SURVEYED BY: HENRY G REITZ
CLOSURE: 0.00 : 10,000
MAP PAGE(S): 04-00-030-E
APPROVED BY: JAH DATE: 10-23-07
SCALE: 1" = 200 PRIOR INSTRUMENT: 20010796604