



RASTER

PARENT PARCEL: 15-00-035-000-116

CHILD PARCEL: 15-00-035-000-274, -275

STARTING POINT: CENTERLINE OF BIGGS RD. & NORTH CENTER ST

07-02472

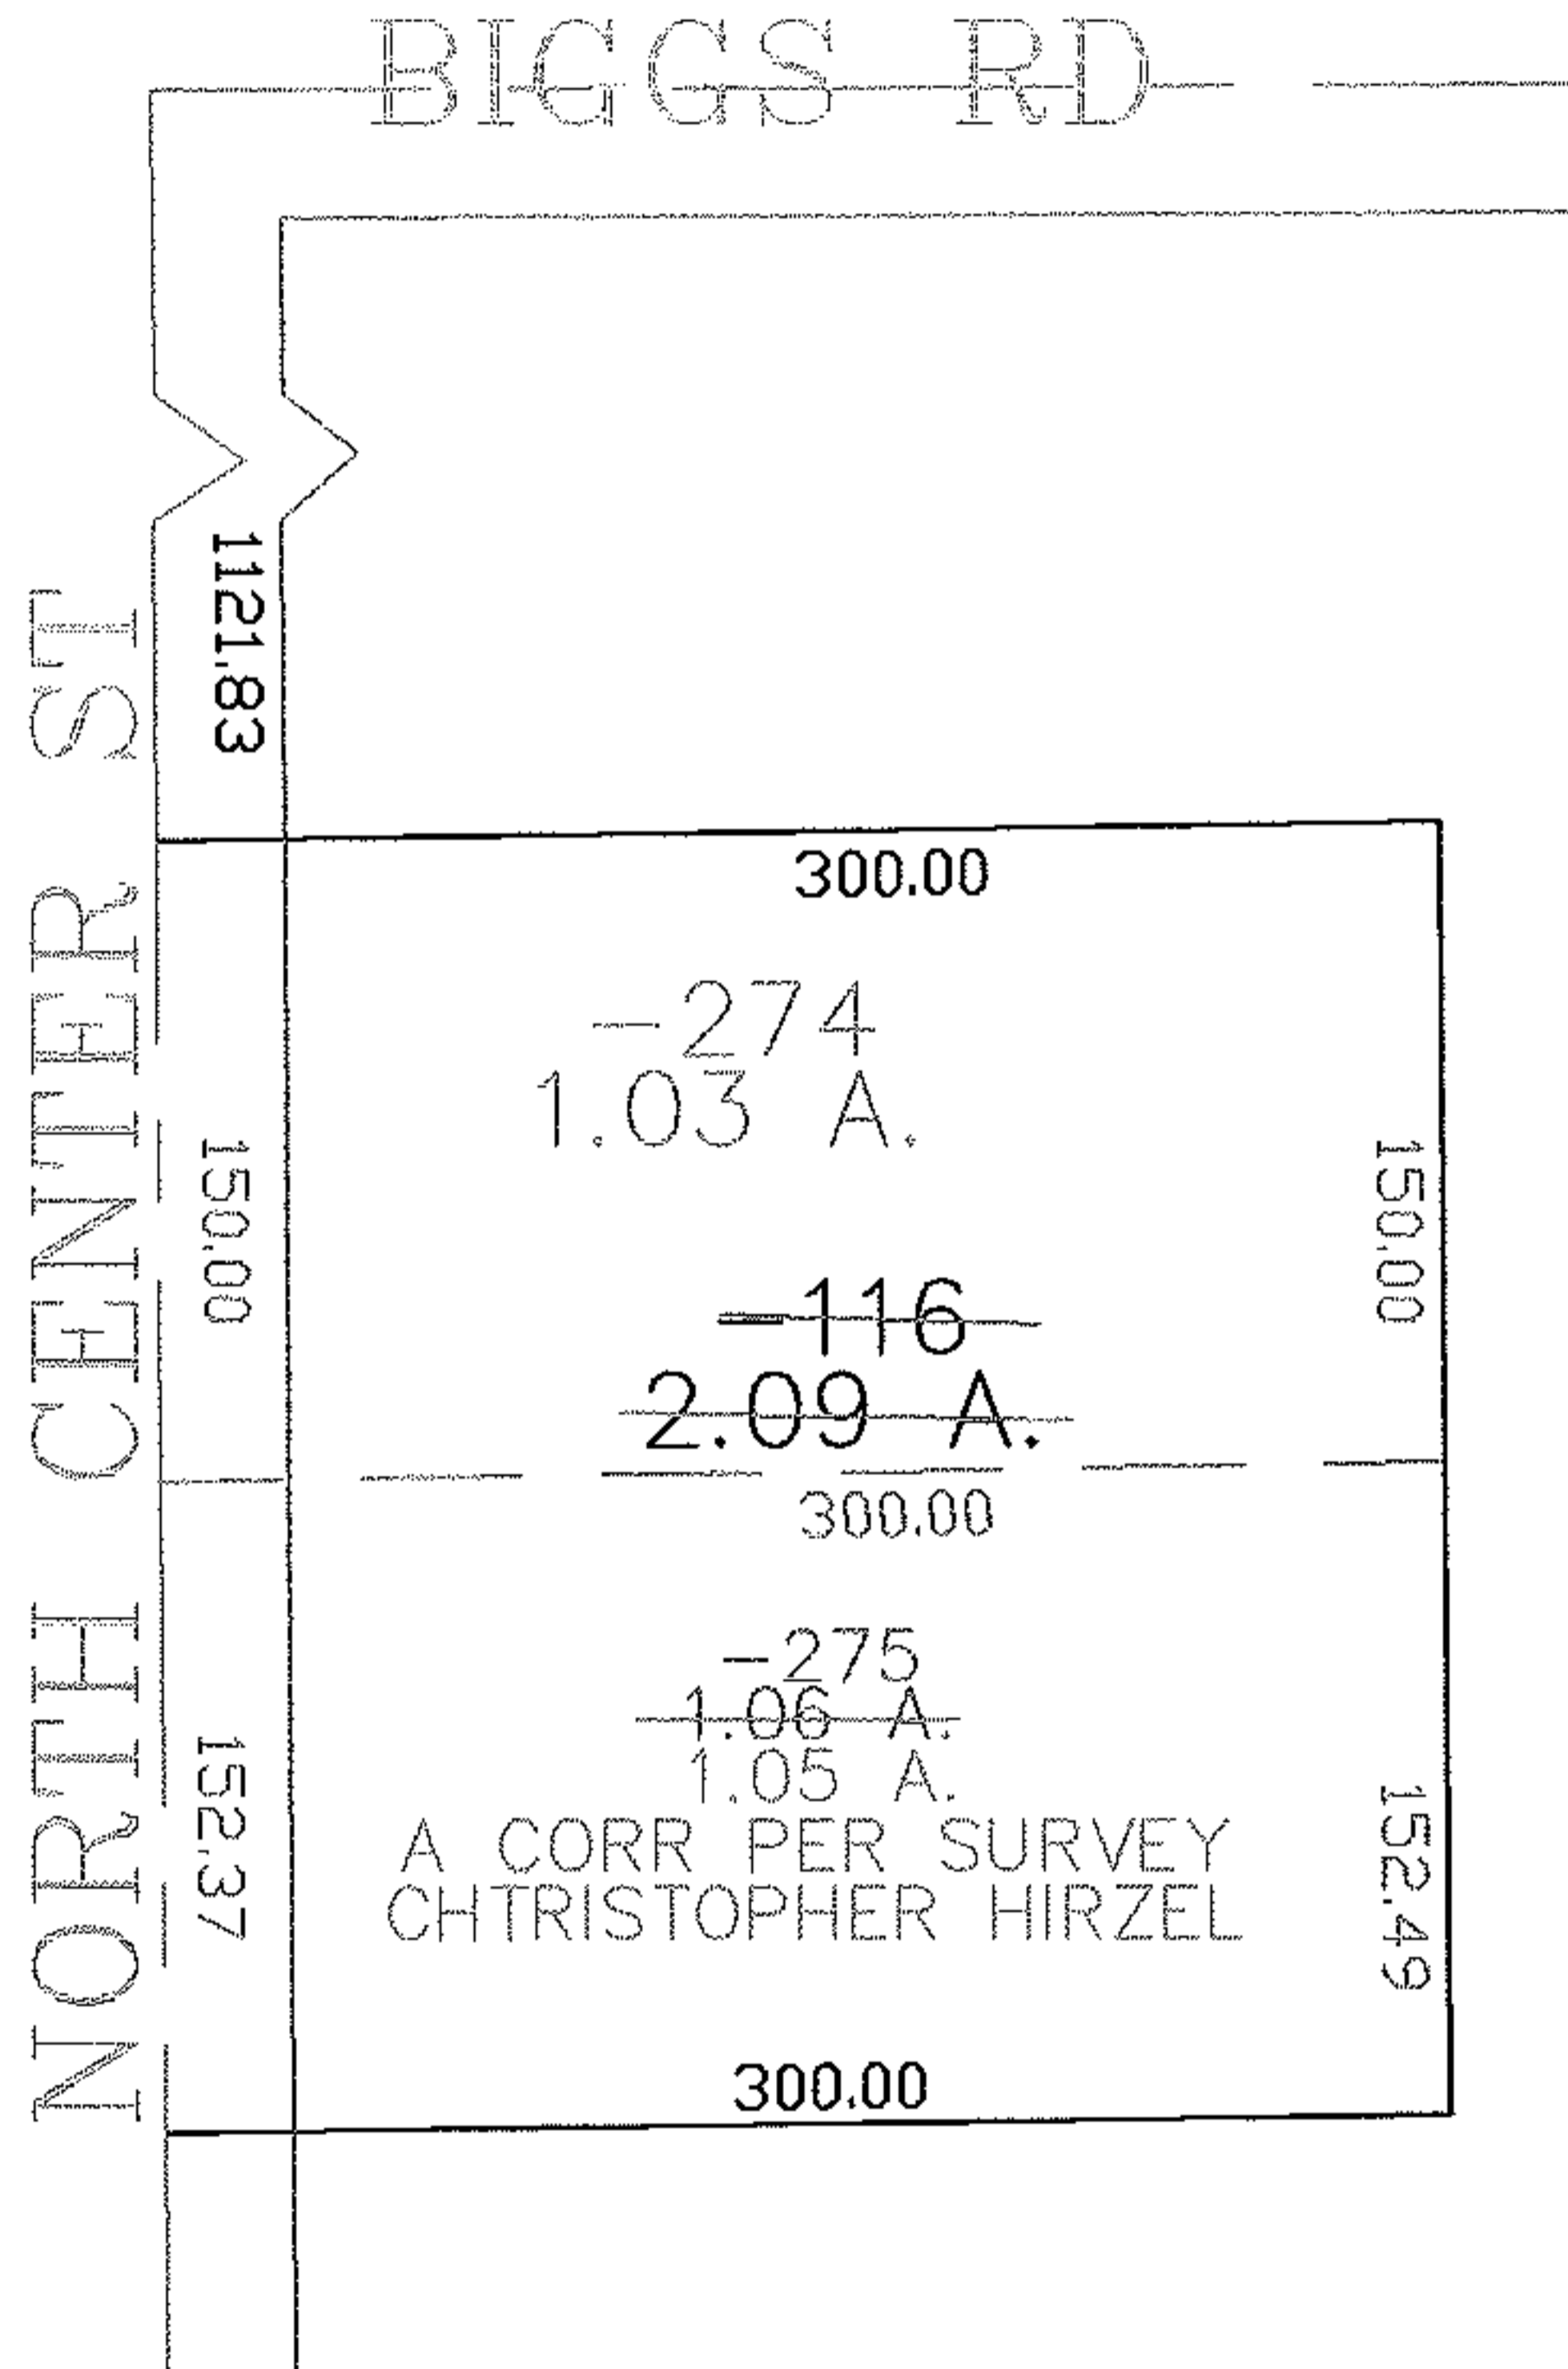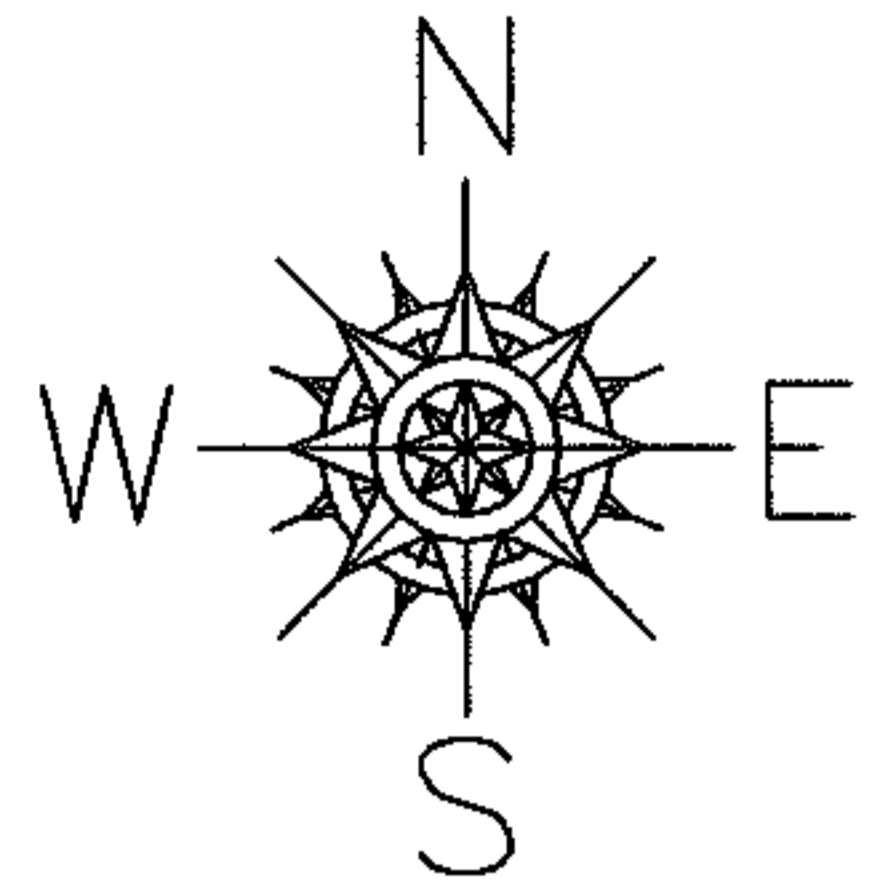

SPLITS/DEEDS PROCESSED

LORAIN COUNTY TAX MAP DEPARTMENT  
226 MIDDLE AVE. ELYRIA, OHIO

SURVEYED BY: CHRISTOPHER HIRZEL

CLOSURE: 0.00 : 10.000

MAP PAGE(S): 15-00-035-A

APPROVED BY: JAH DATE: 2-20-08

SCALE: 1" = 100 PRIOR INSTRUMENT: 20040012815