




RASTER

PARENT PARCEL: 09-00-066-000-053, -050

CHILD PARCEL: 09-00-066-000-054

STARTING POINT: CENTERLINE OF MAPLE ST & OBERLIN NORTH RD

07-02473

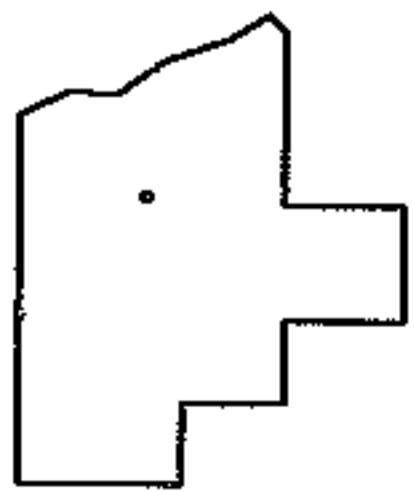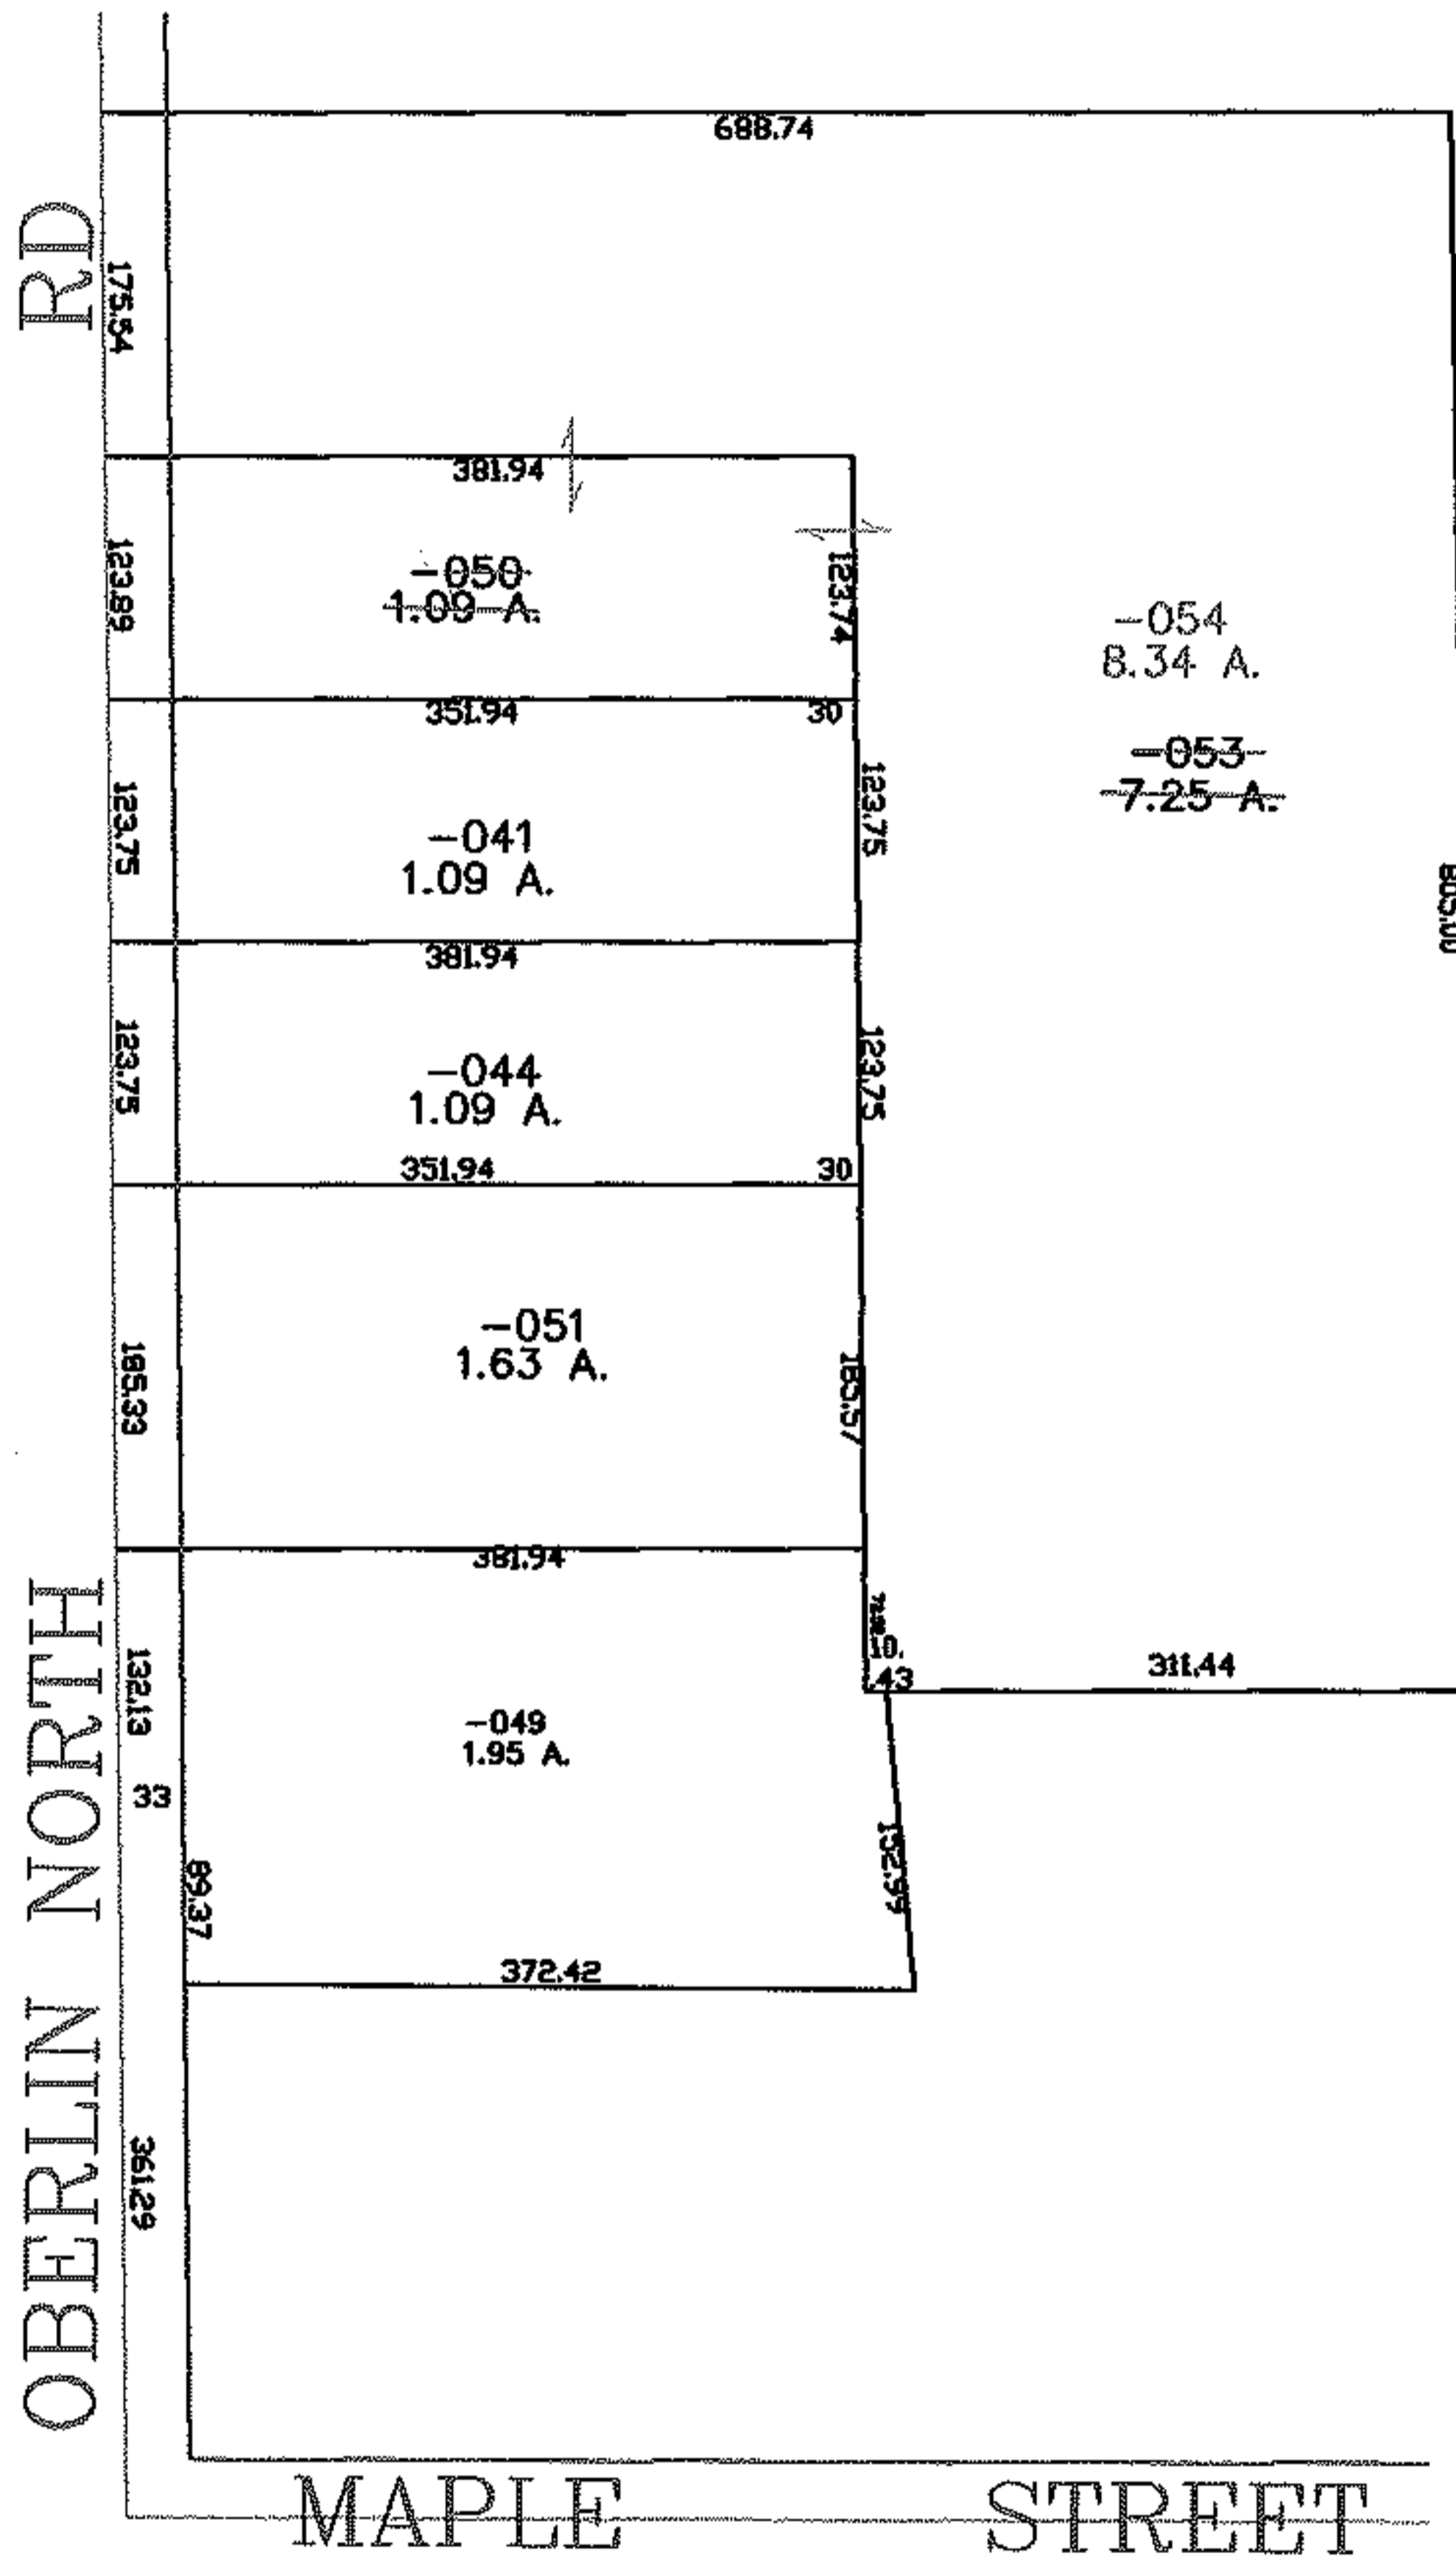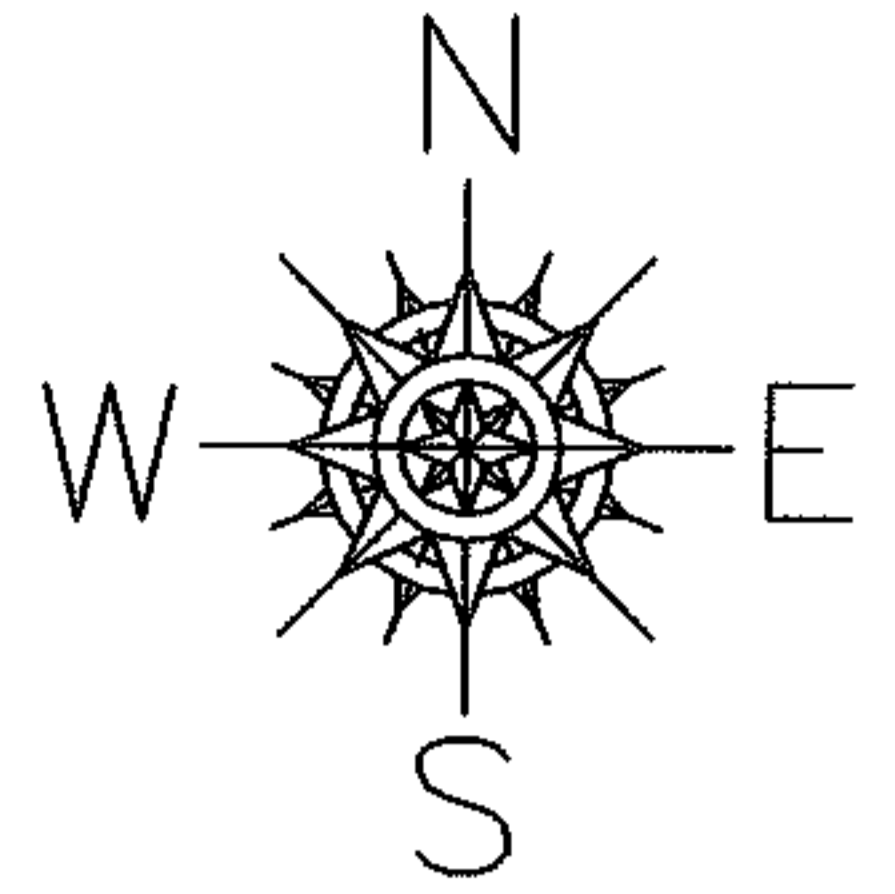

SPLITS/DEEDS PROCESSED
 LORAIN COUNTY TAX MAP DEPARTMENT
 226 MIDDLE AVE. ELYRIA, OHIO

SURVEYED BY: THOMAS SIMON
 CLOSURE: 0.00 : 10.00
 MAP PAGE(S): 09-00-066-A
 APPROVED BY: JAH DATE: 10-17-07
 SCALE: 1" = 200' PRIOR INSTRUMENT: OR 1248/864