
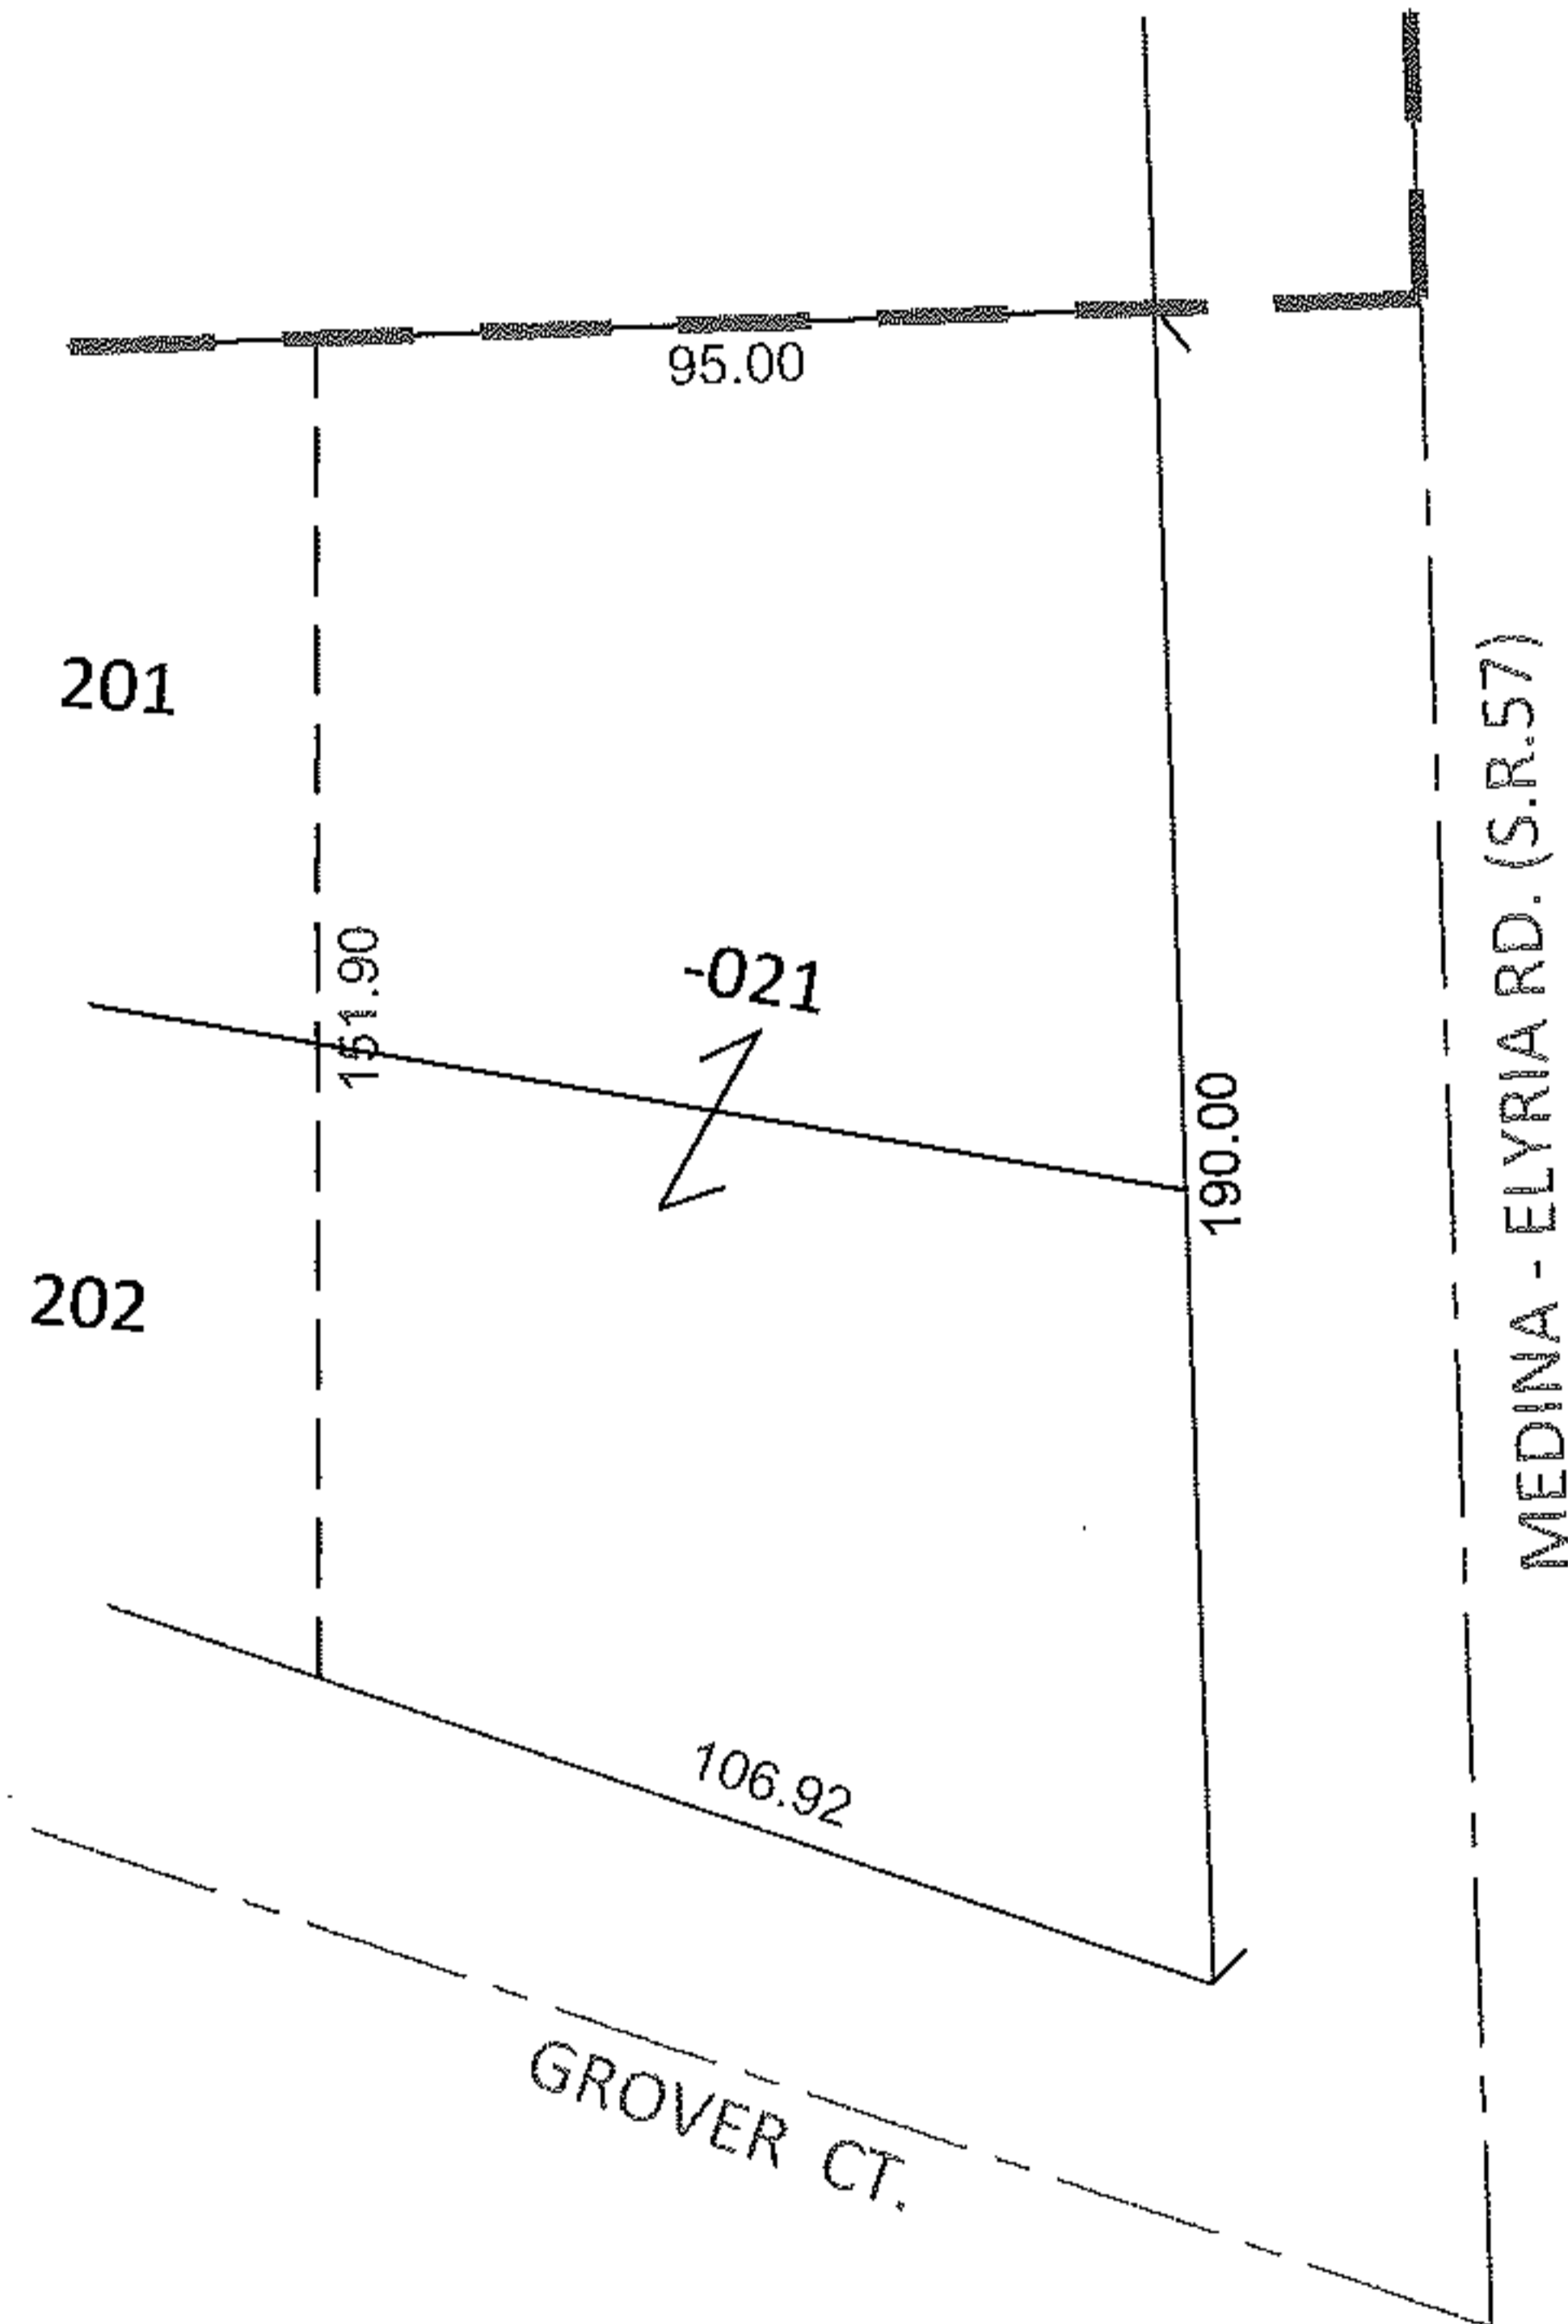


PARENT PARCEL: 10-00-015-112-021

CHILD PARCEL: _____


STARTING POINT: INTERSECTION OF WEST LINE OF S.R.57 AND NORTH LINE OF GROVER CT.

12-02475-D

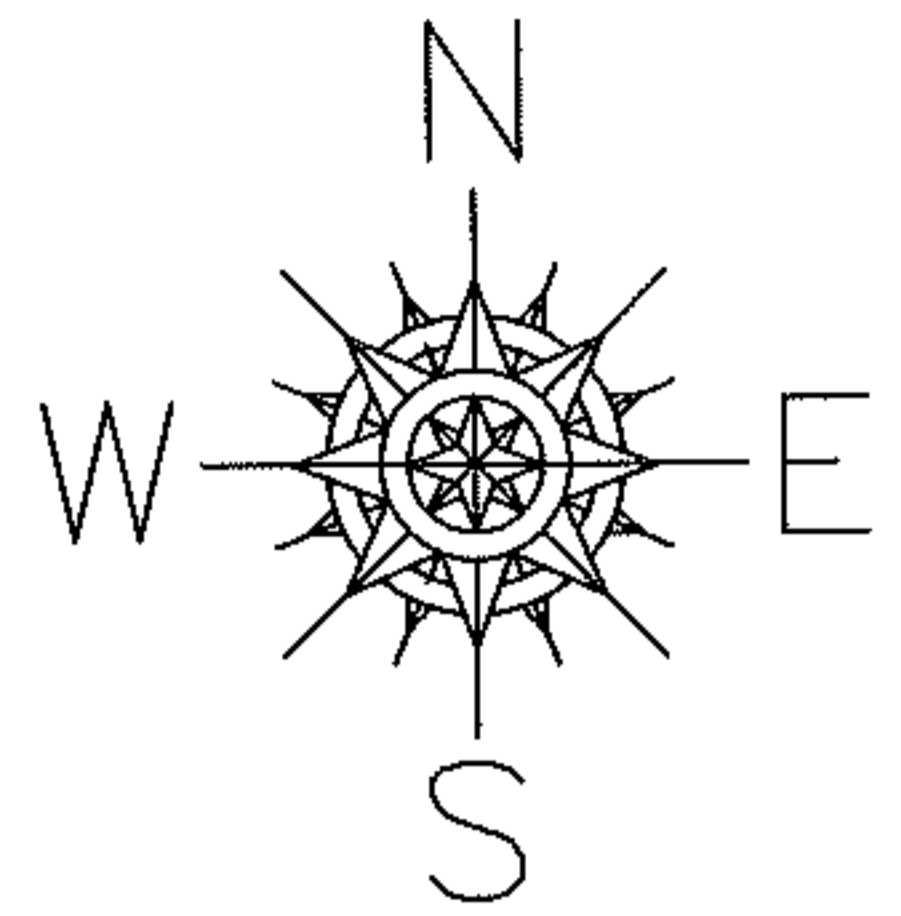

DEPTH CORRECTION

10-00-015-112-021
 106.92
 190 X ~~107~~
 PER PRIOR DEEDS

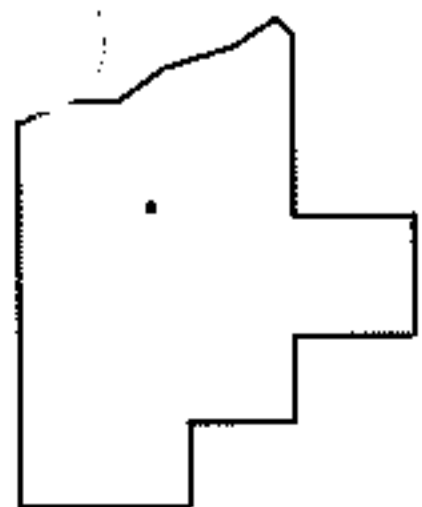

SPLITS/DEEDS PROCESSED

LORAIN COUNTY TAX MAP DEPARTMENT
 226 MIDDLE AVE. ELYRIA, OHIO

SURVEYED BY: N/A
 CLOSURE: 1:5208.99
 MAP PAGE(S): 10-00-015-D
 APPROVED BY: RRM DATE: 3-29-12
 SCALE: 1"= 50' PRIOR INST.: DV 1207/443