


PARENT PARCEL: 21-05-008-000-001


CHILD PARCEL: 21-05-008-000-029, -030

STARTING POINT: CENTERLINE OF ASHLAND OBERLIN RD & O.L. 8

07-02476

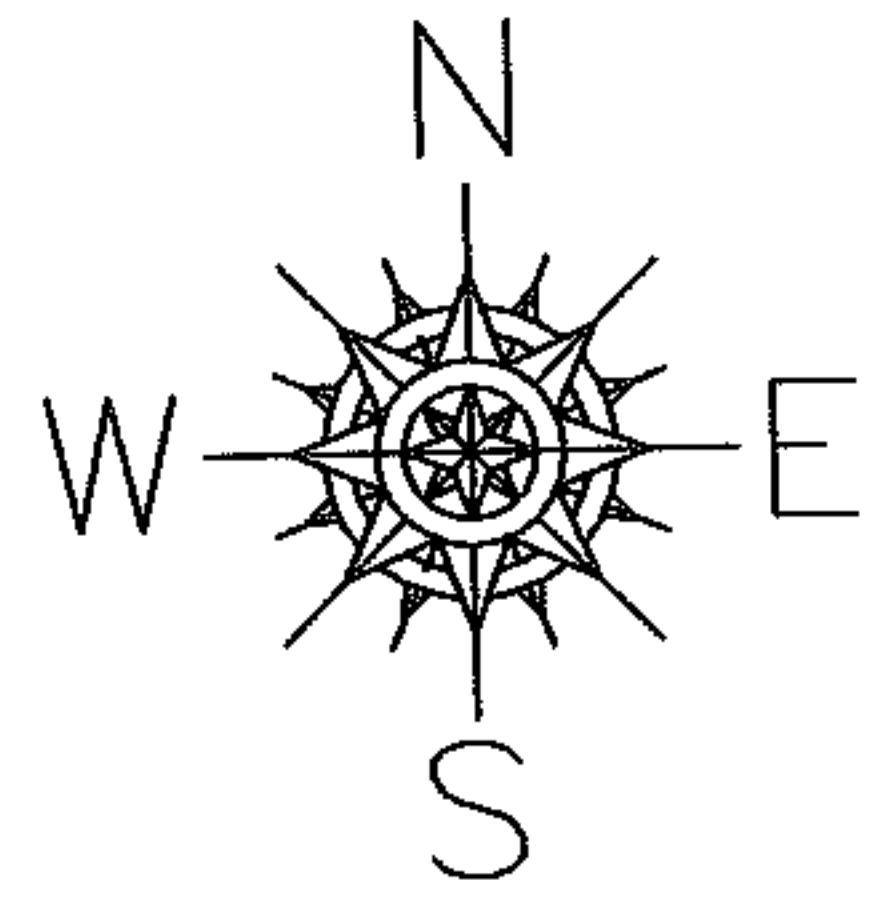

~~001~~
~~96.00 A.~~
-030
92.82 A.

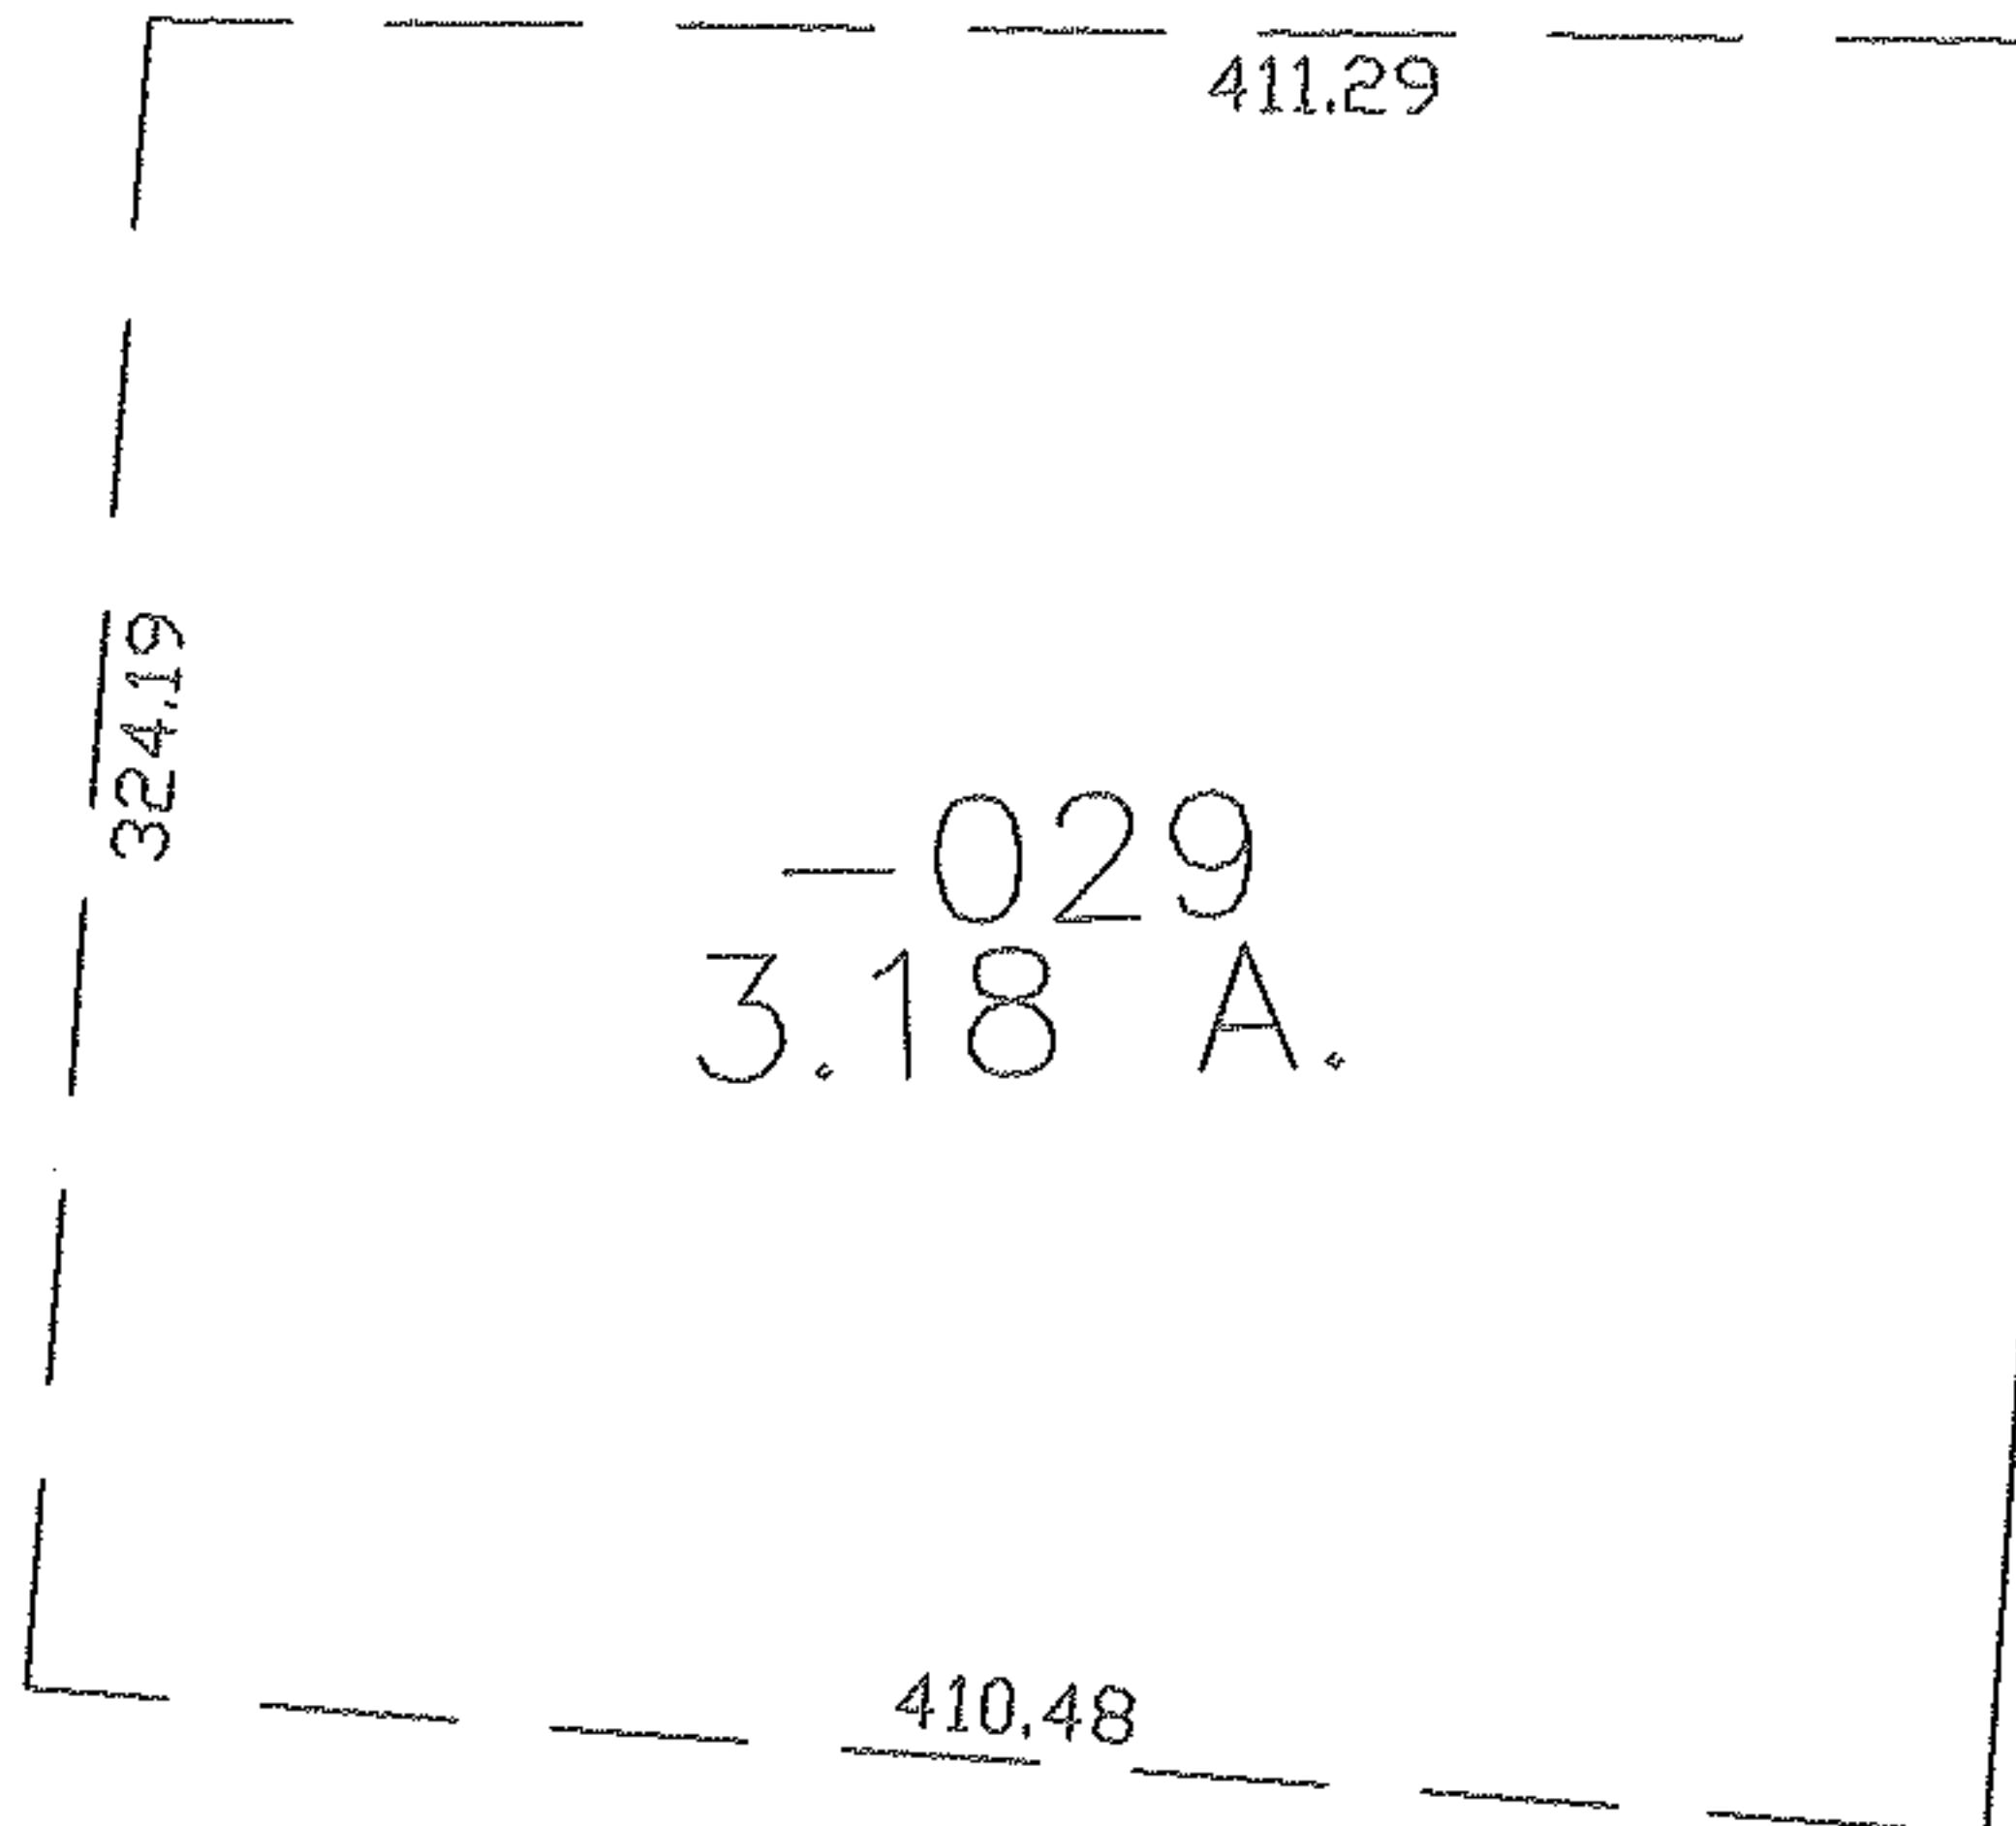

ASHLAND OBERLIN RD

SPLITS/DEEDS PROCESSED

LORAIN COUNTY TAX MAP DEPARTMENT
226 MIDDLE AVE. ELYRIA, OHIO

SURVEYED BY: RICHARD CARLSON

CLOSURE: 0.00 : 10.000

MAP PAGE(S): 21-05-008-B

APPROVED BY: JAH DATE: 10-24-07

SCALE: 1" = 100 PRIOR INSTRUMENT: DV 1272/99

