


PARENT PARCEL: 04-00-018-130-018 &-016

CHILD PARCEL: 04-00-018-130-043

STARTING POINT: CENTERLINE OF LAKE RD & MAPLE CLIFF DR.

07-02477

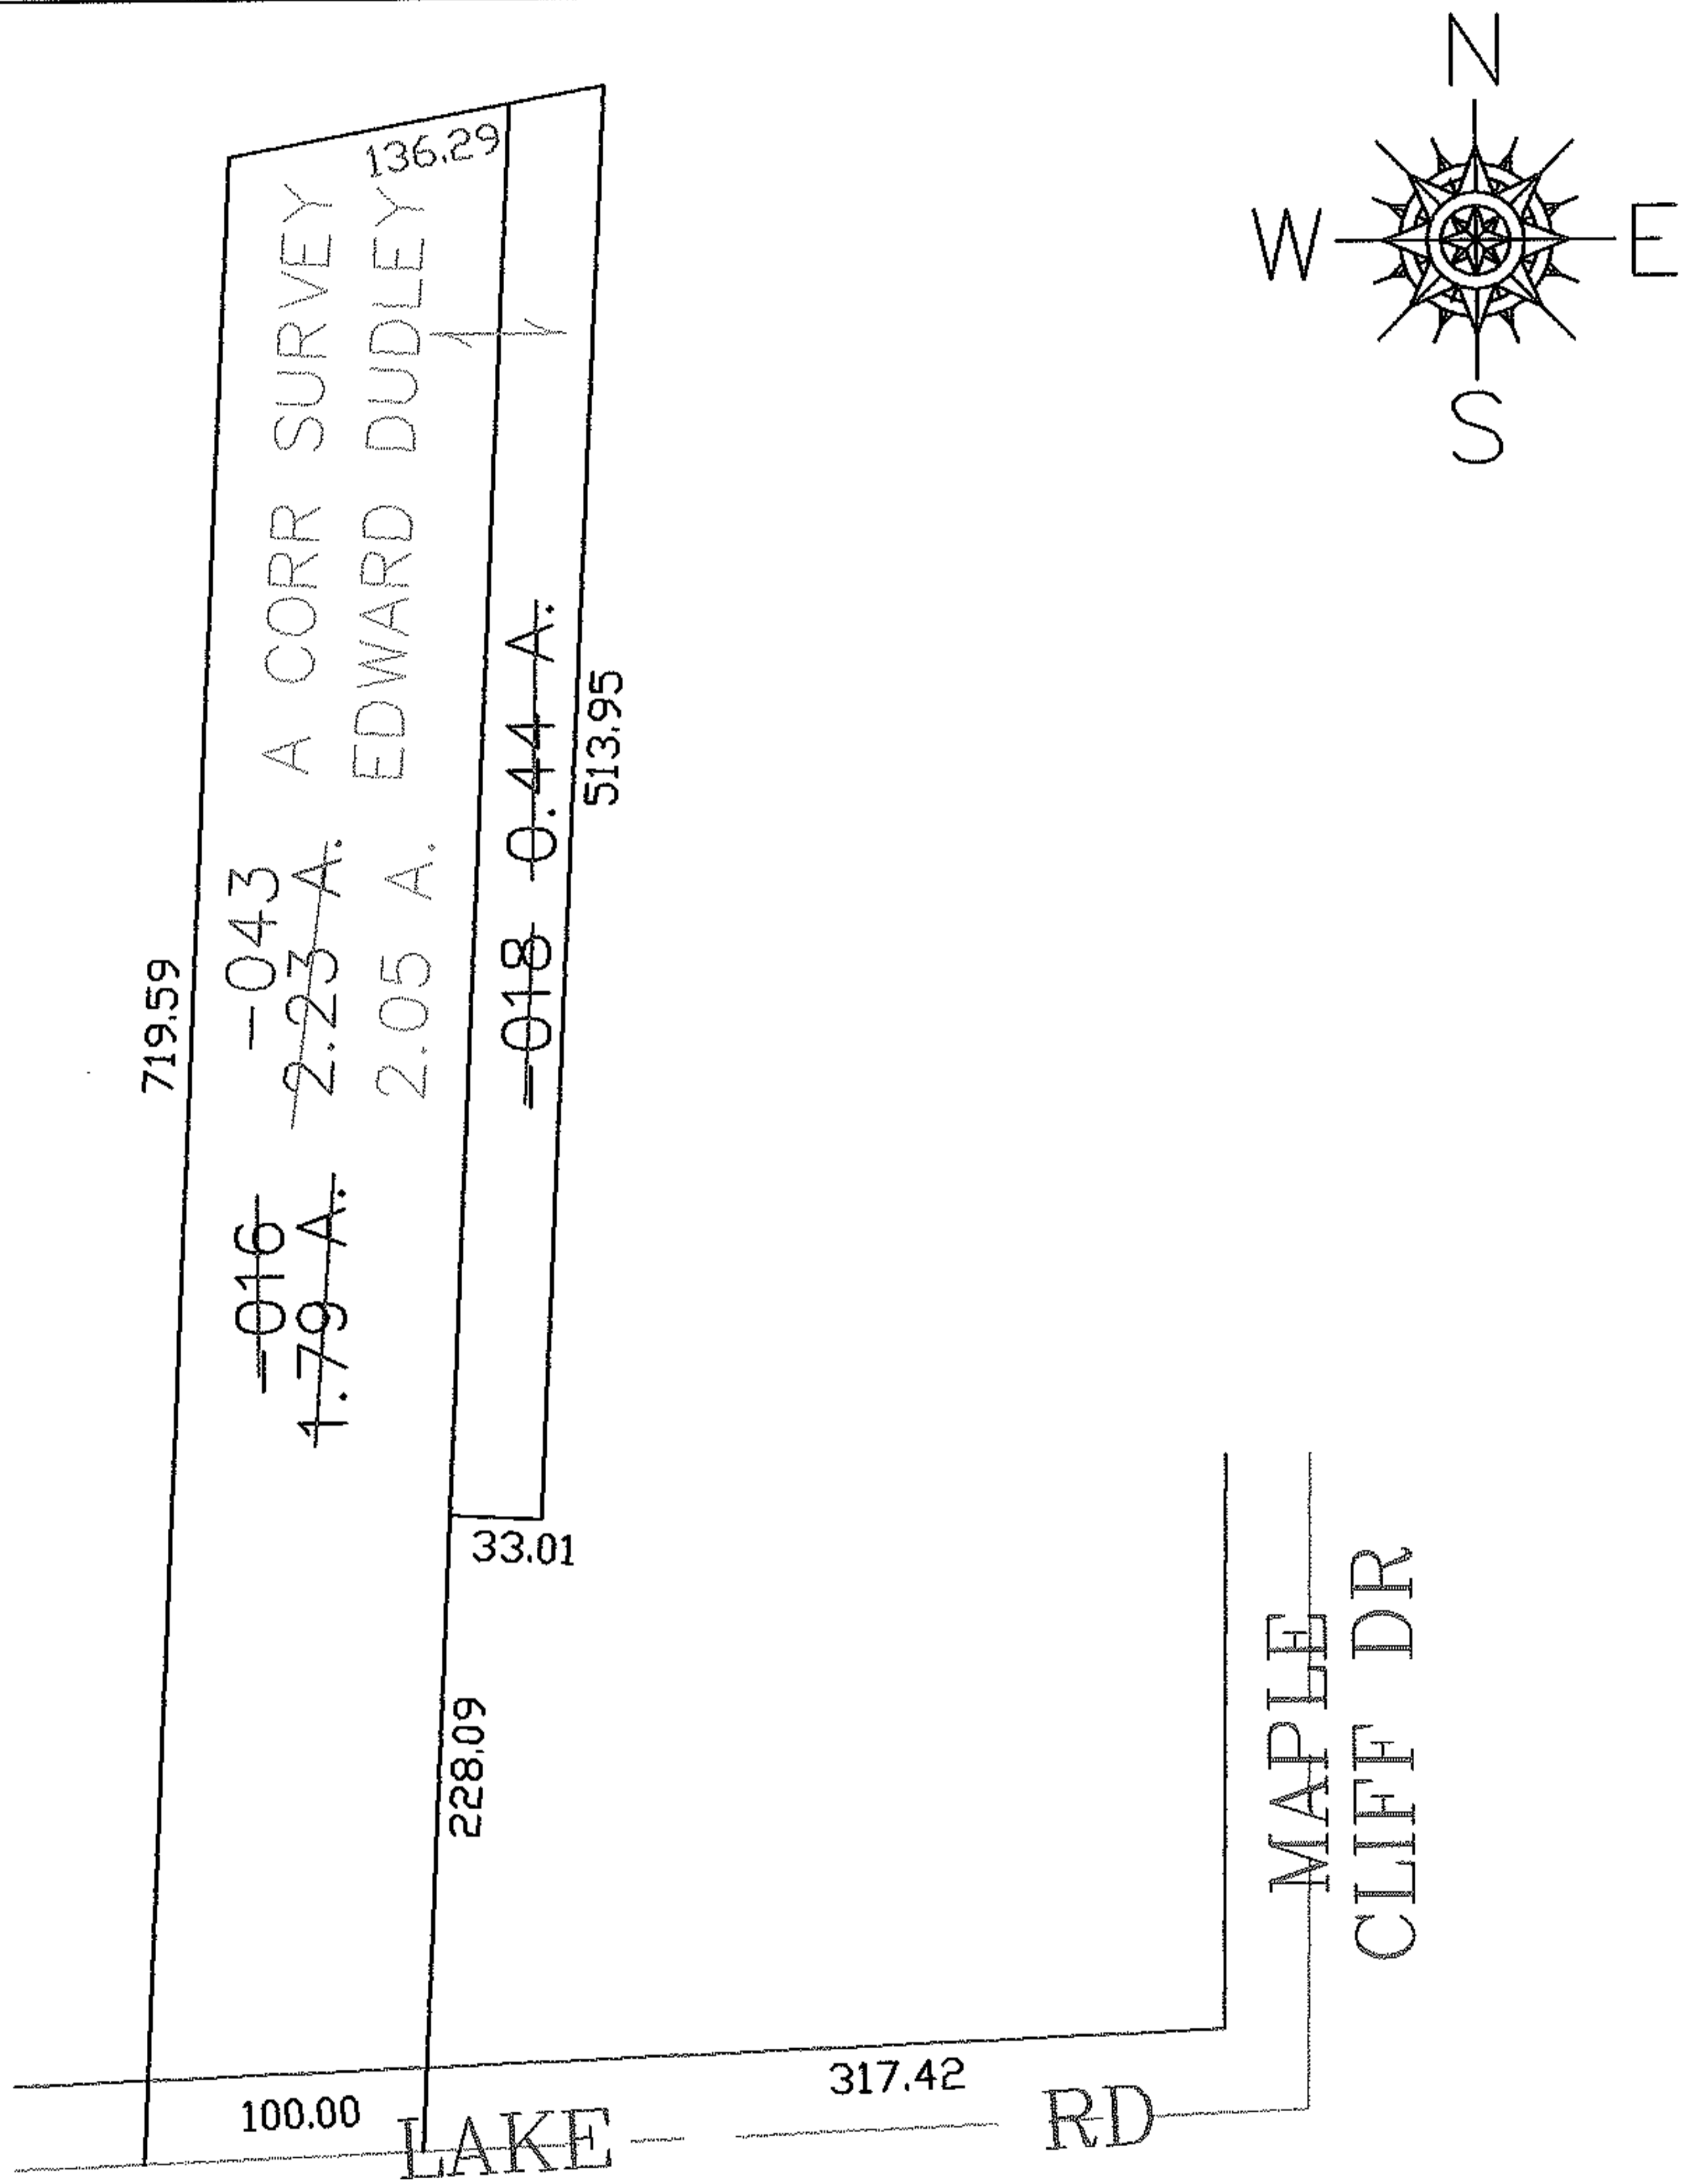

SPLITS/DEEDS PROCESSED

LORAIN COUNTY TAX MAP DEPARTMENT
226 MIDDLE AVE. ELYRIA, OHIO

SURVEYED BY: EDWARD B DUDLEY

CLOSURE: 0.00 : 10.000

MAP PAGE(S): 04-00-018-C

APPROVED BY: JAH DATE: 10-24-07

SCALE: 1" = 100' PRIOR INSTRUMENT: 20050109836