



RASTER

PARENT PARCEL: 05-00-099-000-129

CHILD PARCEL: 05-00-099-000-203, -204

STARTING POINT: CENTERLINE OF QUARRY RD & COOPER FOSTER PARK RD

07-02485

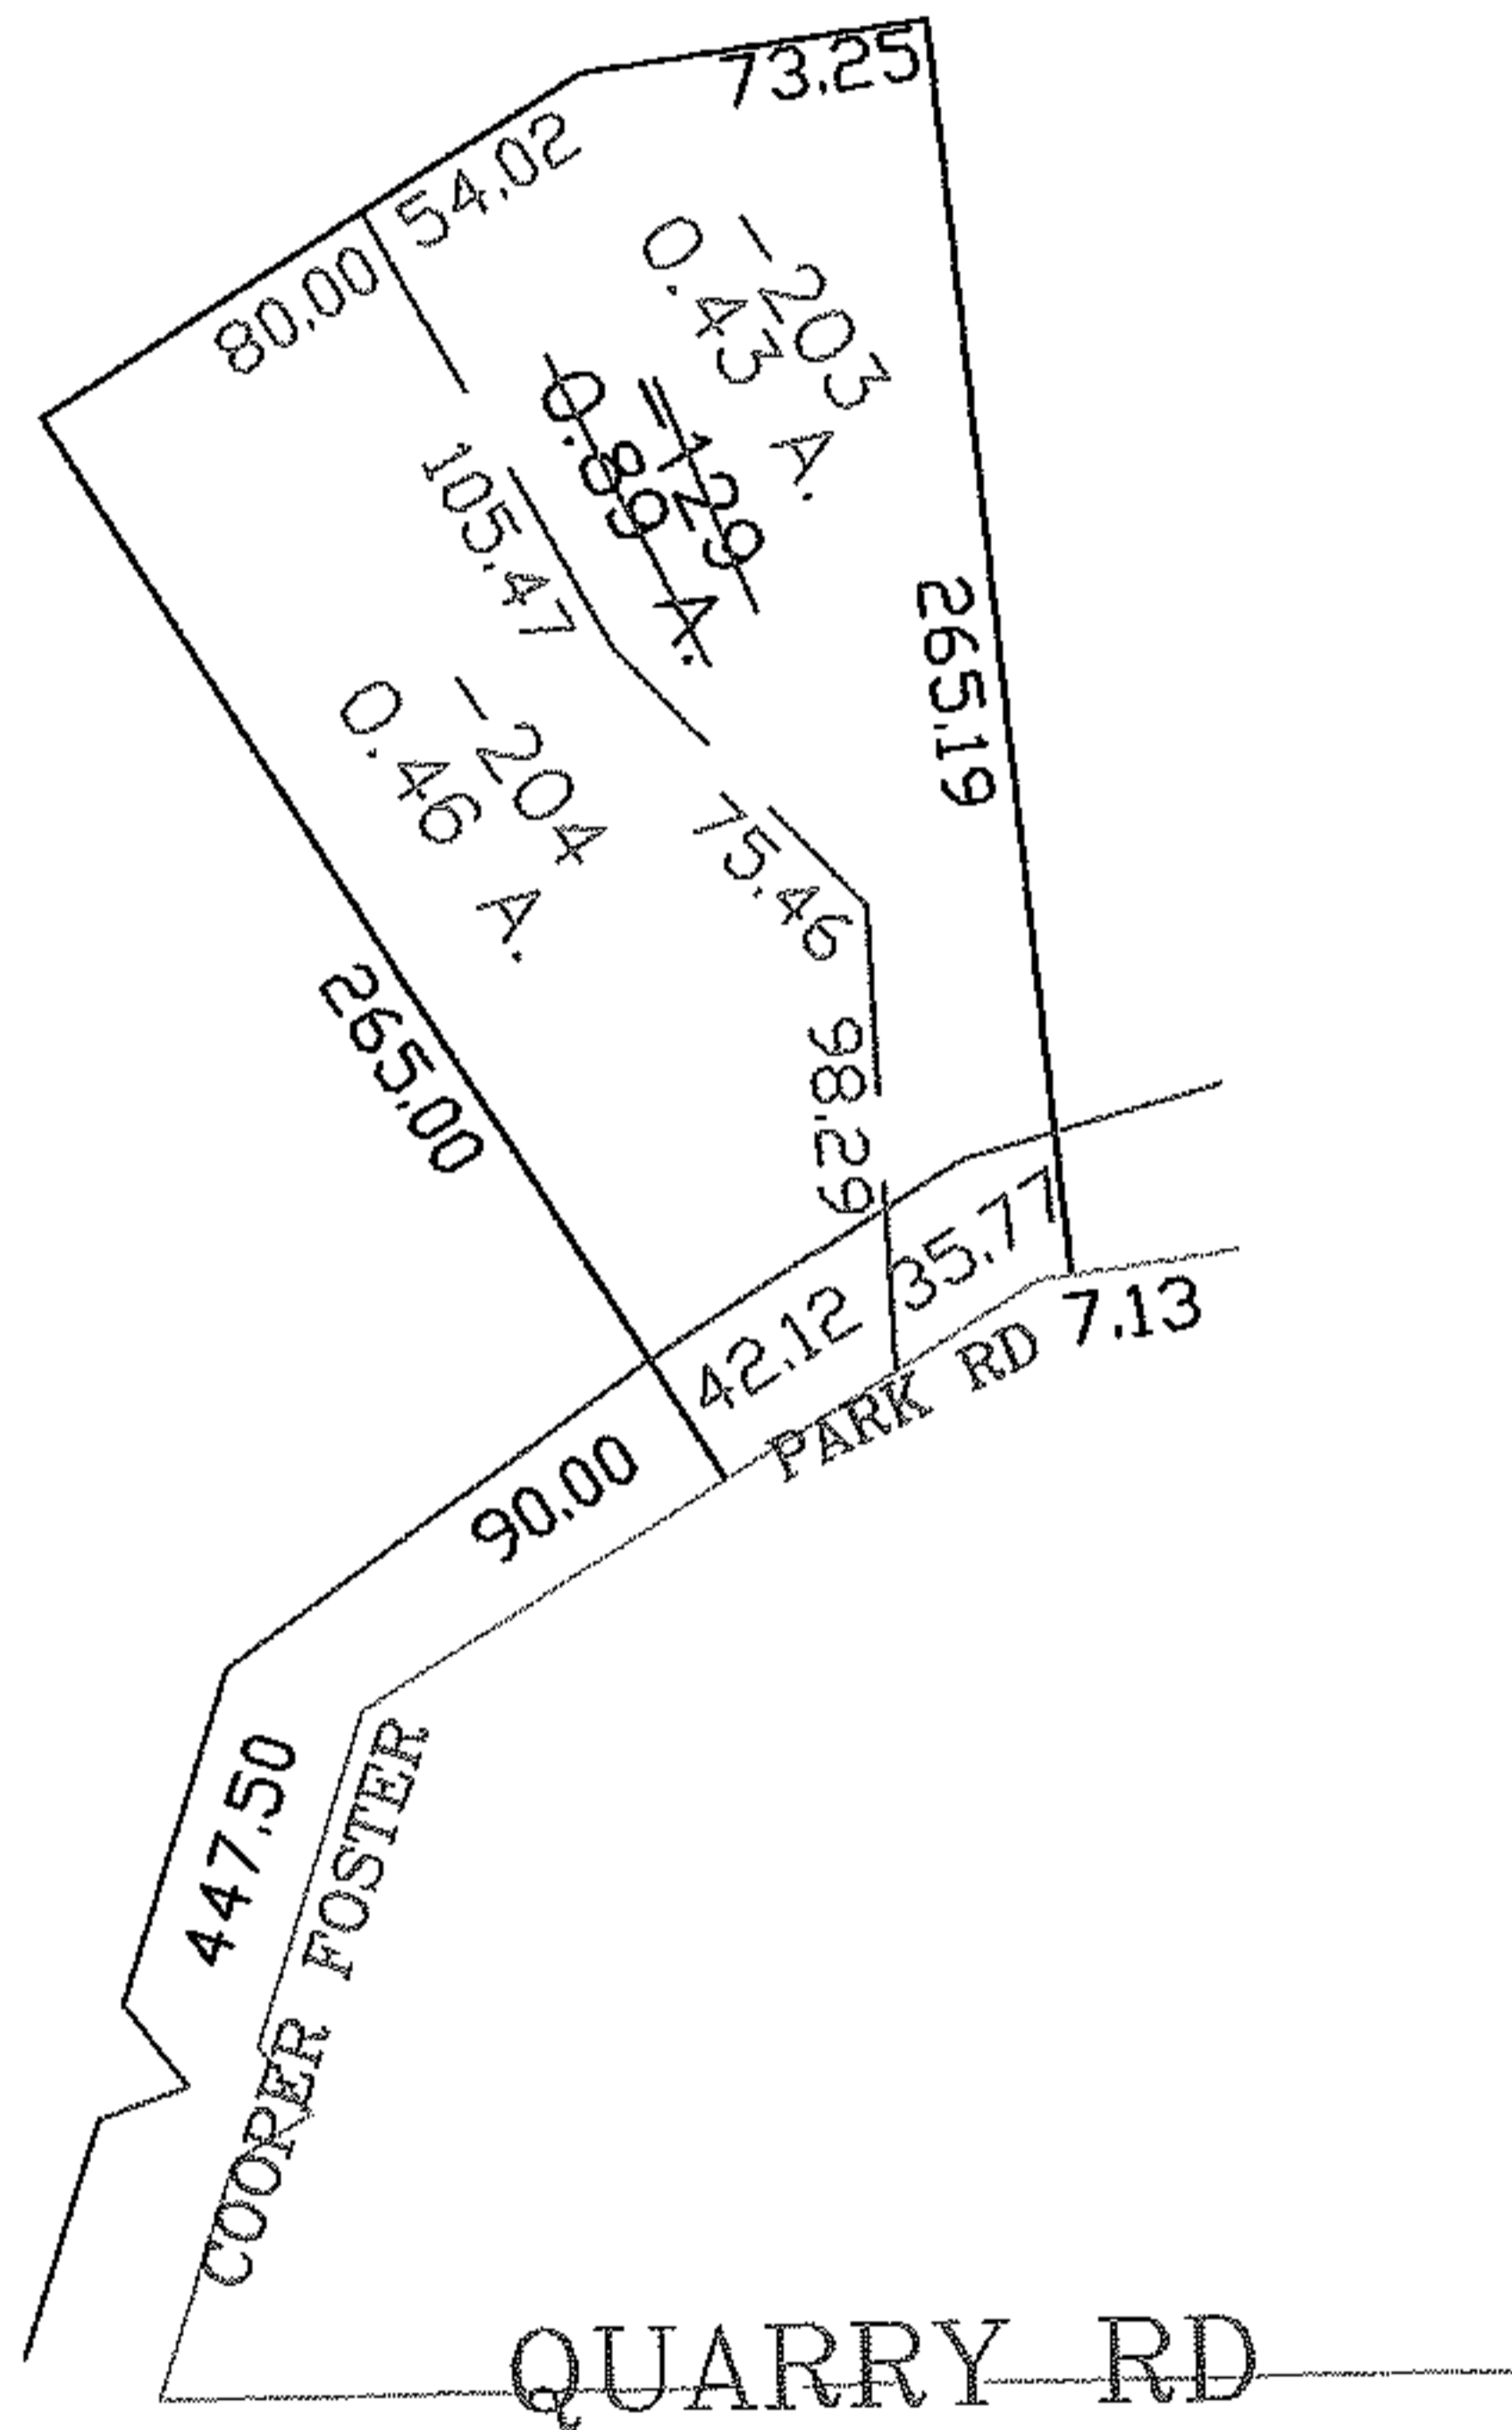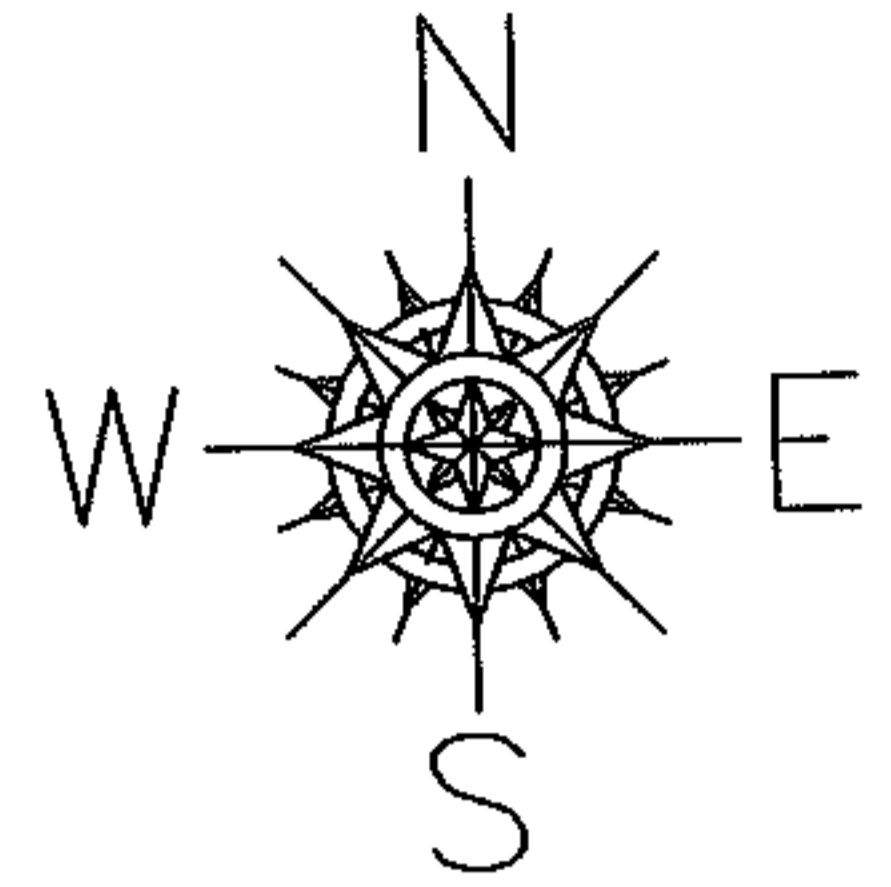

SPLITS/DEEDS PROCESSED

LORAIN COUNTY TAX MAP DEPARTMENT
226 MIDDLE AVE. ELYRIA, OHIO

SURVEYED BY: EDWARD B. DUDLEY

CLOSURE: 0.00 : 10.000

MAP PAGE(S): 05-00-099-C

APPROVED BY: JAH DATE: 11-2-07

SCALE: 1" = 100 PRIOR INSTRUMENT: 20030884674