



RASTER

PARENT PARCEL: 05-00-021-103-046, -047

CHILD PARCEL: 05-00-021-103-048 THRU -050

STARTING POINT: CENTERLINE OF COOPER FOSTER PARK RD & KOLBE RD

07-02487

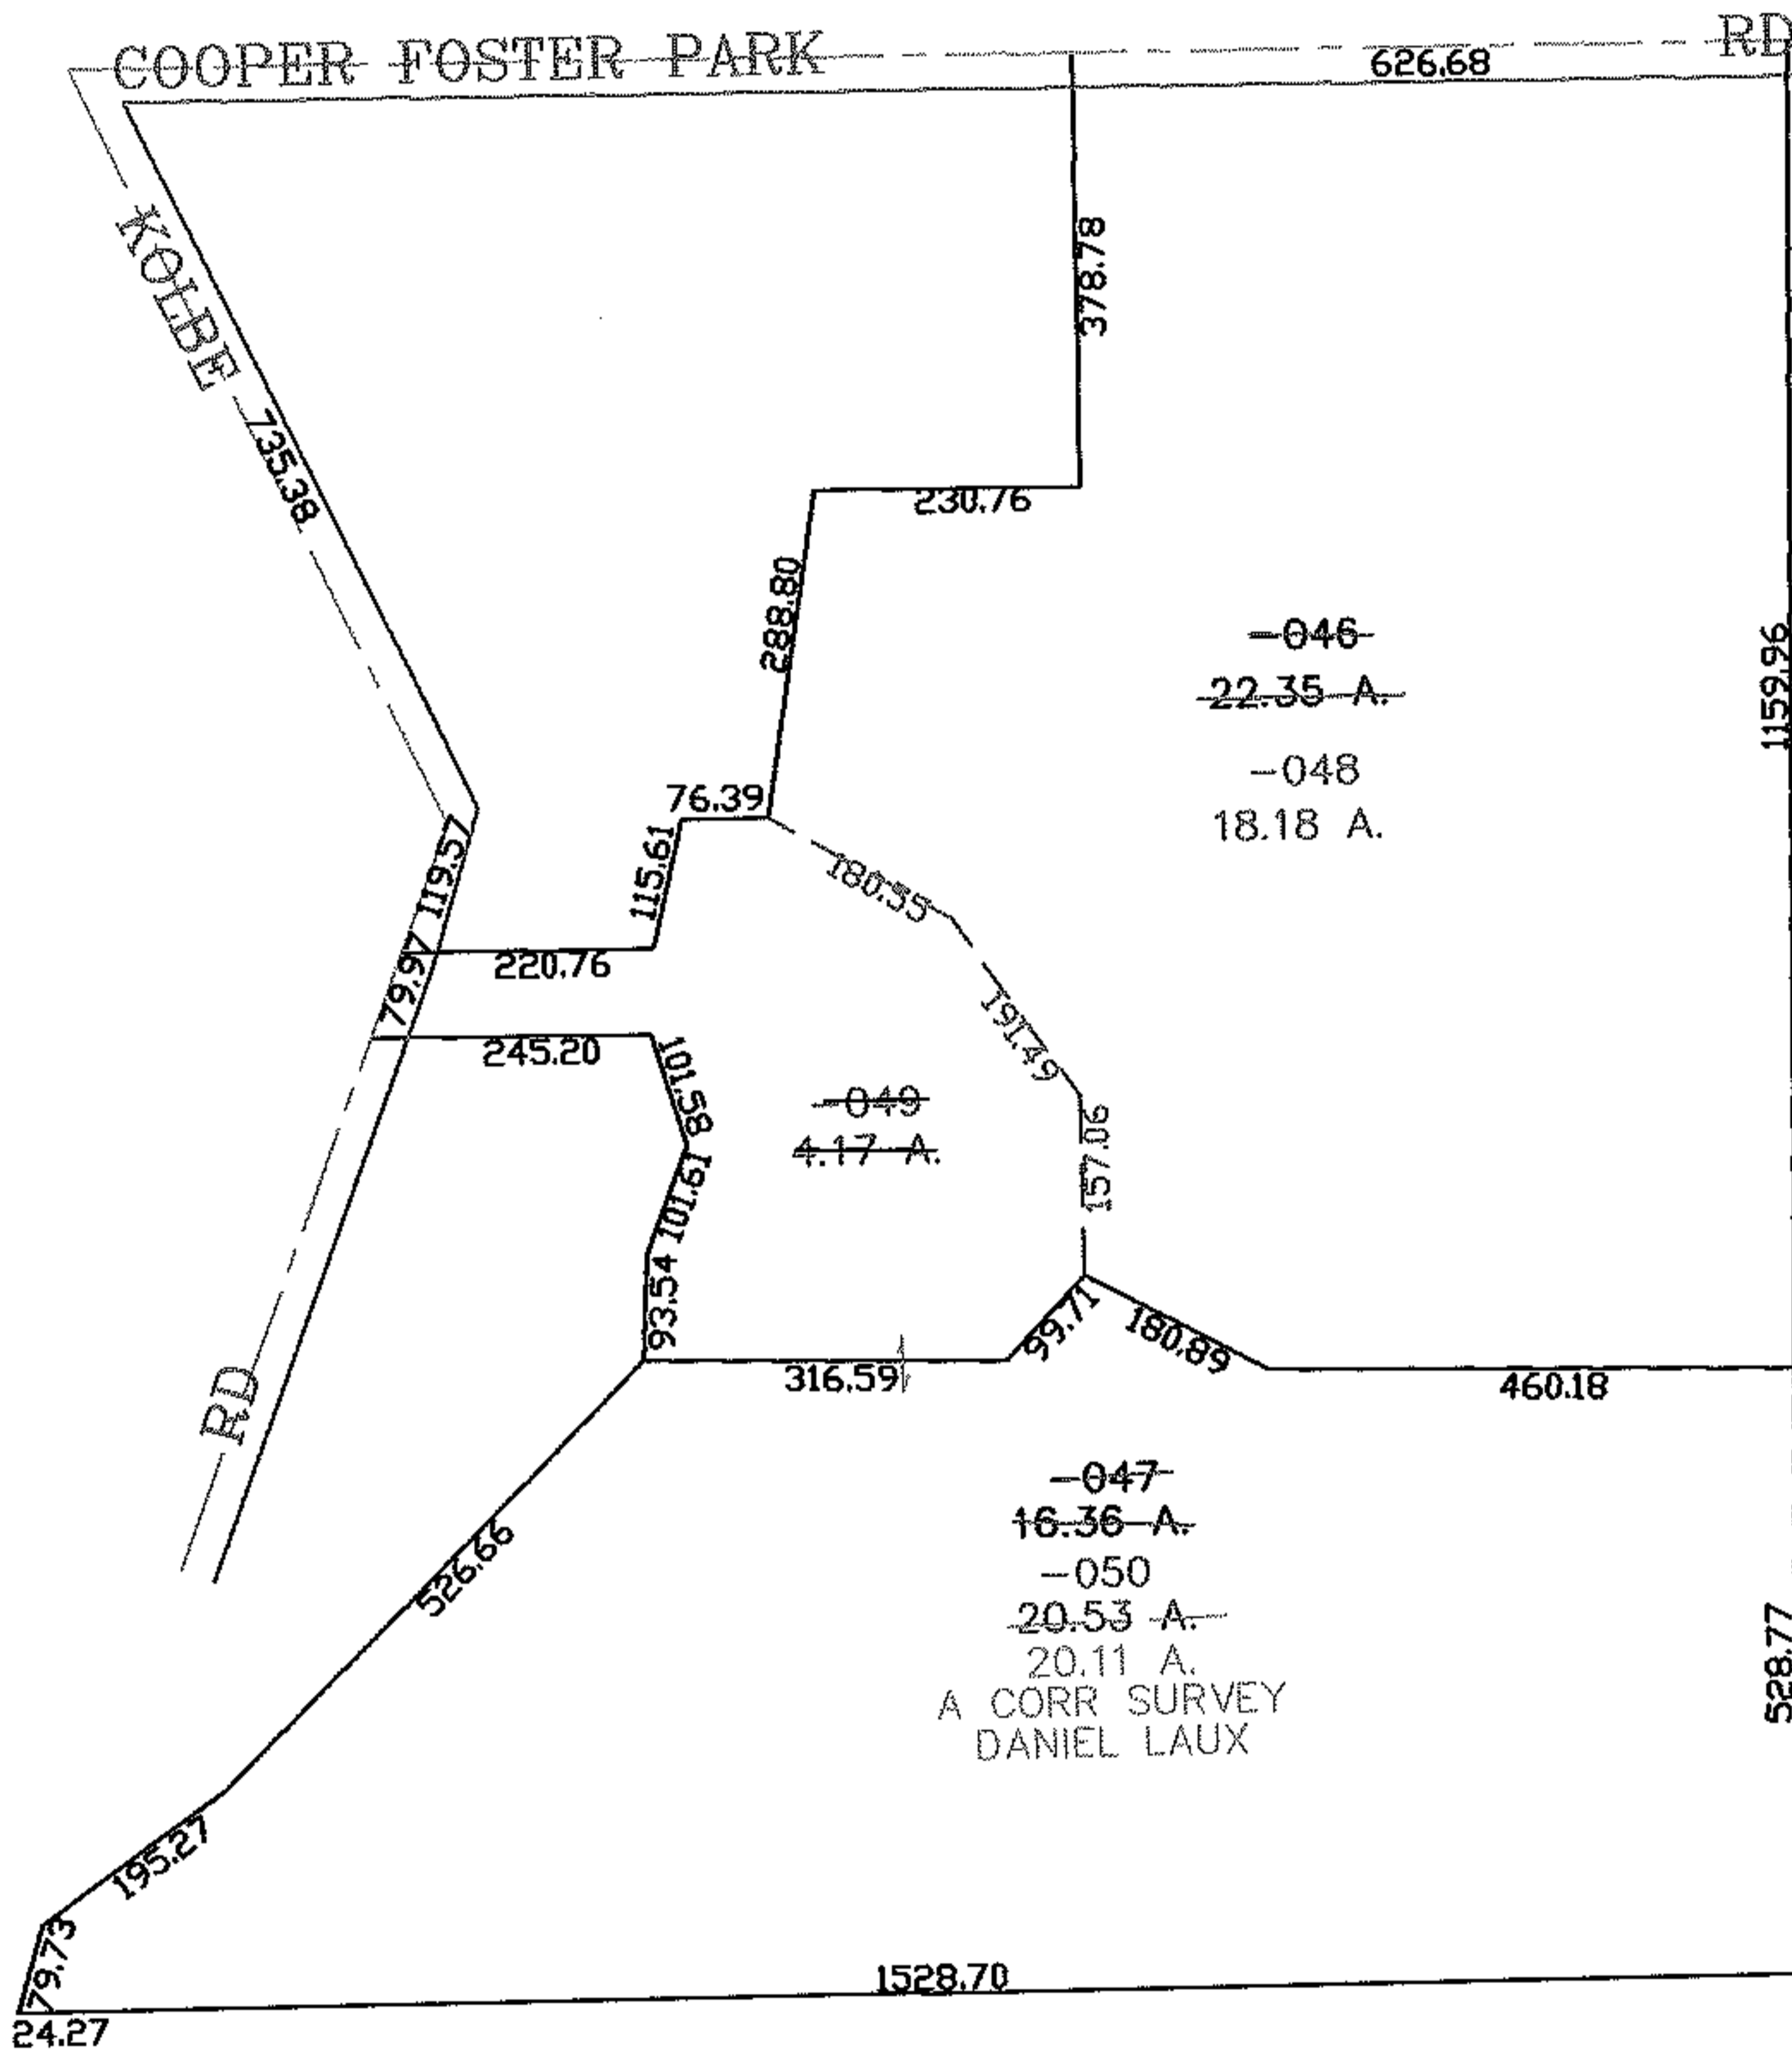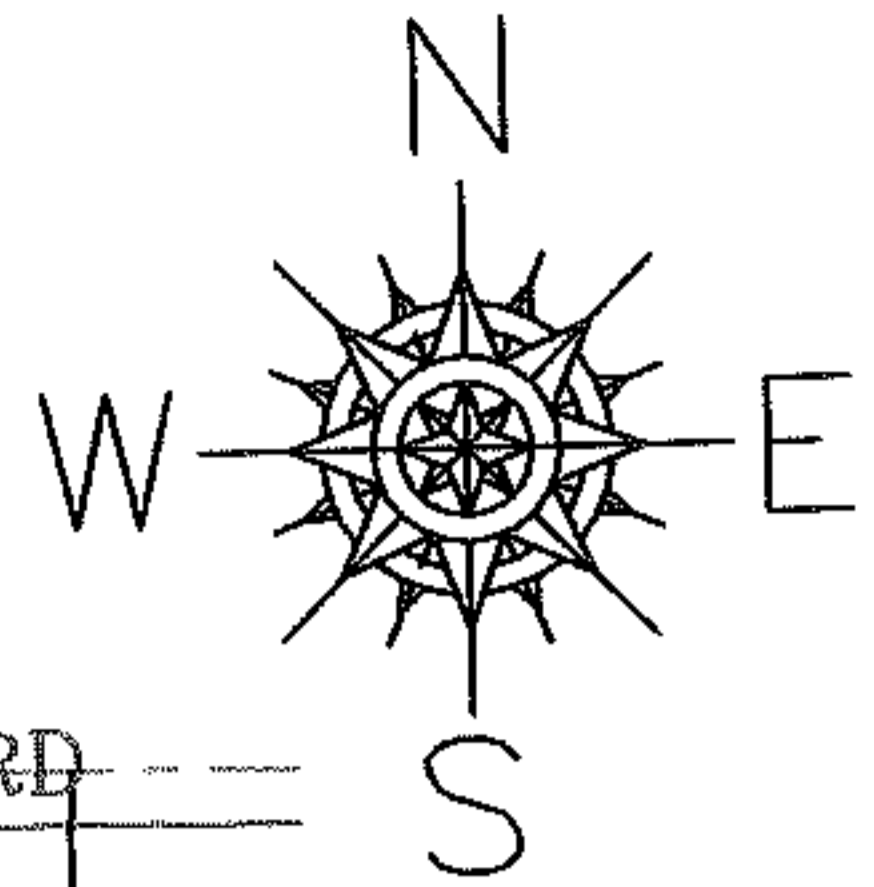

**SPLITS/DEEDS PROCESSED**

LORAIN COUNTY TAX MAP DEPARTMENT  
226 MIDDLE AVE. ELYRIA, OHIO

SURVEYED BY: DANIEL LAUX

CLOSURE: 0.00 : 10.000

MAP PAGE(S): 05-00-021-B

APPROVED BY: JAH DATE: 11-7-07

SCALE: 1" = 100' PRIOR INSTRUMENT: 20070193869